

UNITED STATES
DEPARTMENT OF THE INTERIOR
BUREAU OF LAND MANAGEMENT

SECTION

27


Oregon State Water Filings

SE $\frac{1}{4}$ SE $\frac{1}{4}$

TOWNSHIP 22S, RANGE 37E, W. M.

"CERTIFICATE NO.

74870
~~68920~~

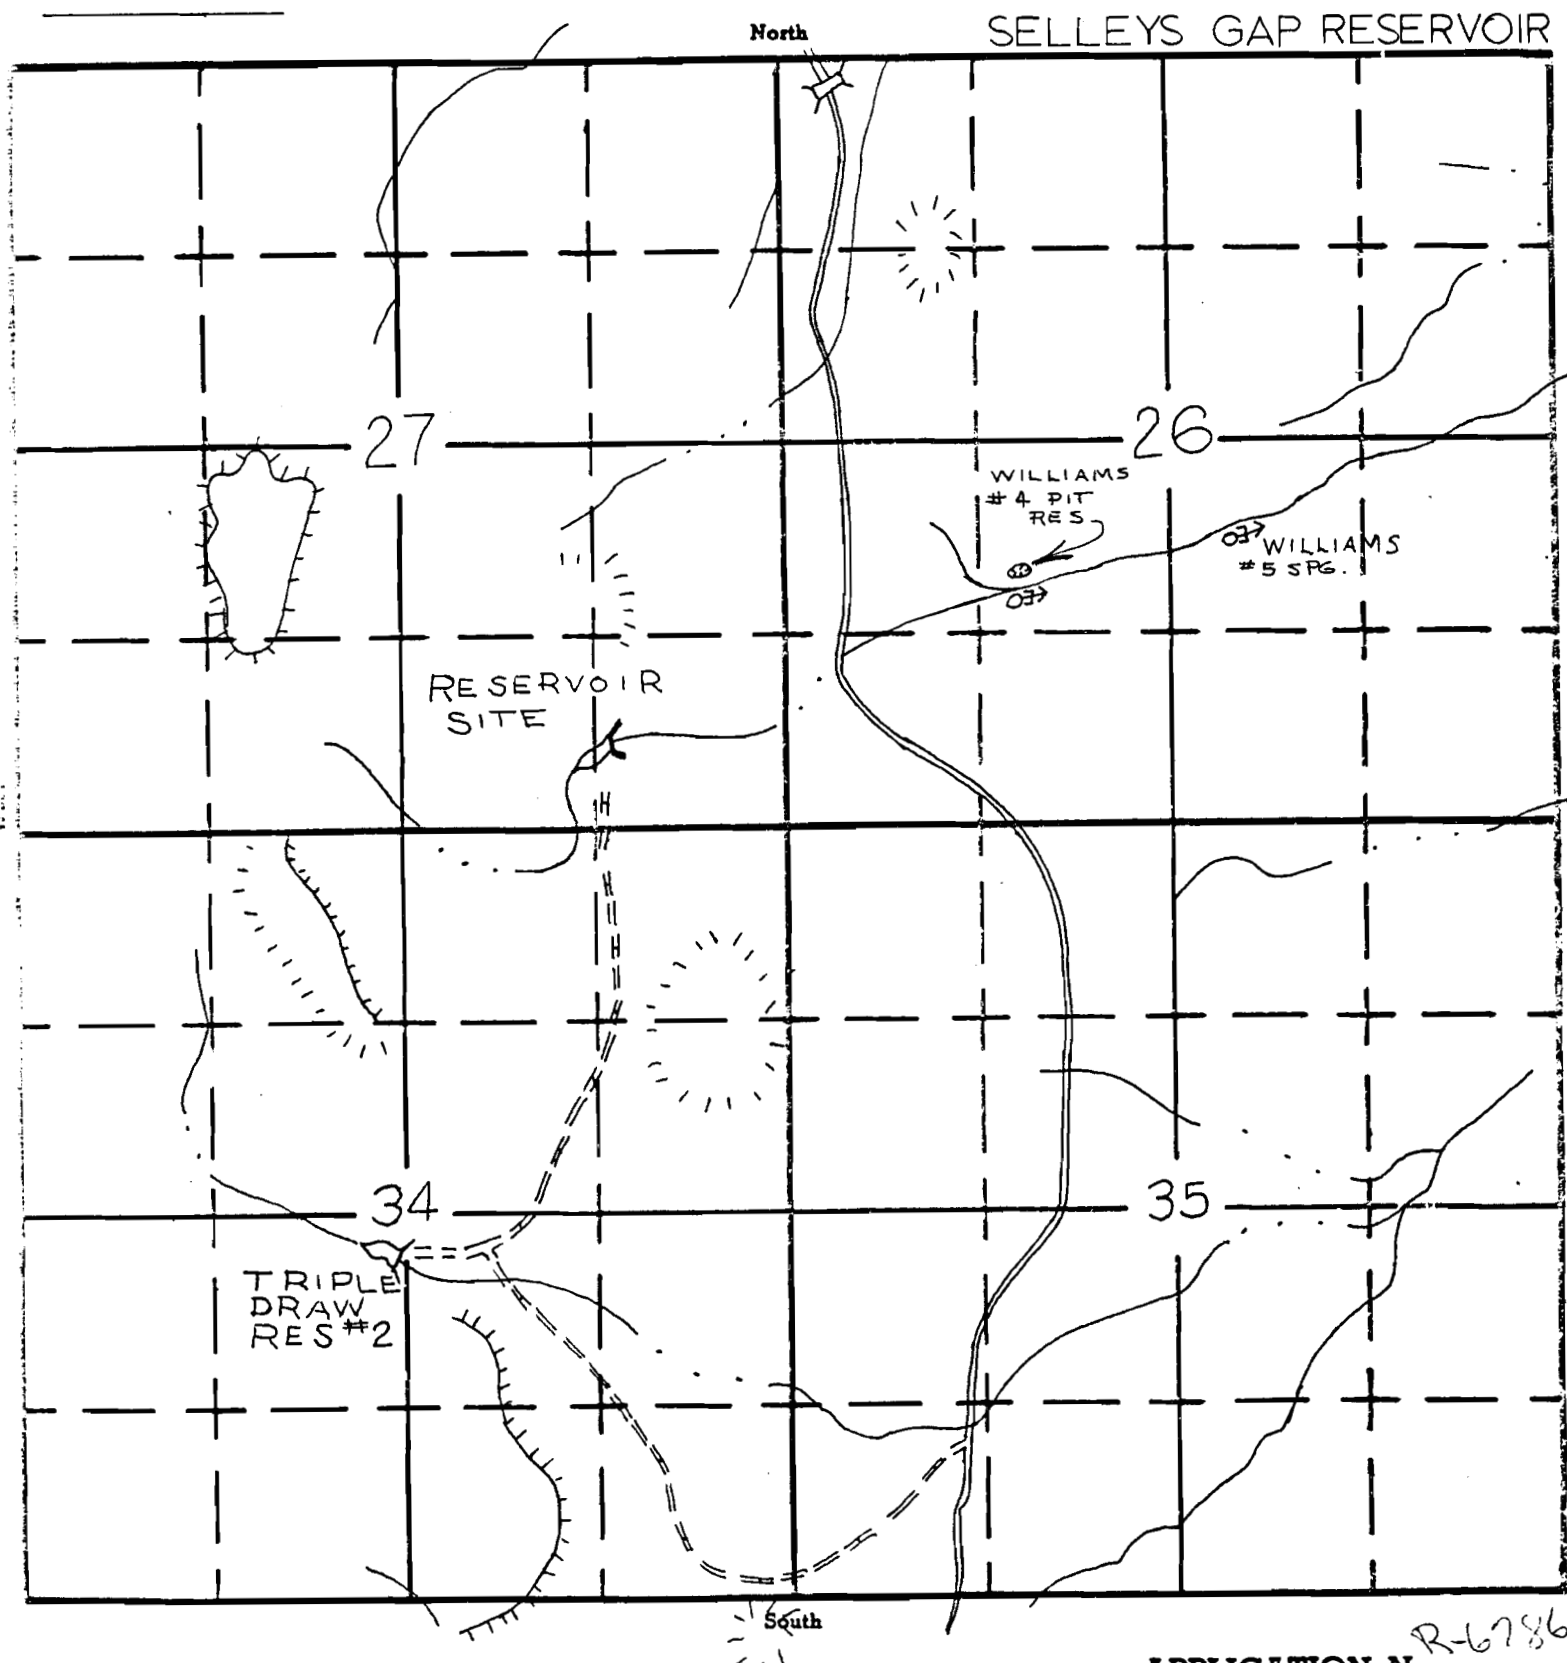

PERMIT No.