


T. 5 S., R. 6 S., W.M.

Location: 17701 SW Gopher Valley Road, Sheridan, 97378
 NE 1/4 of the SW 1/4 Section 13,
 T. 5 S., R. 6 W., WM, Yamhill County, Oregon
 Phone: 843 - 3162


Scale: 1" = 400'

LEGEND

.....
 water line

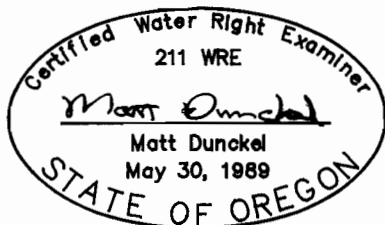

By: Matt Dunckel & Assoc.
 19010 Baker Creek Road
 McMinnville, OR 97128
 Phone: 472-7904

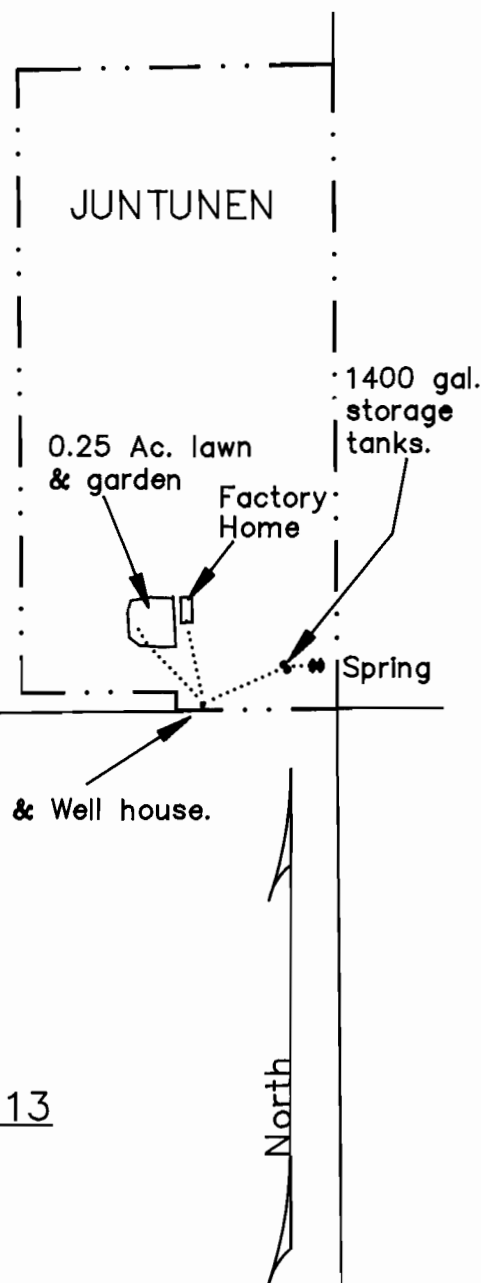

I certify that the information I have provided
 in this Final Proof is an accurate
 representation of the permitted water use and is
 true and correct to the best of my knowledge.
 This map is to be used for the purpose of identifying
 the location of water right only and is not
 intended to provide legal dimensions or
 locations of property ownership lines.

Locations from SW corner of Section 13

Lawn & Garden	N: 1513 feet	E: 2206 feet
Pump & Well	N: 1341 feet	E: 2312 feet
Storage Tanks	N: 1420 feet	E: 2487 feet
Spring	N: 1422 feet	E: 2551 feet
House	N: 1539 feet	E: 2279 feet

14 13
 23 24

FINAL PROOF SURVEY UNDER

Application No. 71901 Permit No. 51454

IN NAME OF

KIM M. JUNTUNEN / ERLAND JUNTUNEN ATTORNEY IN FACT

Surveyed August 21, 1993,