


T.40S. R.11E. W.M.

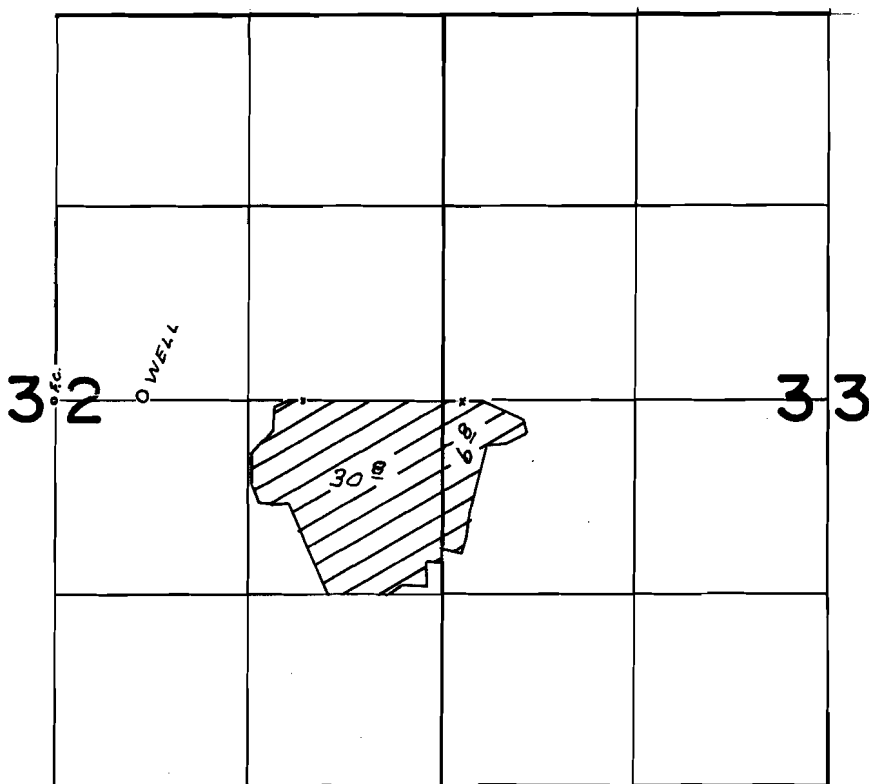

WELL LOC. 40' N. & 600' E. FROM CENTER SEC. 32.

FINAL PROOF SURVEY UNDER

Application No. G-5618 Permit No. G-5457
IN NAME OF

CHARLES V. SHUCK

Surveyed APR. 26 1976, by L.H. NUNN