

UNITED STATES
DEPARTMENT OF THE INTERIOR
BUREAU OF LAND MANAGEMENT

SECTION


NK 4 SW 1/4

Oregon State Water Filings

26

TOWNSHIP 37S, RANGE 35E, W. M.

North

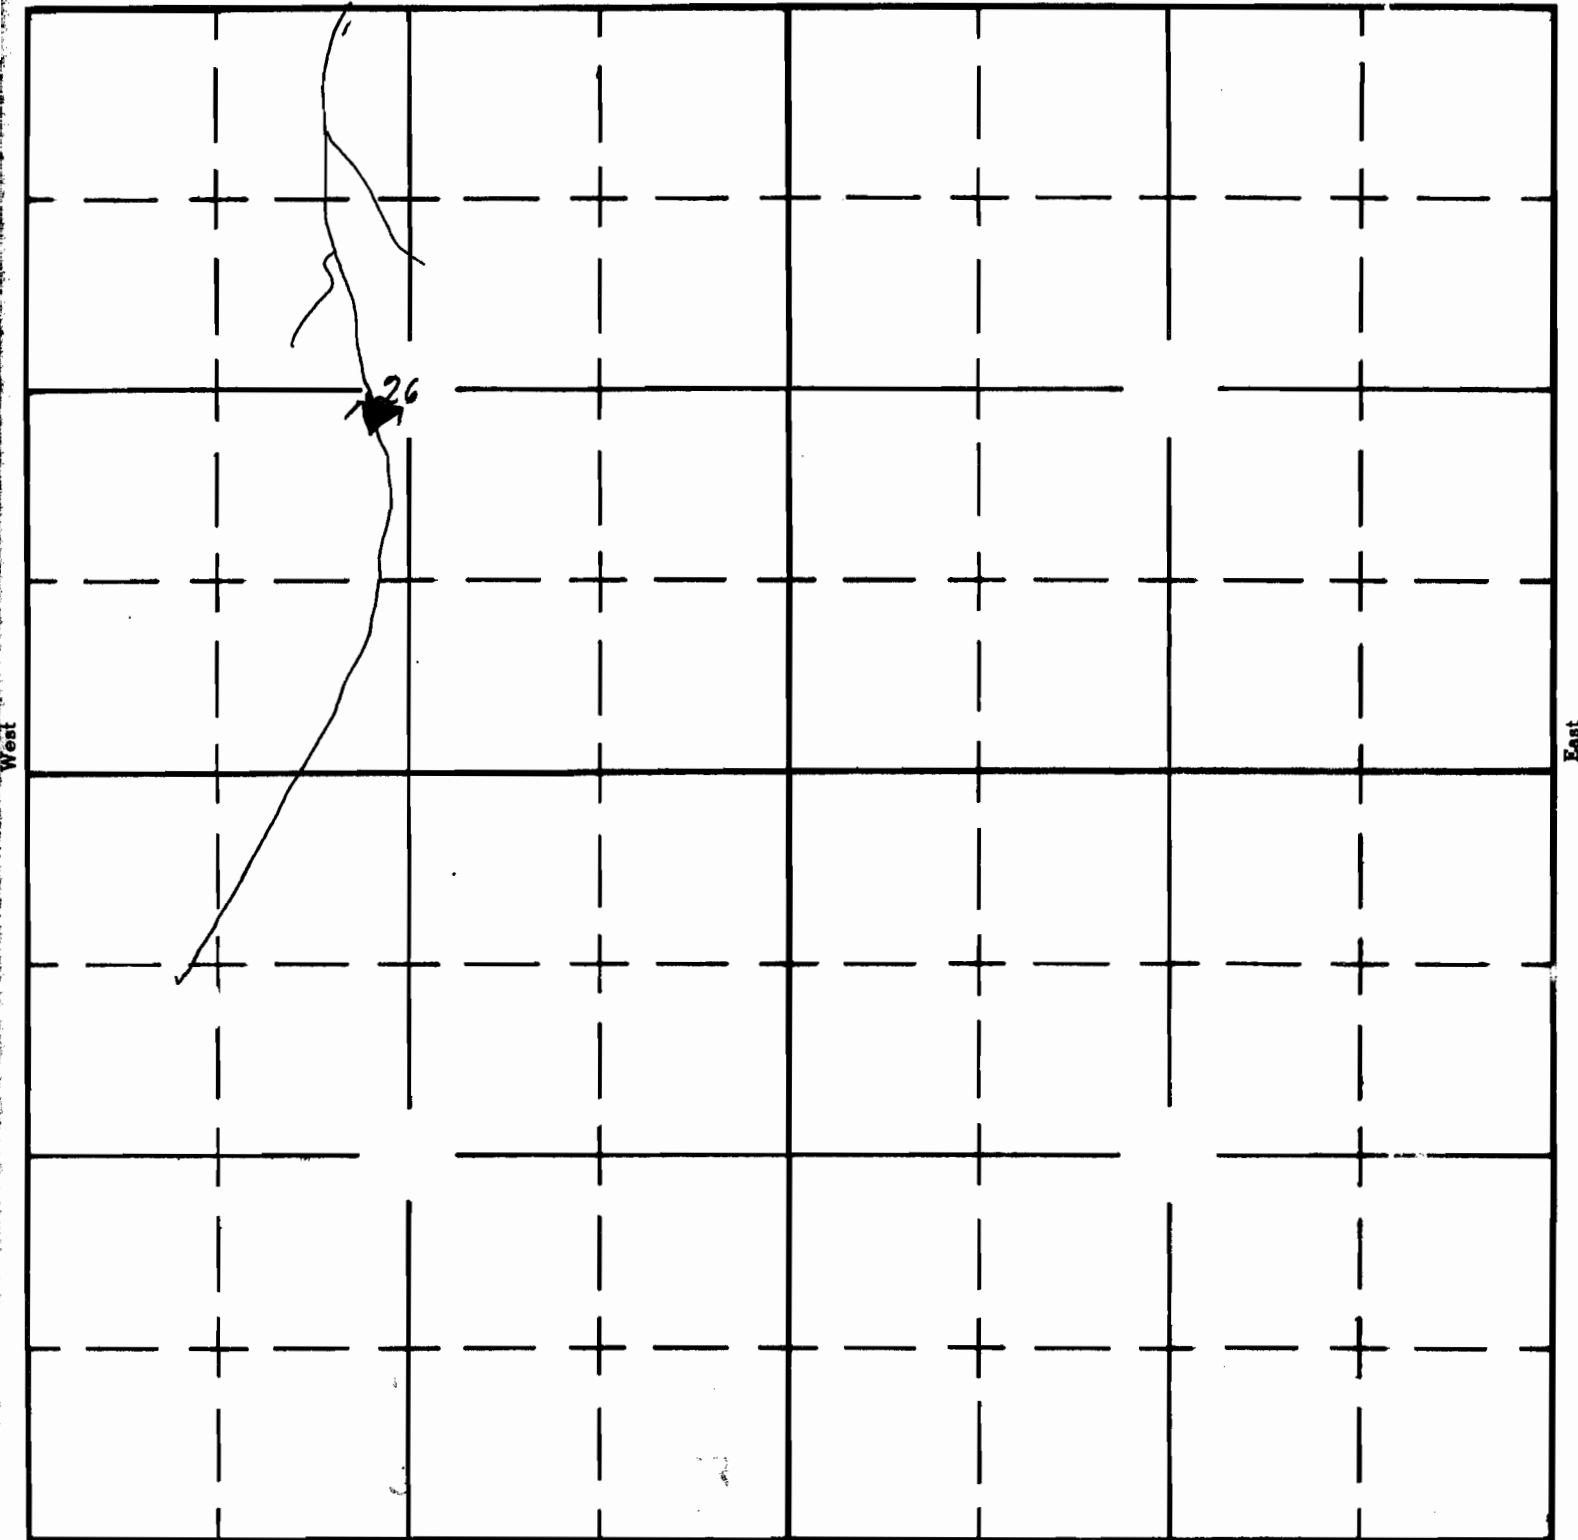

South

APPLICATION No. R-35417
PERMIT No. R-3305