

Form A1-187
March 1961

UNITED STATES
DEPARTMENT OF THE INTERIOR
BUREAU OF LAND MANAGEMENT


SECTION

Oregon State Water Filings

39

TOWNSHIP 30S, RANGE 42E, W. M.

Little Janyer Reservoir North

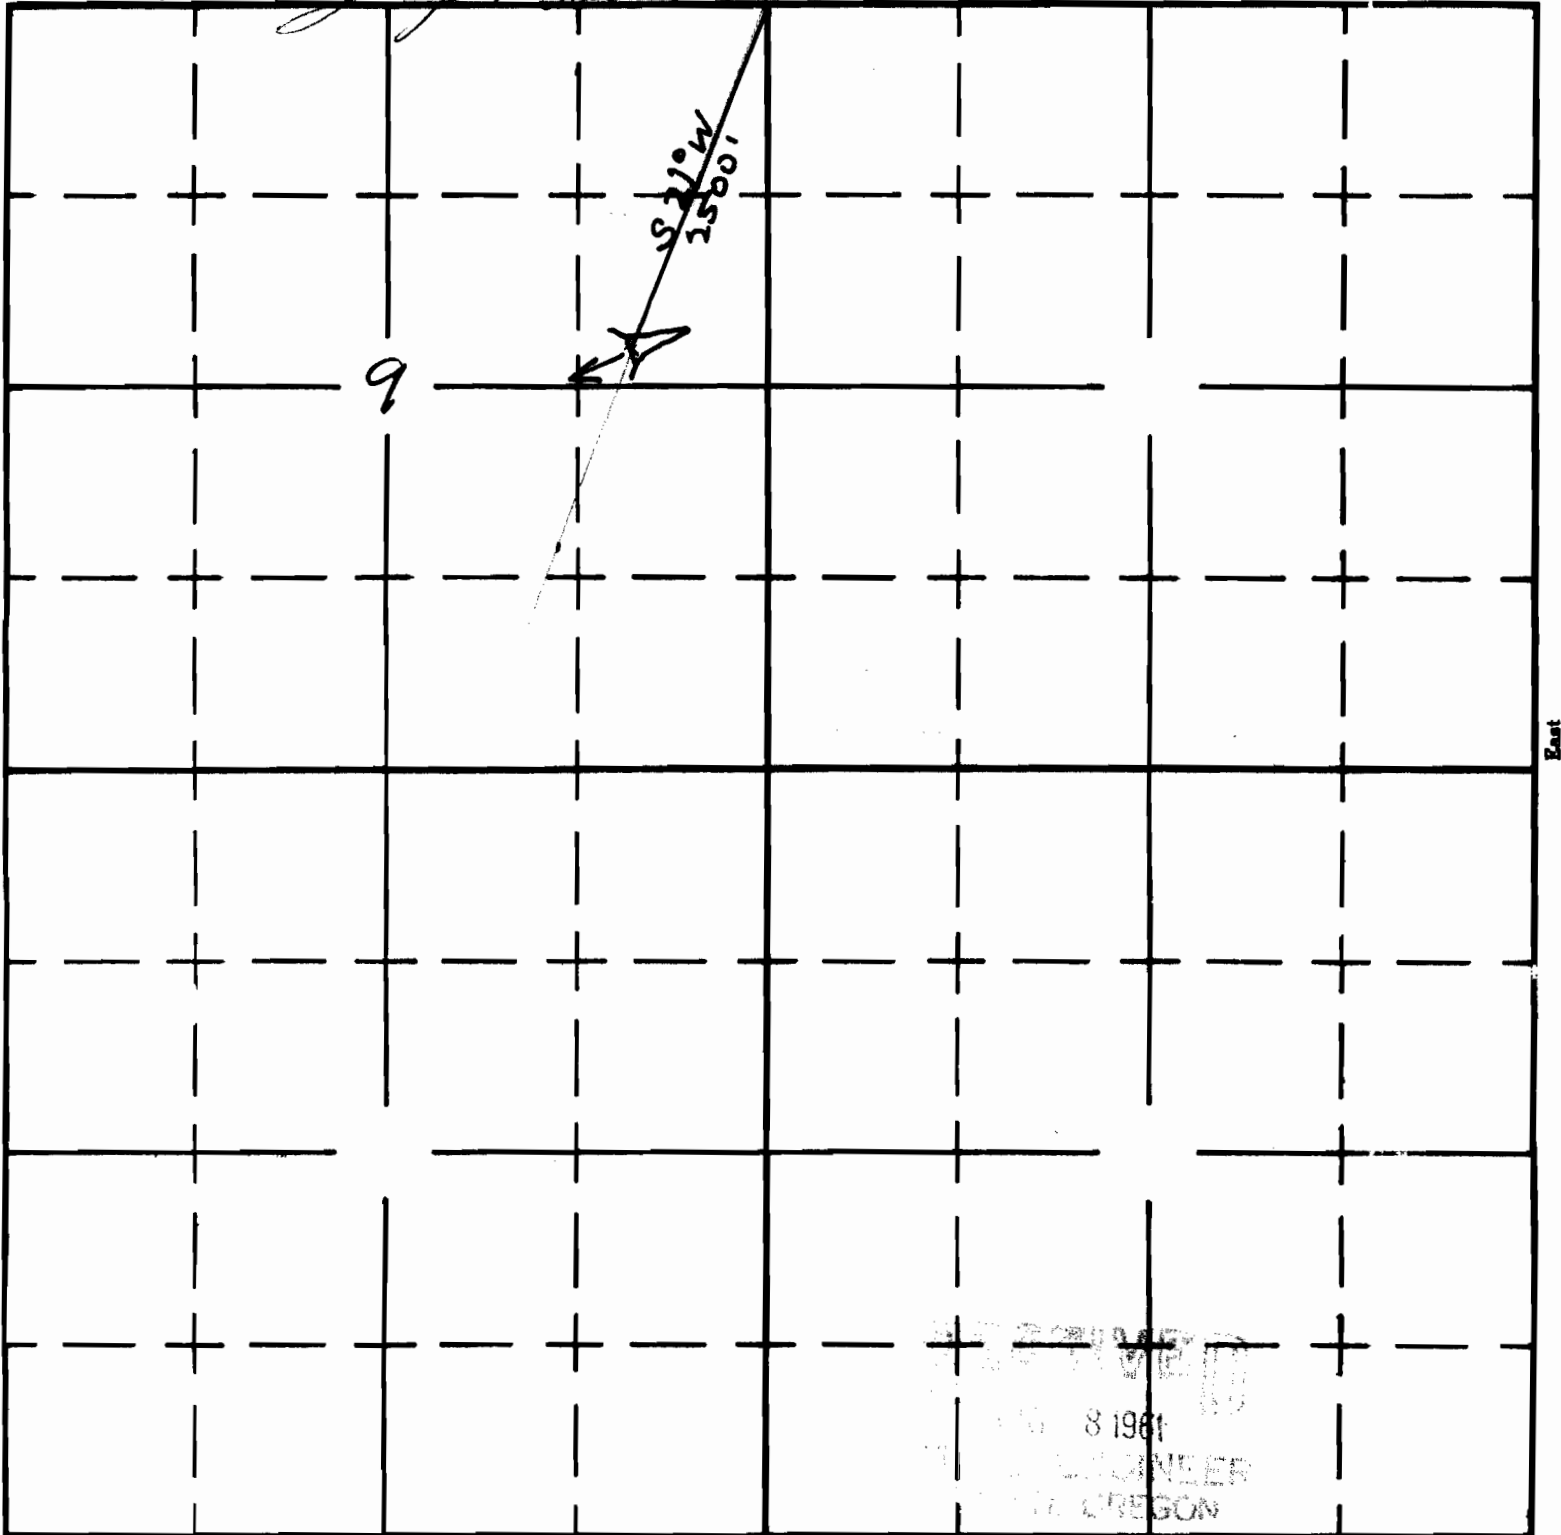

South

APPLICATION No. R-36719

PERMIT No. R-4284