

Form A1-187
March 1961

UNITED STATES
DEPARTMENT OF THE INTERIOR
BUREAU OF LAND MANAGEMENT

RECEIVED
JAN 26 1962
STATE ENGINEER
SALEM, OREGON
RECEIVED


SECTION 19

Oregon State Water Filings

TOWNSHIP 12 S., RANGE 41 E., W. M.

AUG - 1 1997

WATER RESOURCES DEPT.
SALEM, OREGON

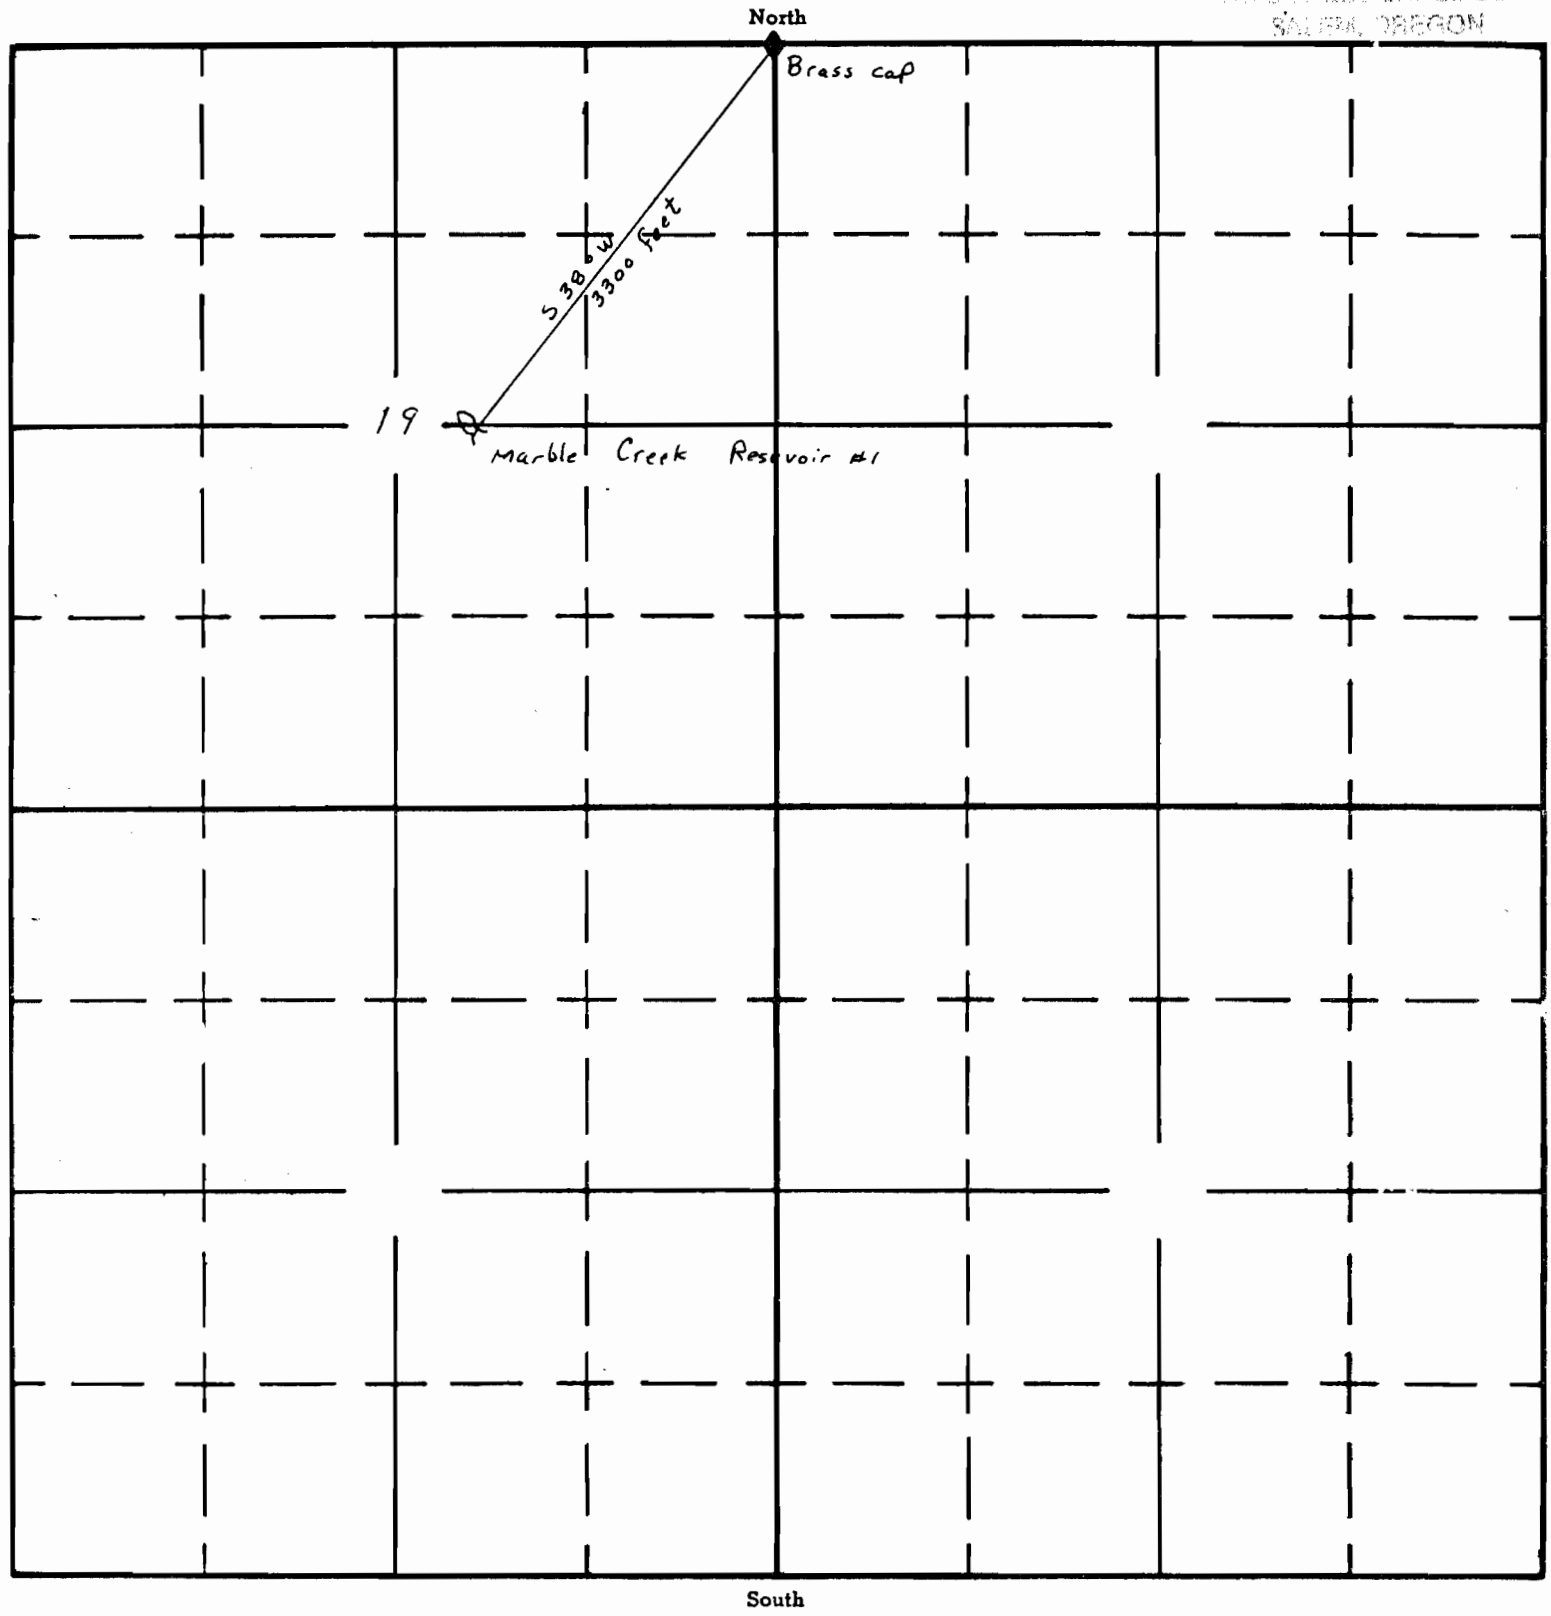

APPLICATION No. R-37340
PERMIT No. R-2724


APPLICATION MAP FOR PERMIT TO CONSTRUCT FOUR RESERVOIRS IN MARBLE CREEK AREA

U.S.G.S. QUAD - FRENCH GULCH, OREG. - 7 1/2'
SEC. 19 & 20, T.12S., R.41E., W.M.

RECEIVED

AUG - 1 1997

WATER RESOURCES DEPT.
SALEM, OREGON

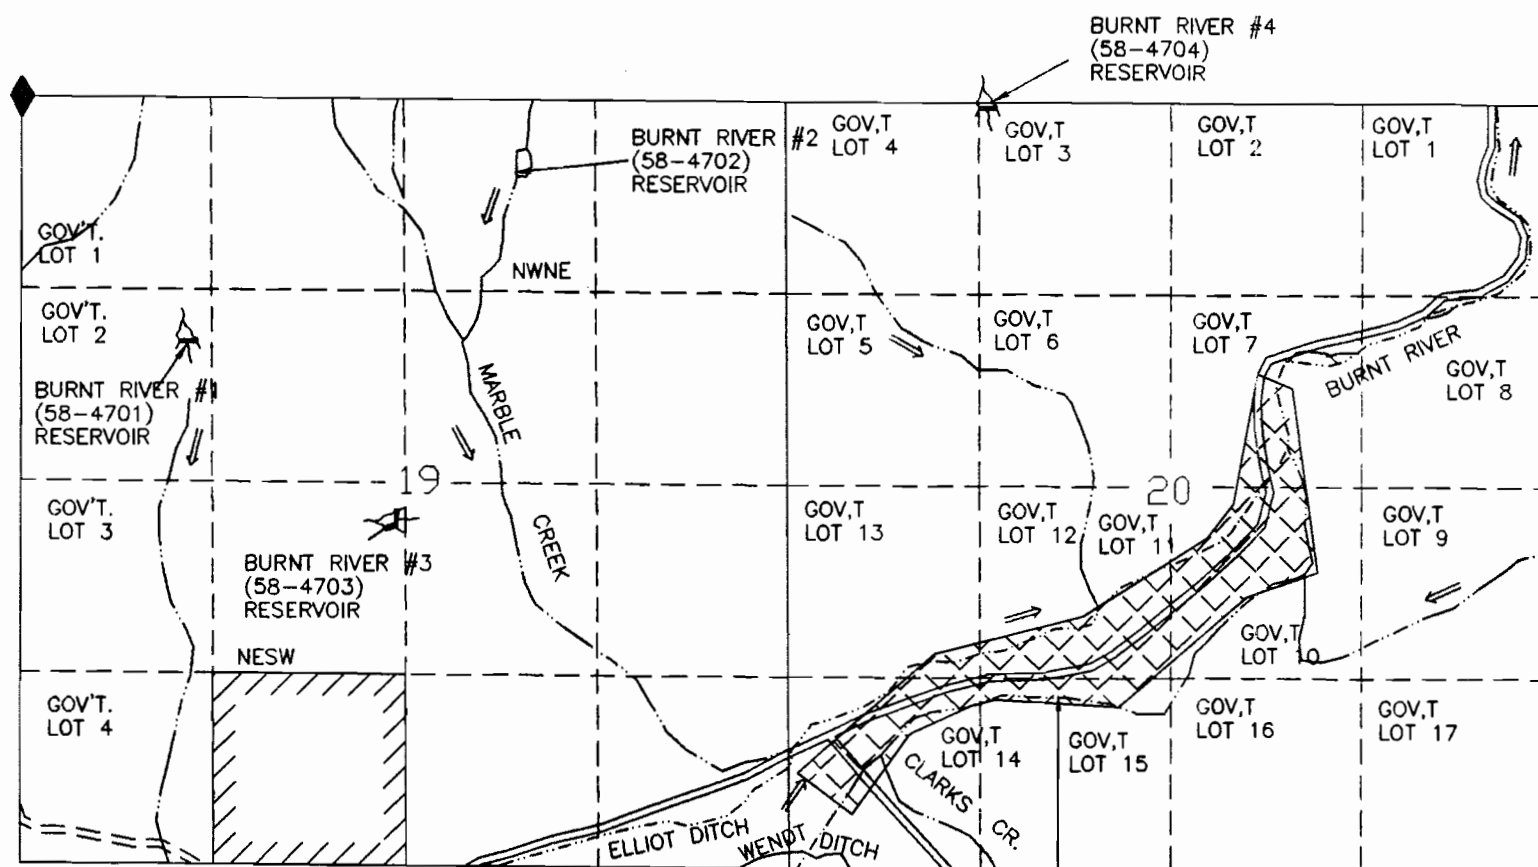

WM. L. SUTTON-GEO. W. LAKE &
JOEL E. MEACHUM PLACER LOT NO. 51

RESERVOIR NAME & JDR NO.	RESERVOIR LOCATION	DISTANCE & BEARING FROM NW COR SECTION 19 T.12S., R.41E., W.M.
BURNT RIVER #1 (58-4701) RESERVOIR	GOV'T. LOT 2 SECTION 19 T.12S., R.41E., W.M.	S34°00'01"E 2052.96'
BURNT RIVER #2 (58-4702) RESERVOIR	NW1/4NE1/4 SECTION 19 T.12S., R.41E., W.M.	S81°14'47"E 3422.32'
BURNT RIVER #3 (58-4703) RESERVOIR	NE1/4 SW1/4 SECTION 19 T.12S., R.41E., W.M.	S41°44'49"E 3902.48'
BURNT RIVER #4 (58-4704) RESERVOIR	GOV'T. LOT 3 SECTION 20 T.12S., R.41E., W.M.	S89°12'36"E 6651.65'


LEGEND

- RESERVOIR SHOWN ON QUAD
- RESERVOIR NOT SHOWN ON QUAD
- ROAD (MAIN)
- ROAD
- CHANNEL
- PRIVATE PROPERTY
- PATENTED MINING CLAIM
- FD SEC COR

1320 660 0 1320

SCALE 1"=1320'

THIS MAP IS FOR THE PURPOSE OF LOCATING
A WATER RIGHT AND IS NOT INTENDED TO
PROVIDE LEGAL DIMENSIONS FOR LOCATION
OF PROPERTY BOUNDARIES.

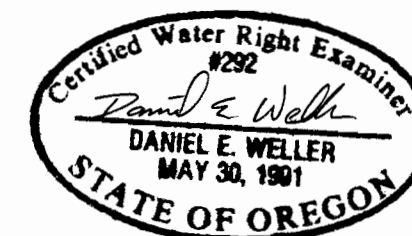

UNITED STATES DEPARTMENT OF THE INTERIOR
BUREAU OF LAND MANAGEMENT
DIVISION OF OPERATIONS VALE DISTRICT

RESERVOIRS SITUATED IN MARBLE CREEK AREA

DESIGNED _____
REVIEWED *Daniel E. Weller*
APPROVED *Dan F. Fuchs*
CHIEF, BRANCH OF ENGINEERING
DRAWN: CG SCALE: 1"=1320'
DATE: 01/12/96 SHEET 1 OF 1
DRAWING NO. OR-03-9172.45-713

ACAD RELEASE 11
DWG FILE: MARBLE