

APPLICATION MAP FOR PERMIT TO CONSTRUCT TWO RESERVOIRS


GOV'T. LOT 1 SEC 4 T 10S R 46E W.M.

U.S.G.S. QUAD - STURGILL CREEK, IDAHO-OREG. - 7 1/2'


RECEIVED

AUG 1 1997

WATER RESOURCES DEPT.
SALEM, OREGON

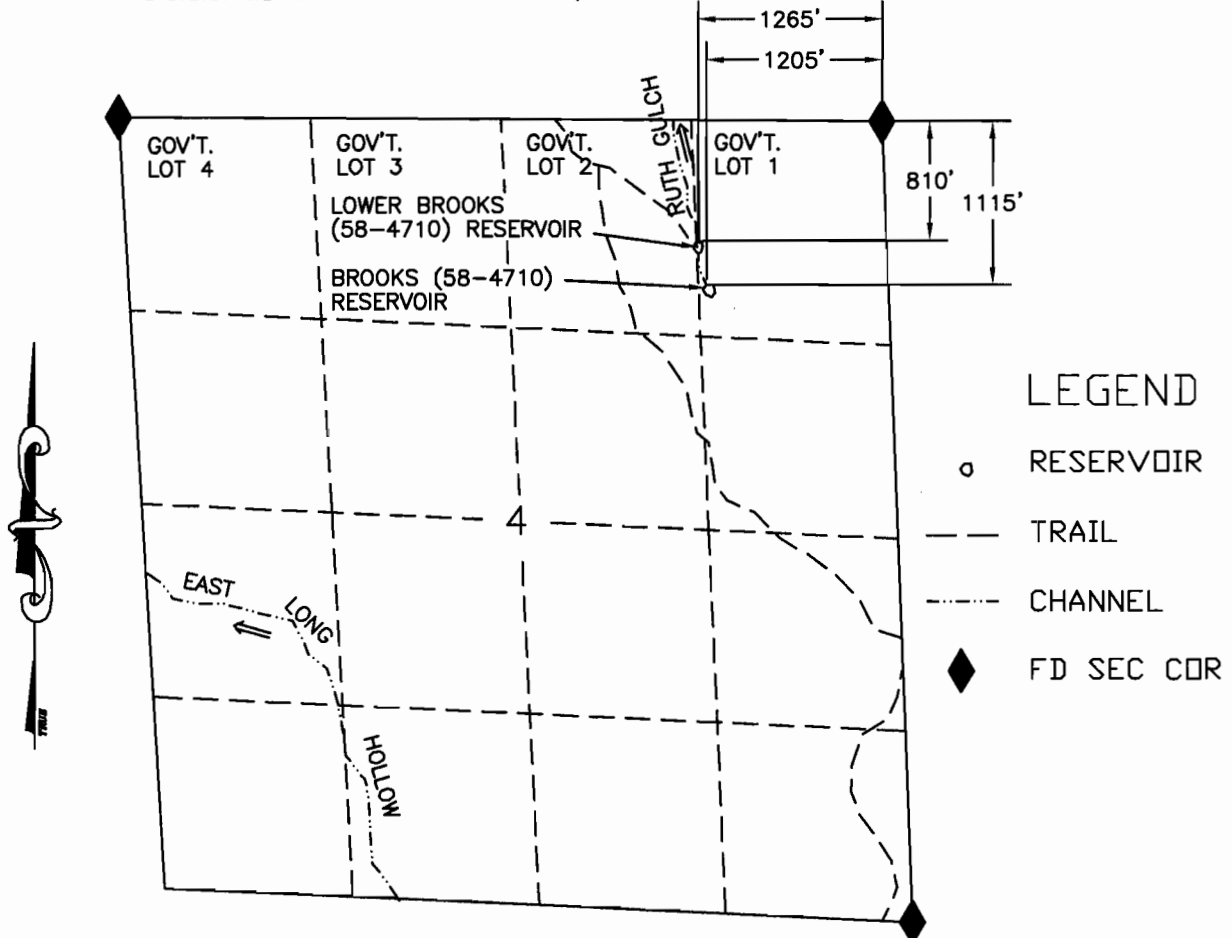

BROOKS & LOWER BROOKS (58-4710) RESERVOIRS

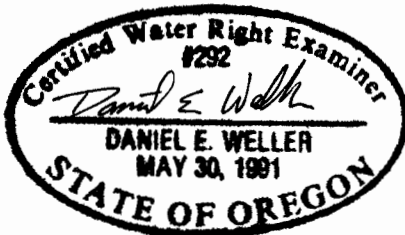

1320 660 0 1320

SCALE 1"=1320'

THIS MAP IS FOR THE PURPOSE OF LOCATING
A WATER RIGHT AND IS NOT INTENDED TO
PROVIDE LEGAL DIMENSIONS FOR LOCATION
OF PROPERTY BOUNDARIES.



UNITED STATES DEPARTMENT OF THE INTERIOR
BUREAU OF LAND MANAGEMENT
DIVISION OF OPERATIONS VALE DISTRICT

BROOKS & LOWER BROOKS
(58-4710) RESERVOIRS

DESIGNED
REVIEWED
APPROVED

DRAWN: CG SCALE: 1"=1320'
DATE: 05/05/95 SHEET 1 OF 1
DRAWING NO. OR-03-9172.45-762

ACAD RELEASE 11/DCA
DWG FILE: BROOKS.DWG

Form AI-187
March 1961

UNITED STATES
DEPARTMENT OF THE INTERIOR
BUREAU OF LAND MANAGEMENT

SECTION

4

Oregon State Water Filings


TOWNSHIP 10 S, RANGE 46 E, W. M.

AUG 1 1997

WATER RESOURCES DEPT.
SALEM, OREGON

North

1-C-120

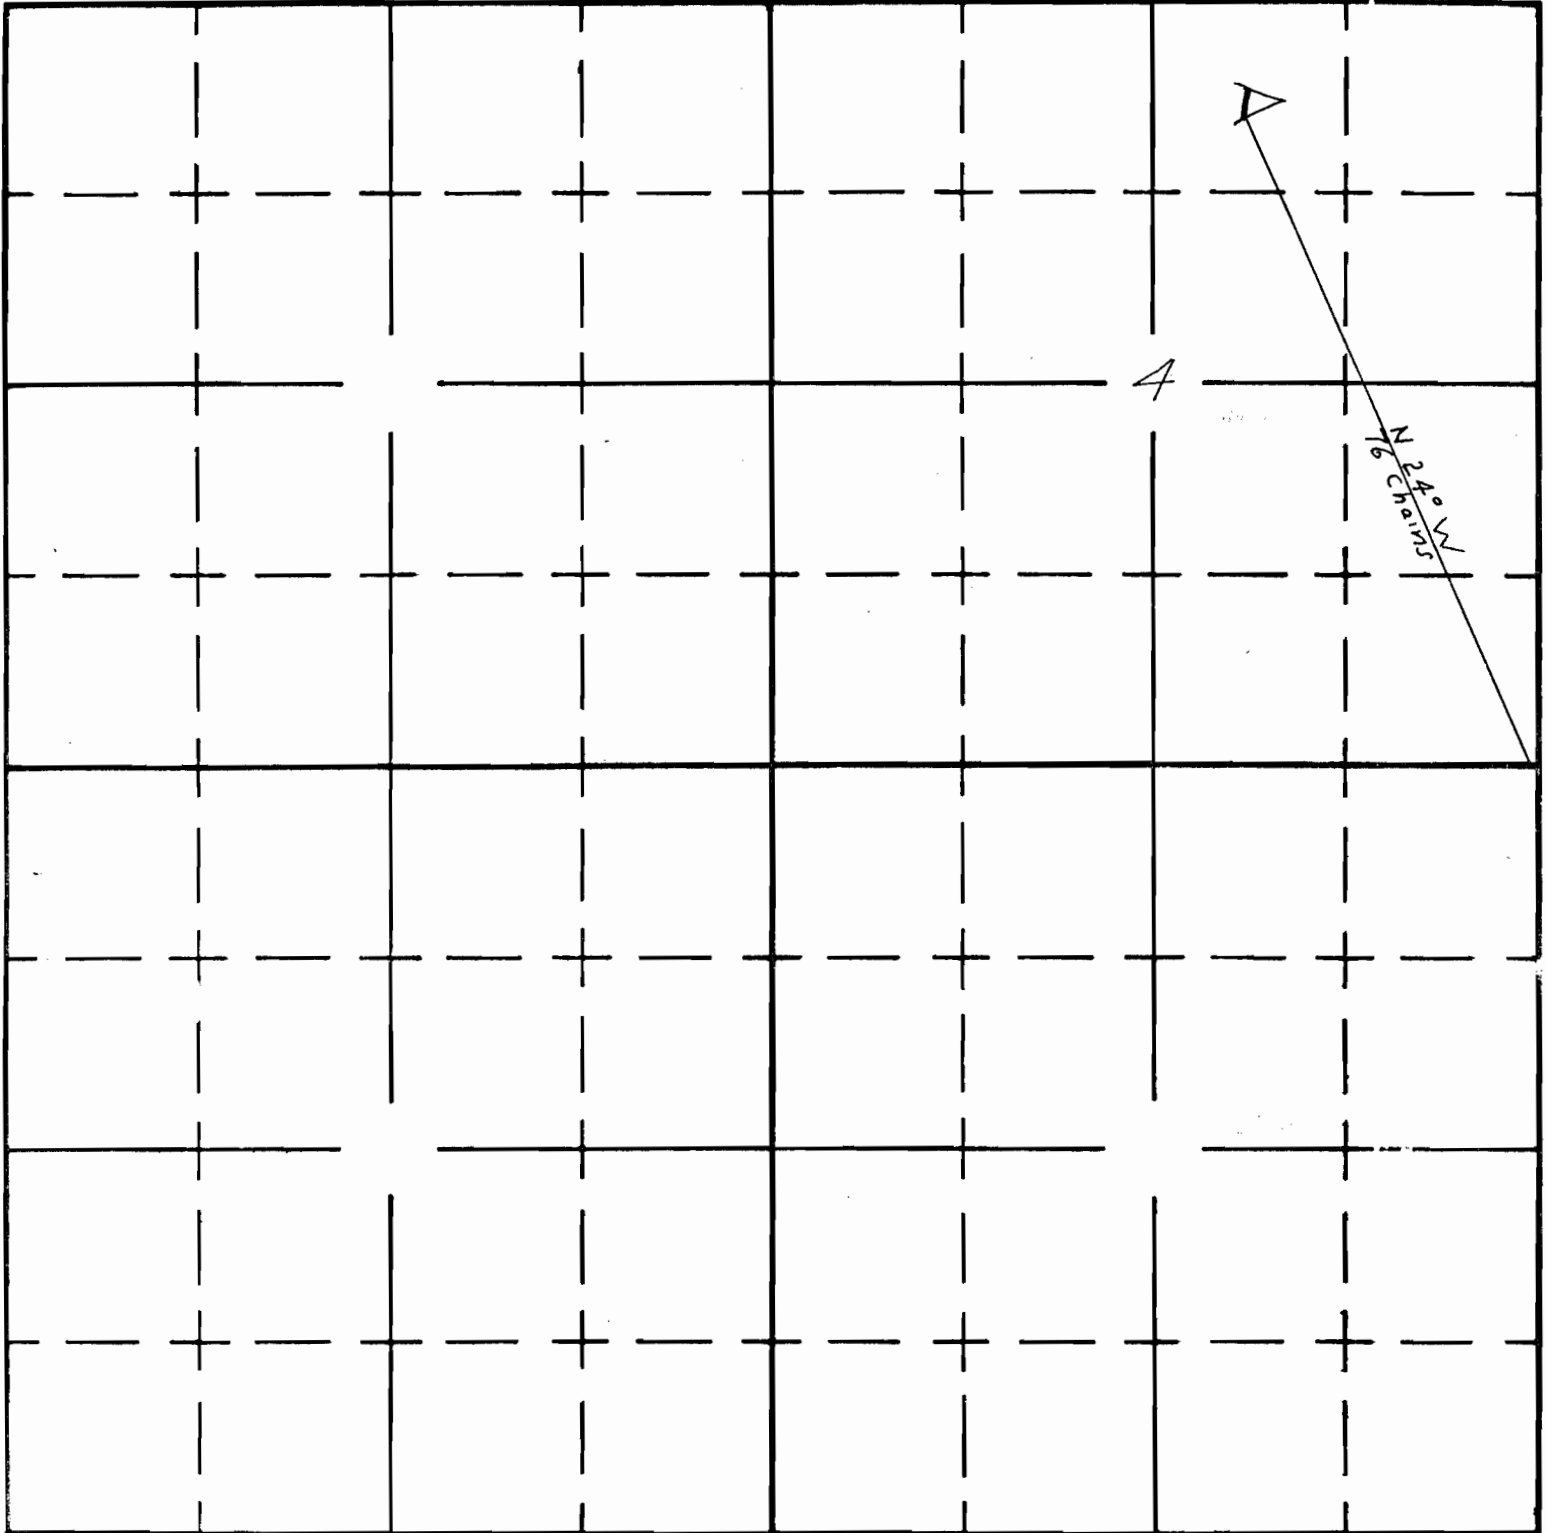

South

APPLICATION No. R-3222
PERMIT No. R-3222