

Form A1-187
March 1961

UNITED STATES
DEPARTMENT OF THE INTERIOR
BUREAU OF LAND MANAGEMENT

AUG 13 1997

SECTION

26


Oregon State Water Filings

TOWNSHIP 10S, RANGE 42E, W. M.

WATER RESOURCES DEPT.

North

06-350

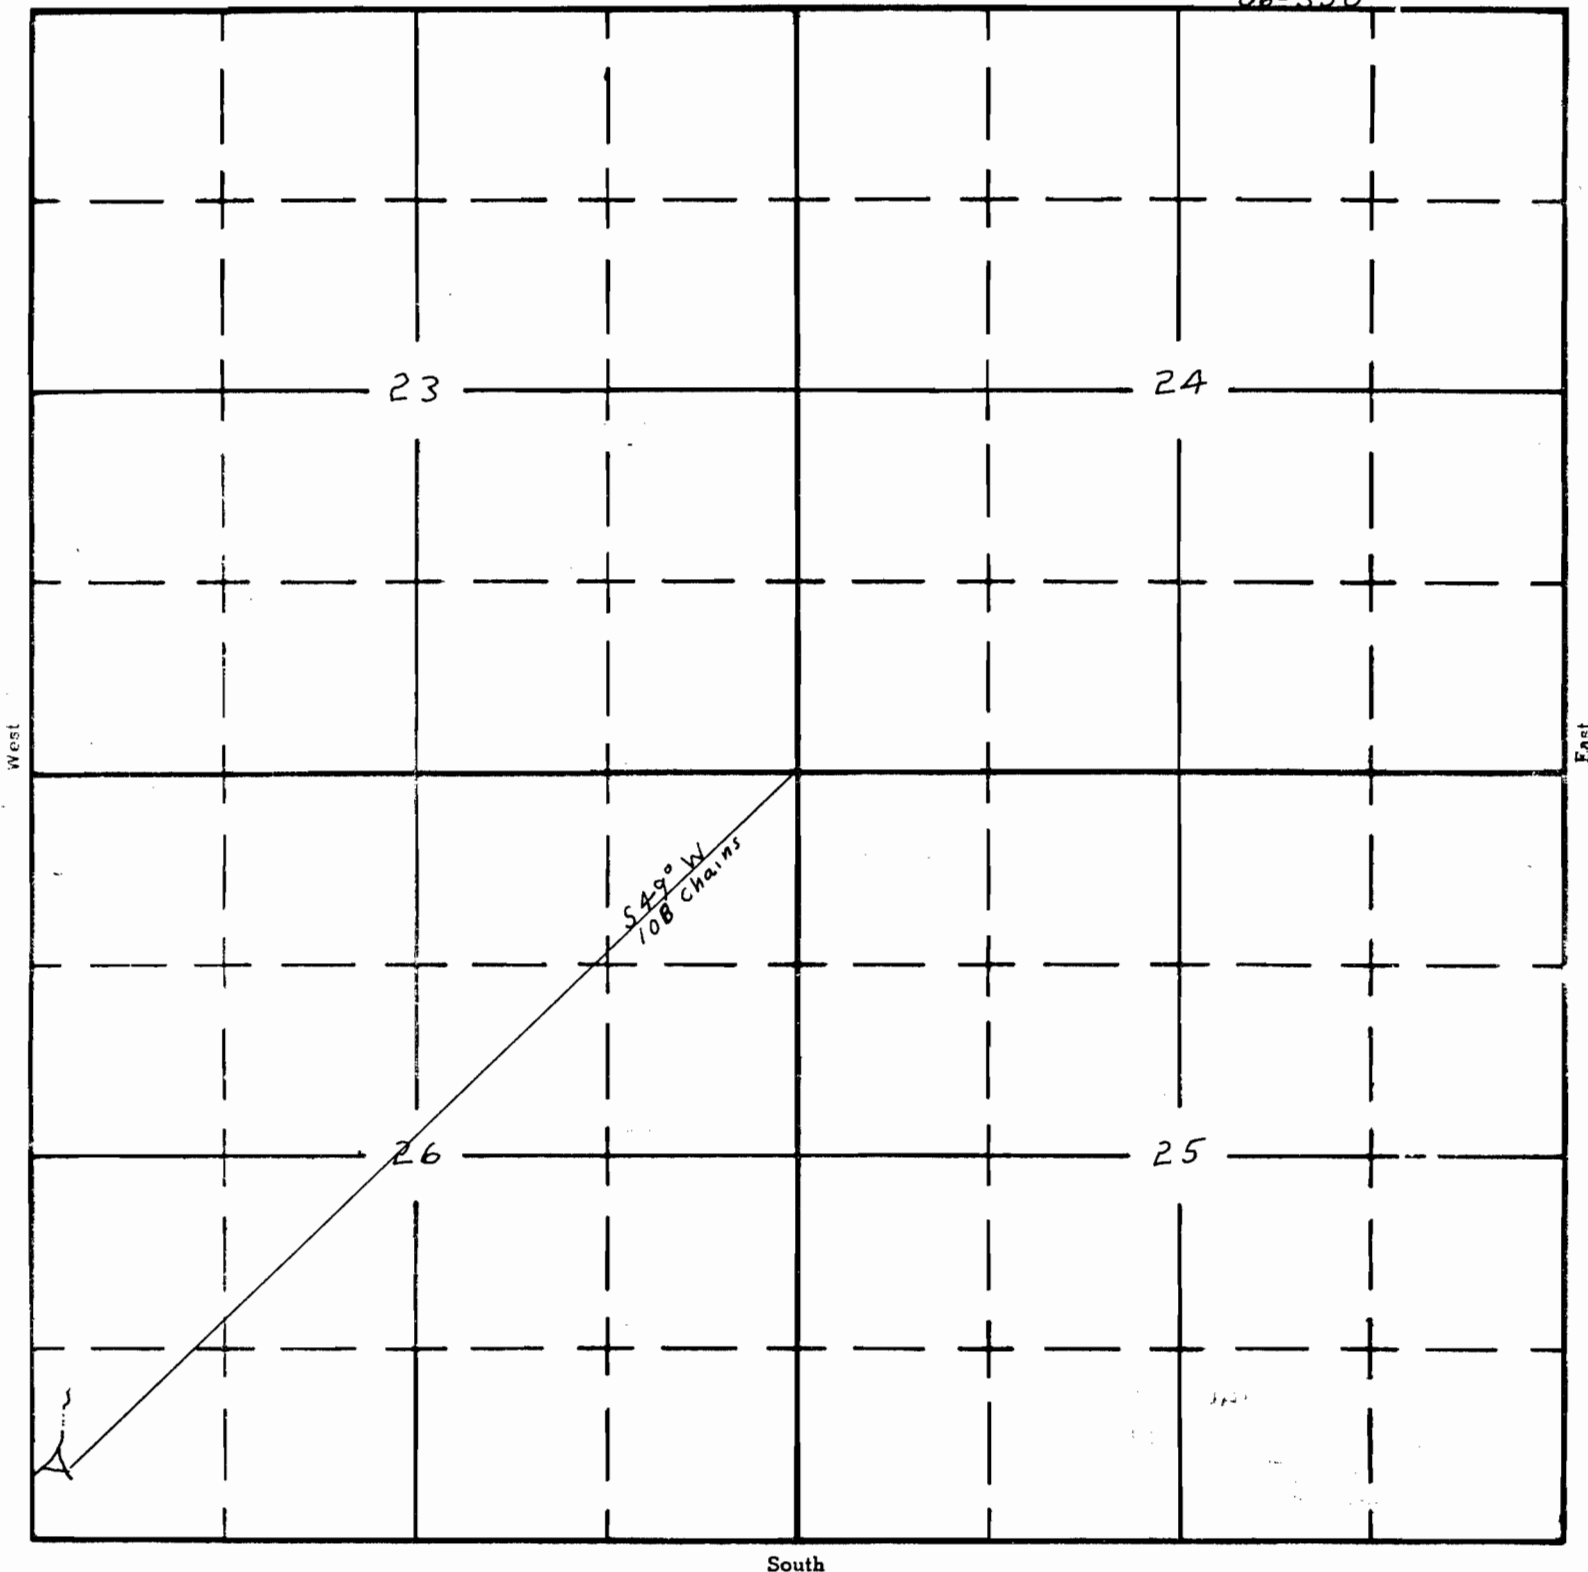

South

APPLICATION No. R-38404
PERMIT No. R-3858