

WATER RIGHTS MAP FOR LOCATION CHANGE


RECEIVED

AUG - 1 1997

WATER RESOURCES DEPT.
SALEM, OREGON

NW1/4 NW1/4 SEC 21 T 38S R 37E W.M.



U.S.G.S. QUAD - RED LOOKOUT BUTTE, OREG. - 7 1/2'

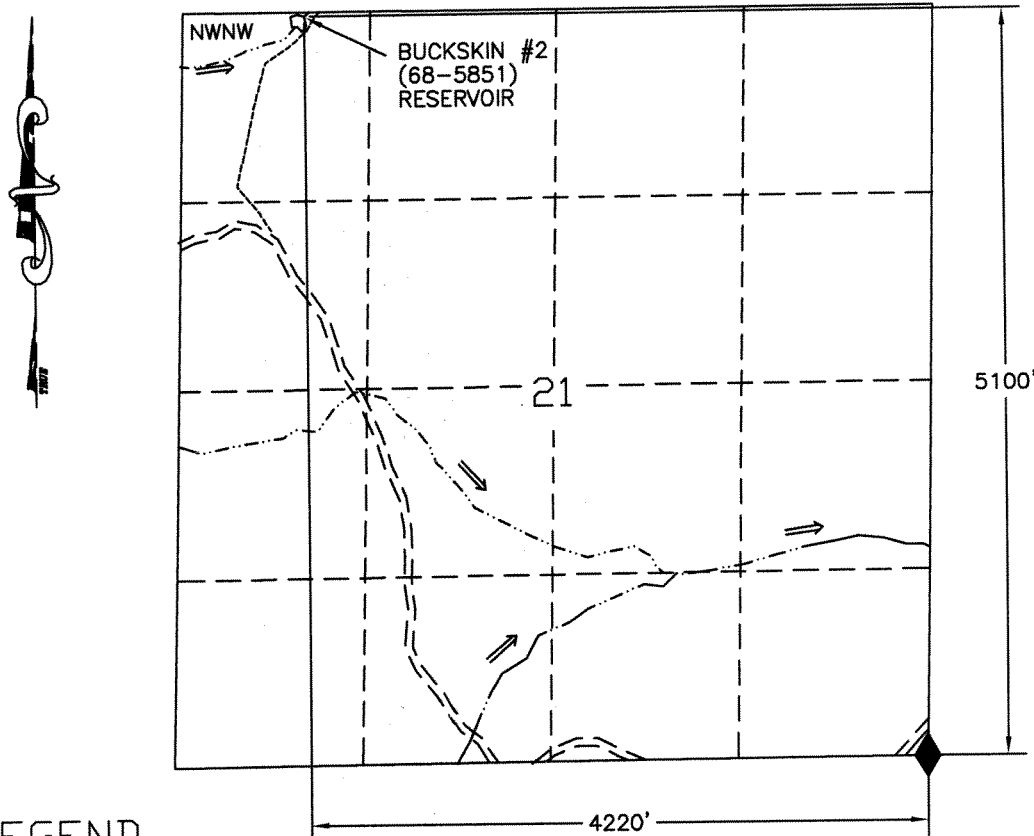

LEGEND

- RESERVOIR
- == ROAD
- CHANNEL
- 4WD TRAIL
- ◆ FD SEC COR

BUCKSKIN #2 (68-5851) RESERVOIR

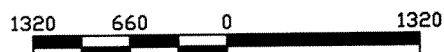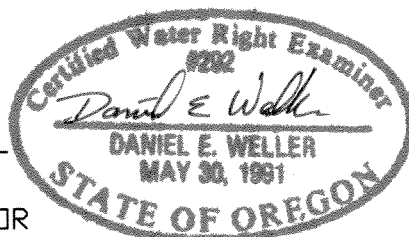

SCALE 1"=1320'

THIS MAP IS FOR THE PURPOSE OF LOCATING
A WATER RIGHT AND IS NOT INTENDED TO
PROVIDE LEGAL DIMENSIONS FOR LOCATION
OF PROPERTY BOUNDARIES.



UNITED STATES DEPARTMENT OF THE INTERIOR
BUREAU OF LAND MANAGEMENT
DIVISION OF OPERATIONS VALE DISTRICT

BUCKSKIN #2
(68-5851) RESERVOIR

DESIGNED _____
REVIEWED *Daniel E. Weller*
APPROVED *Lyne Smith*
CHIEF, BRANCH OF ENGINEERING

DRAWN: CG SCALE: 1"=1320'

DATE: 04/04/96 SHEET 1 OF 1

DRAWING NO. OR-03-9172.45-928

ACAD12/DCA
DWG FILEBUCKSKI2.DWG