

UNITED STATES
DEPARTMENT OF THE INTERIOR
BUREAU OF LAND MANAGEMENT

SECTION


15

Oregon State Water Filings

TOWNSHIP 11S, RANGE 42E, W. M.

North

06-378

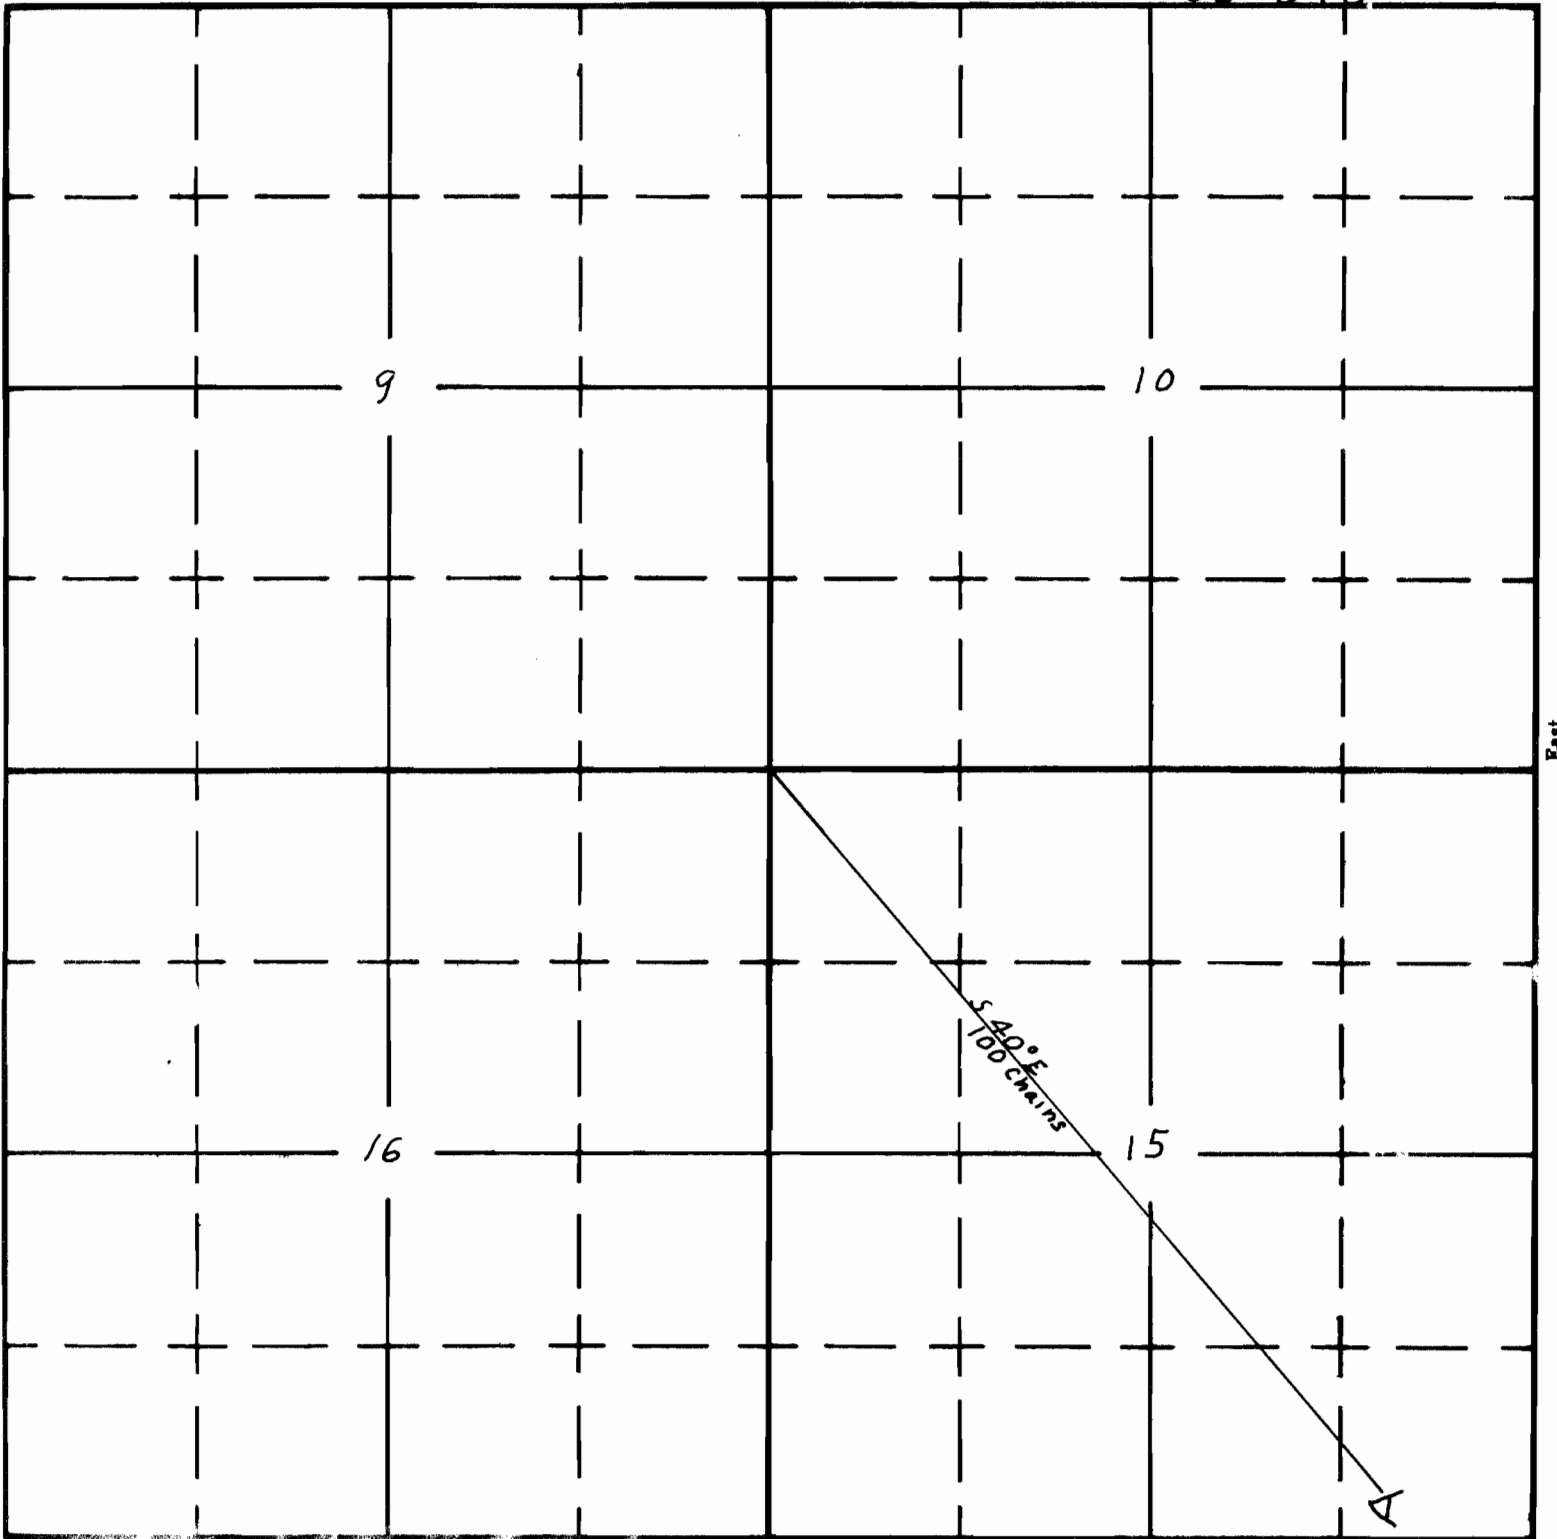

South

APPLICATION No. R-38726
PERMIT No. R-3273