

UNITED STATES
DEPARTMENT OF THE INTERIOR
BUREAU OF LAND MANAGEMENT

SECTION


27

Oregon State Water Filings

TOWNSHIP ~~10S~~ 13S, RANGE 43E, W. M.

North

06-438

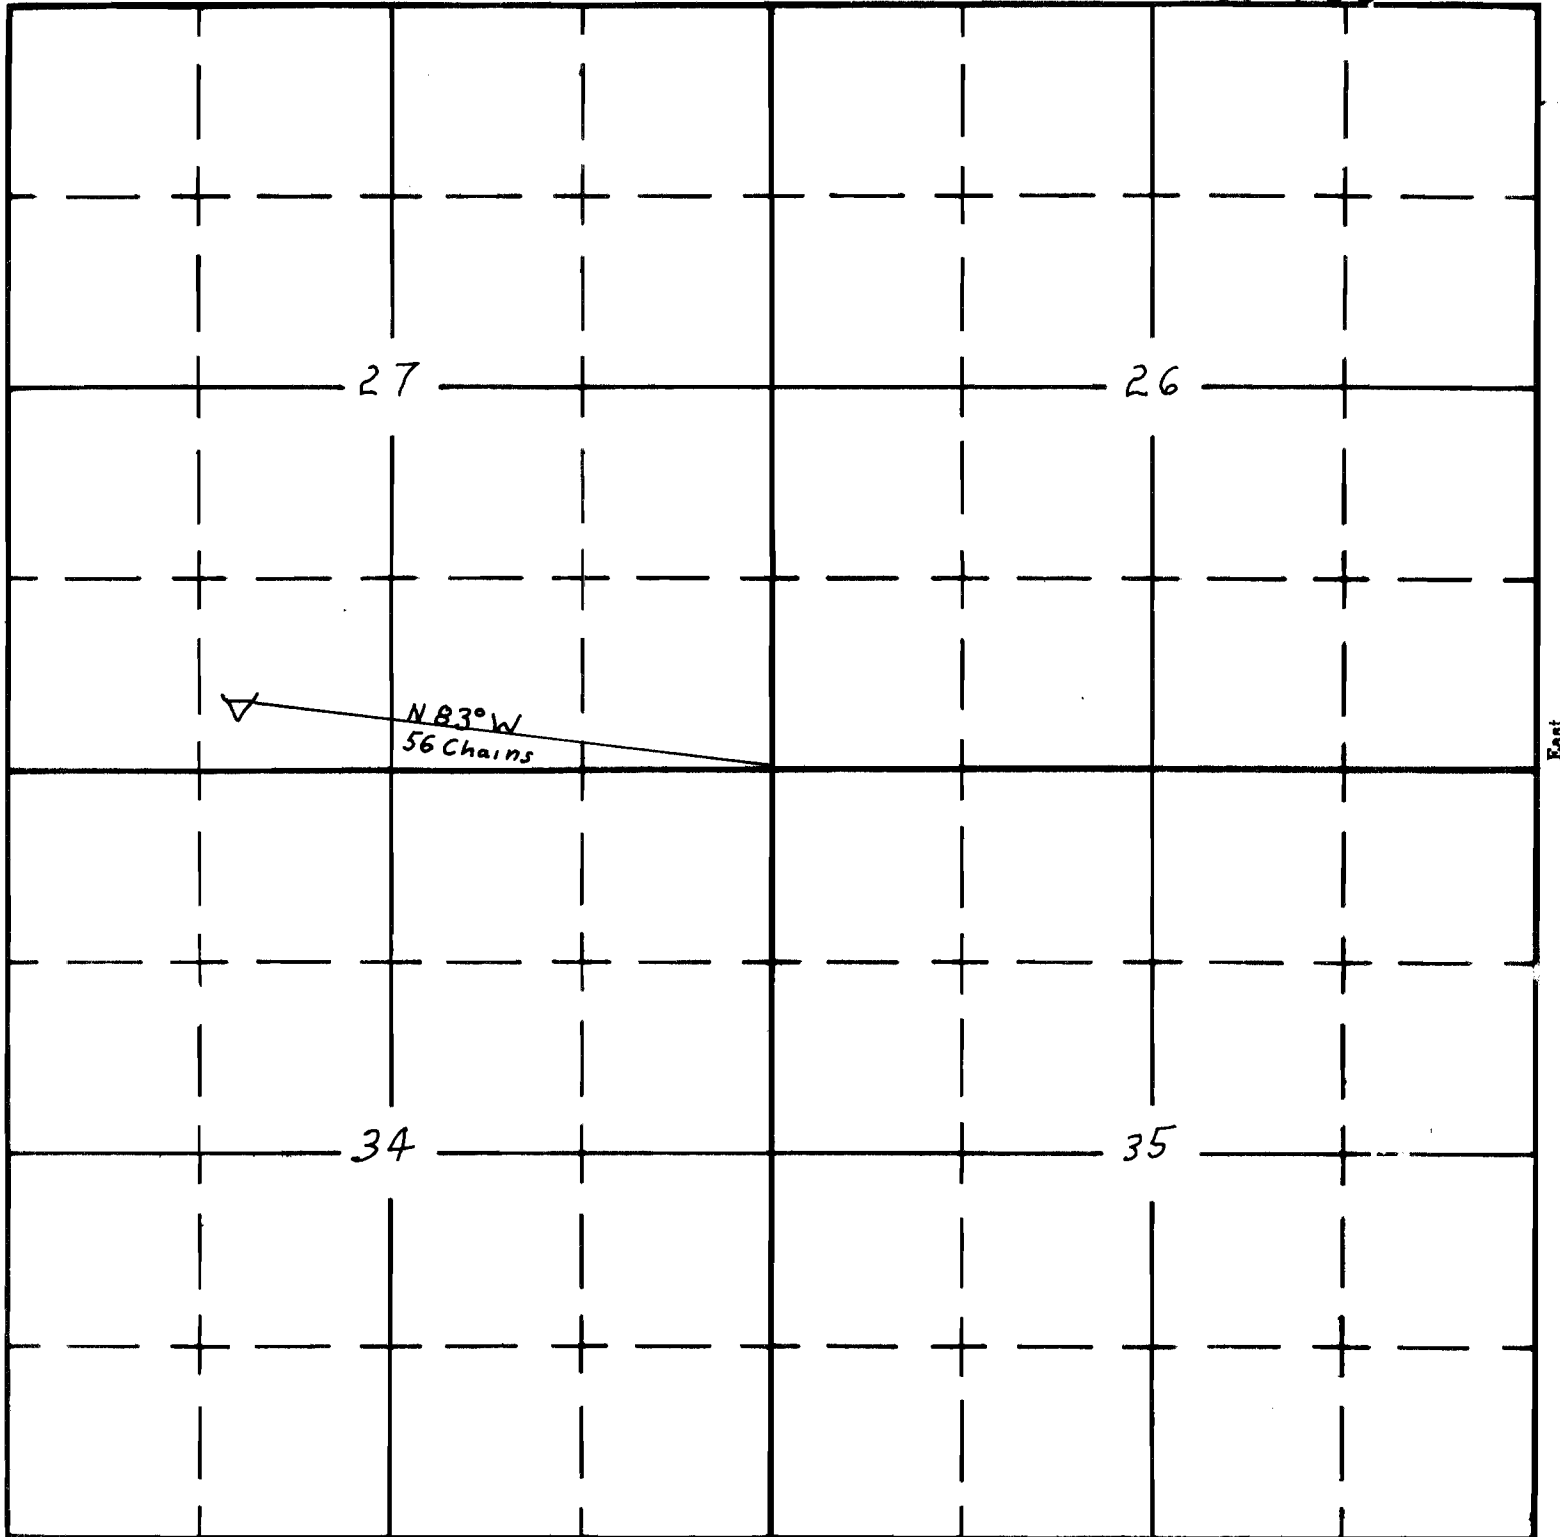

South

Application No. R-38731
Permit No. R-3278

APPLICATION No.
PERMIT No.