


SECTION 2

NE $\frac{1}{4}$ SW $\frac{1}{4}$

TOWNSHIP 20S RANGE 38E W.M

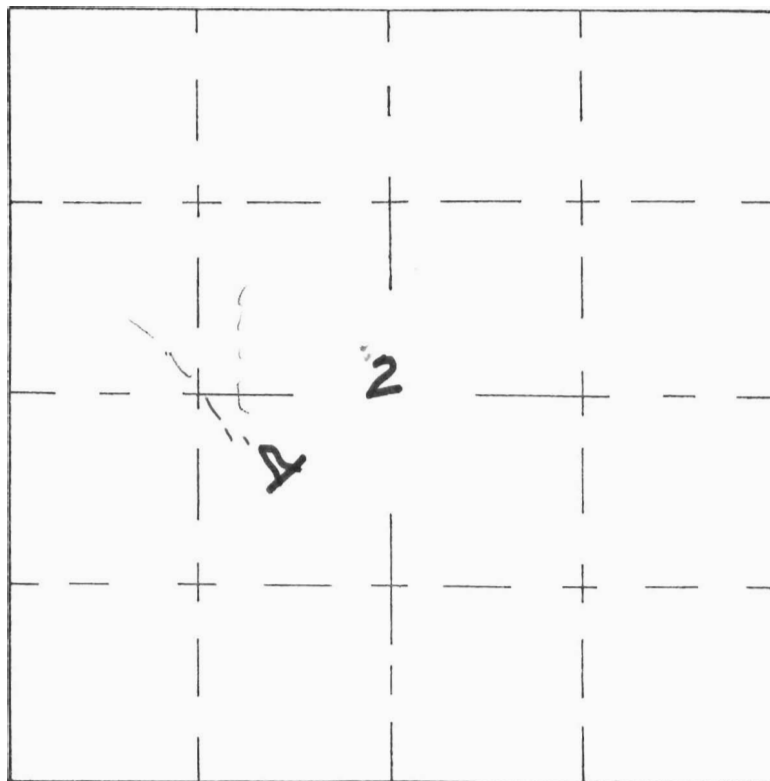

Forrest Res.

Application ~~No.~~ *R 59081*

Permit No. *R 8723*

RECEIVED RECEIVED

APR 6 1983

JAN 14 1983

WATER RESOURCES DEPT.

WATER RESOURCES DEPT.

SALEM, OREGON

SALEM, OREGON