


SECTION 3

SE $\frac{1}{4}$ SE $\frac{1}{4}$

TOWNSHIP 39S RANGE 48E W.M.

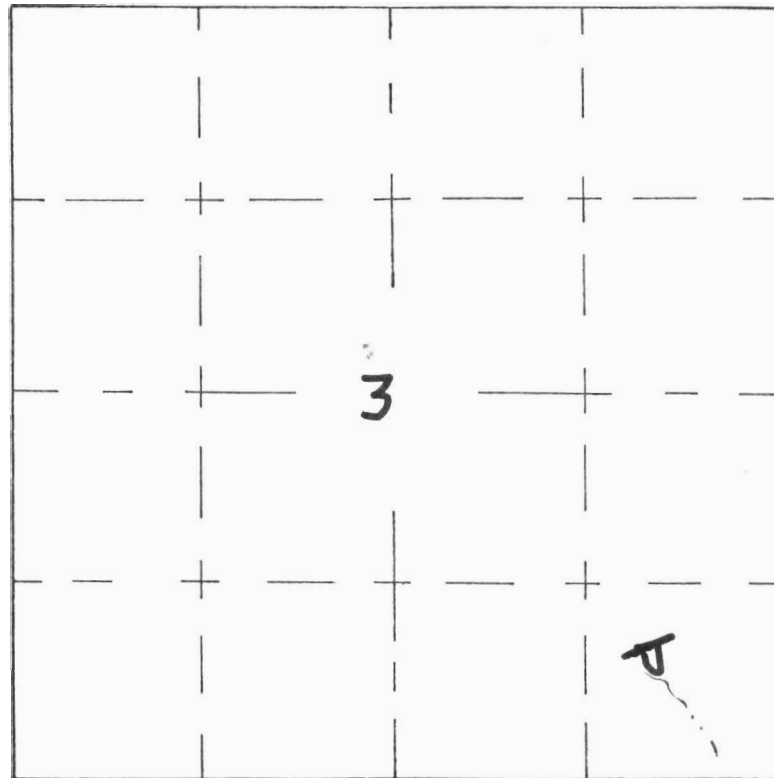

East Toppin Crk.
No R 590 88

Permit No. R 8729