

RECEIVED


AUG 6 - 1979

WATER

SECTION 8

SE 1/4 NW 1/4

TOWNSHIP 39^S RANGE 47^E W.M.

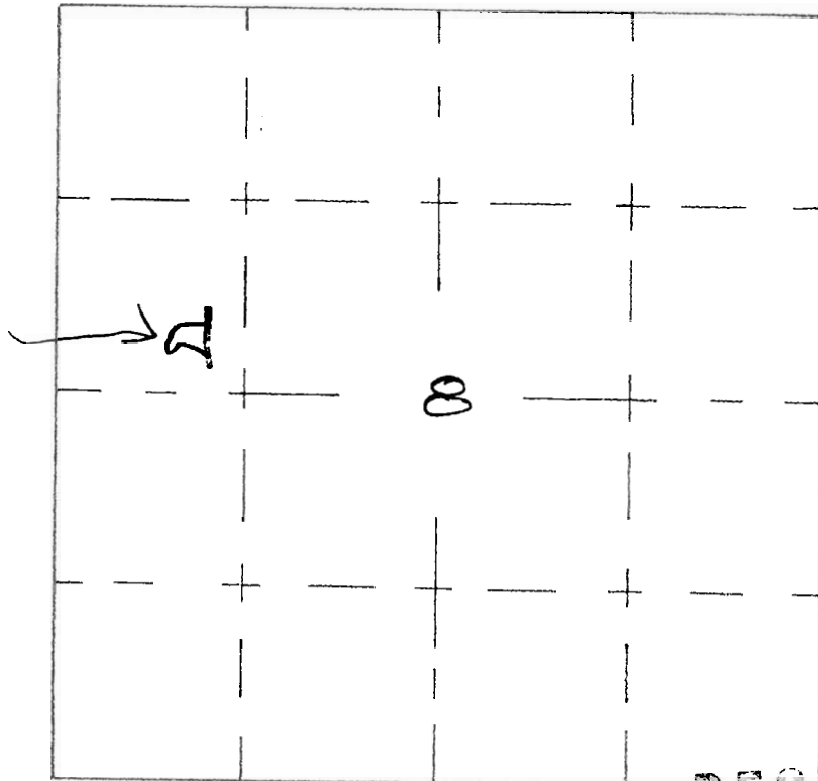

RECEIVED

APR 6 1983

WATER RESOURCES DEPT.
SALEM, OREGON

Application No. R59094

Permit No. R 8733

U. S. DEPARTMENT OF THE INTERIOR
BUREAU OF LAND MANAGEMENT

LITTLE LOUSE CANYON LAKE

DESIGNED _____

RECOMM. _____

DRAWN _____

RECOMM. _____

CHIEF, DIV. OF ENG.

CHECKED _____

APPROVED _____

SCALE _____

DATE _____

SHEET _____ OF _____

DRAWING NO. _____