

RECEIVED


AUG 11 1997

WATER RESOURCES DEPT.
SALEM, OREGON

SECTION 31

SW $\frac{1}{4}$ NW $\frac{1}{4}$

TOWNSHIP 19S RANGE 38E W.M.

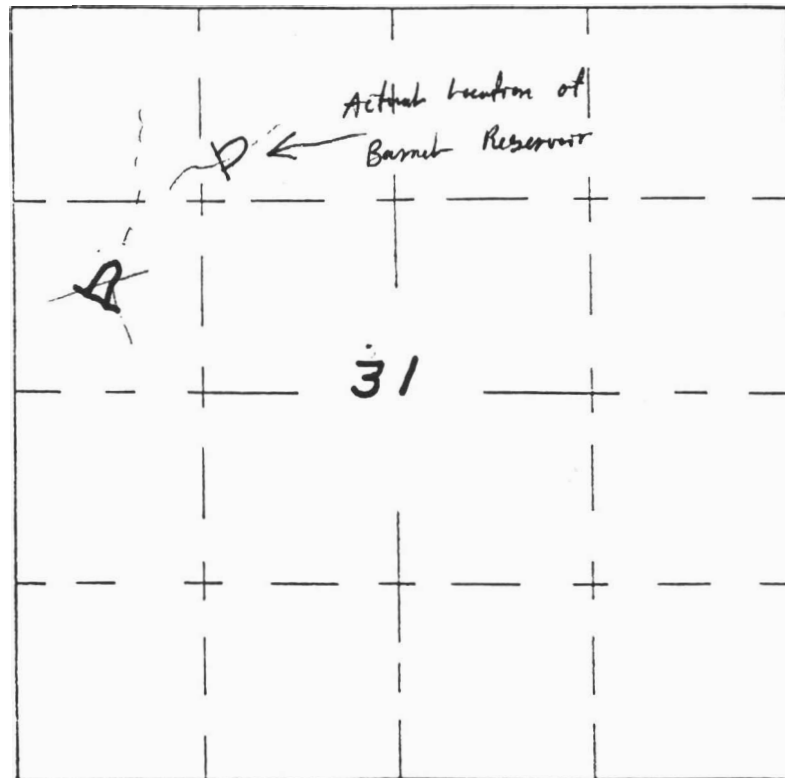

Barrel Res.
N^o R 59116

Permit No. R 8752