

UNITED STATES
DEPARTMENT OF THE INTERIOR
BUREAU OF LAND MANAGEMENT

RECEIVED

JUL 31 1997

SECTION


31

NE 1/4 of NE 1/4

Oregon State Water Filings

WATER RESOURCES DEPT.
SALEM, OREGON

TOWNSHIP 27S, RANGE 43E, W. M.

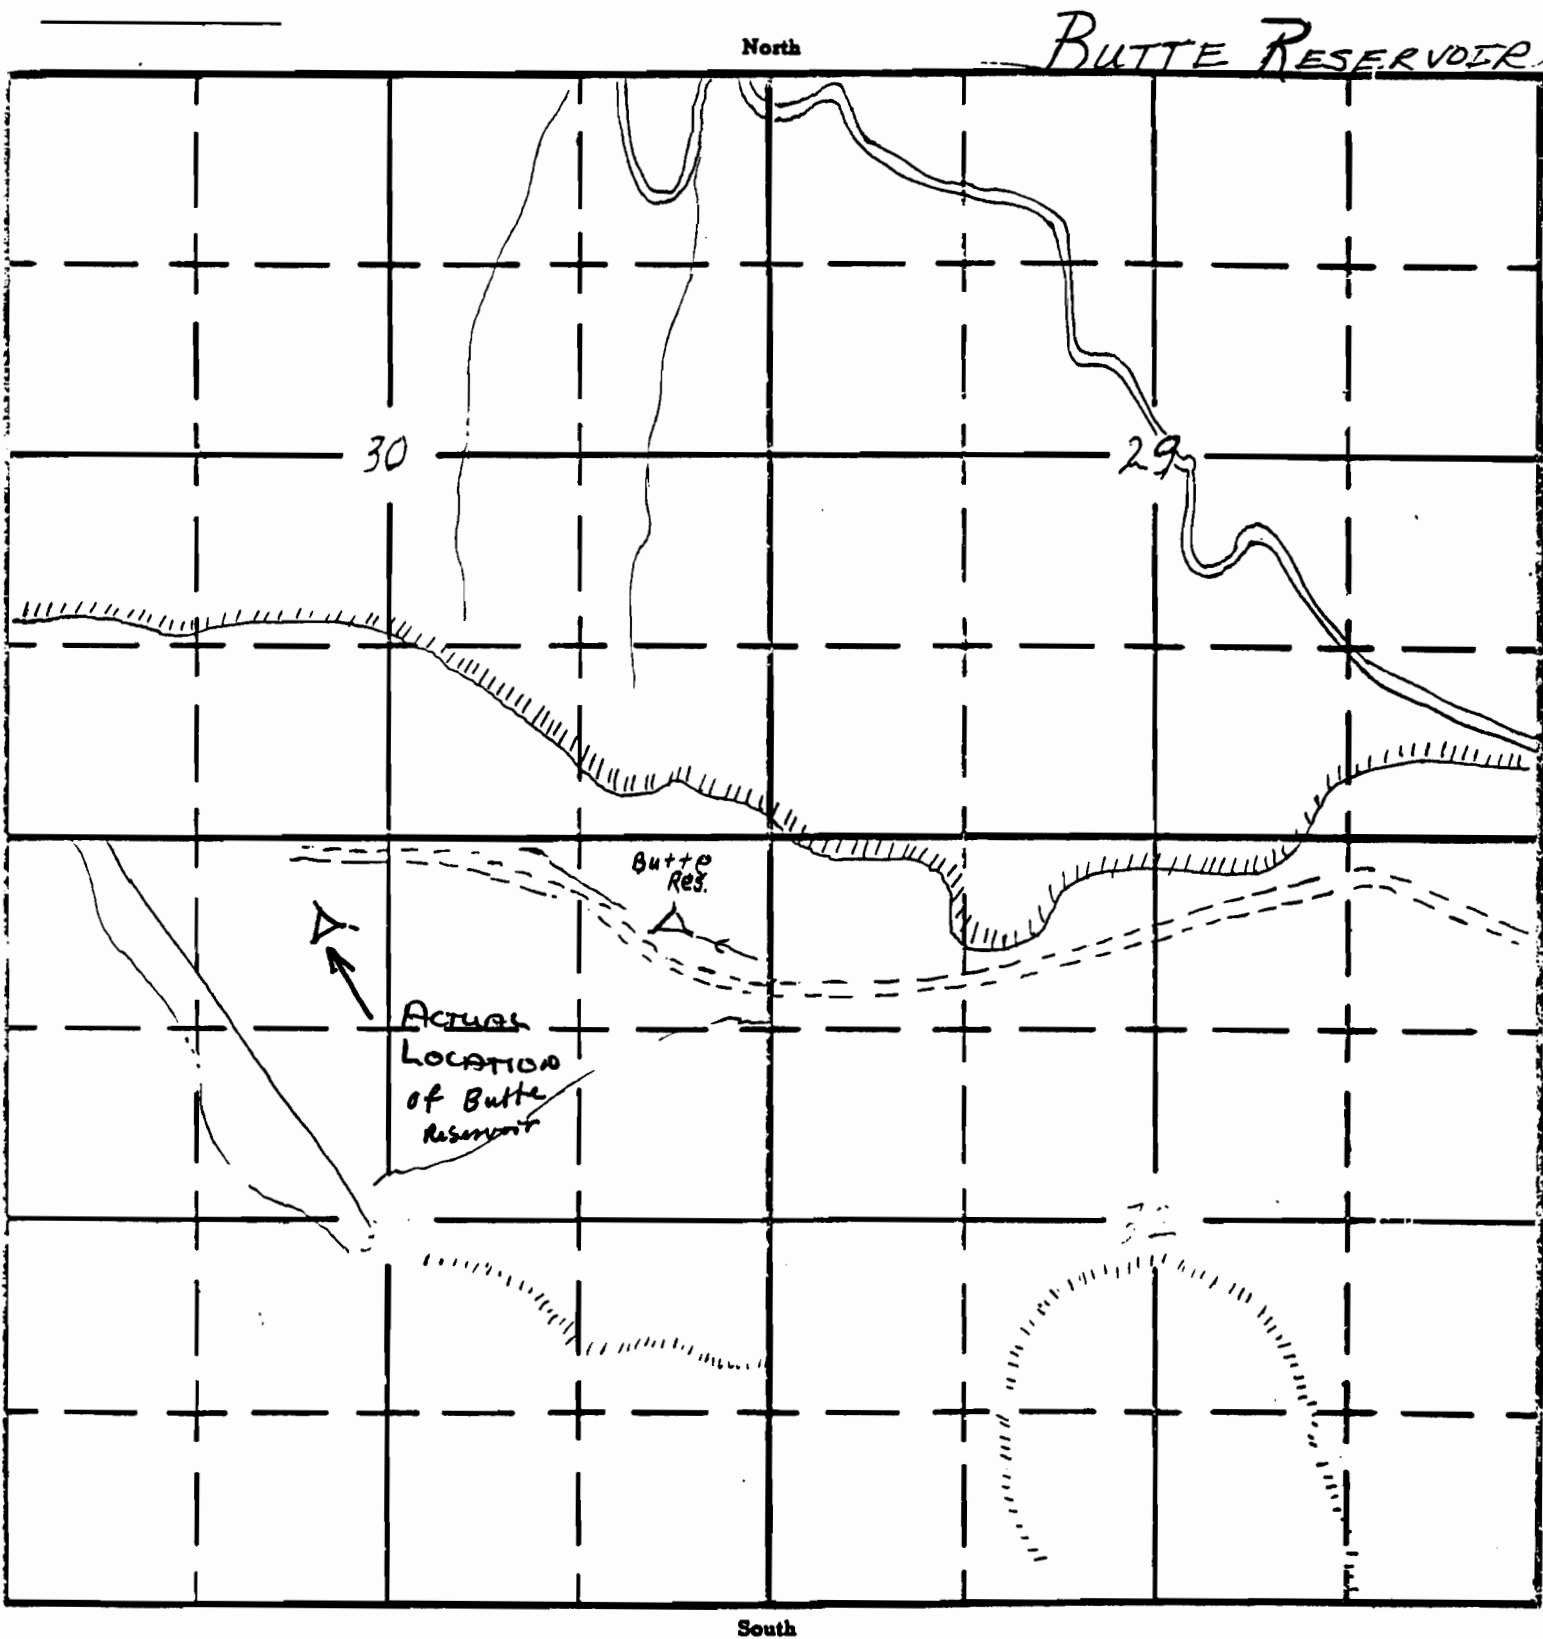

APPLICATION No. R-67812

PERMIT No. R1063