


RECEIVED STATE
ENGINEER

APR 13 1924

MOORE 1

W. O. F. 107

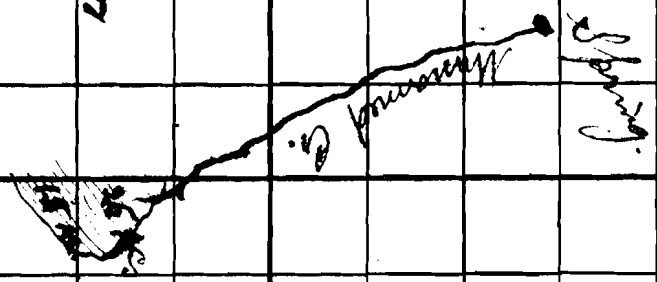

5

4

3

2

1

6

9

10

11

12

17

16

15

14

13

18

20

21

22

23

24

19

Application No. 9475

Rec'd No 6271

STATE ENGINEER
RECEIVED

APR 24 1924

OREGON