

March 1961

UNITED STATES
DEPARTMENT OF THE INTERIOR
BUREAU OF LAND MANAGEMENT

10-#5436
shadscale Res

10-#5443
upshadscale


SECTION

Oregon State Water Filings

13 SENE

14 NENE

TOWNSHIP 32 S, RANGE 36 E, W. M.

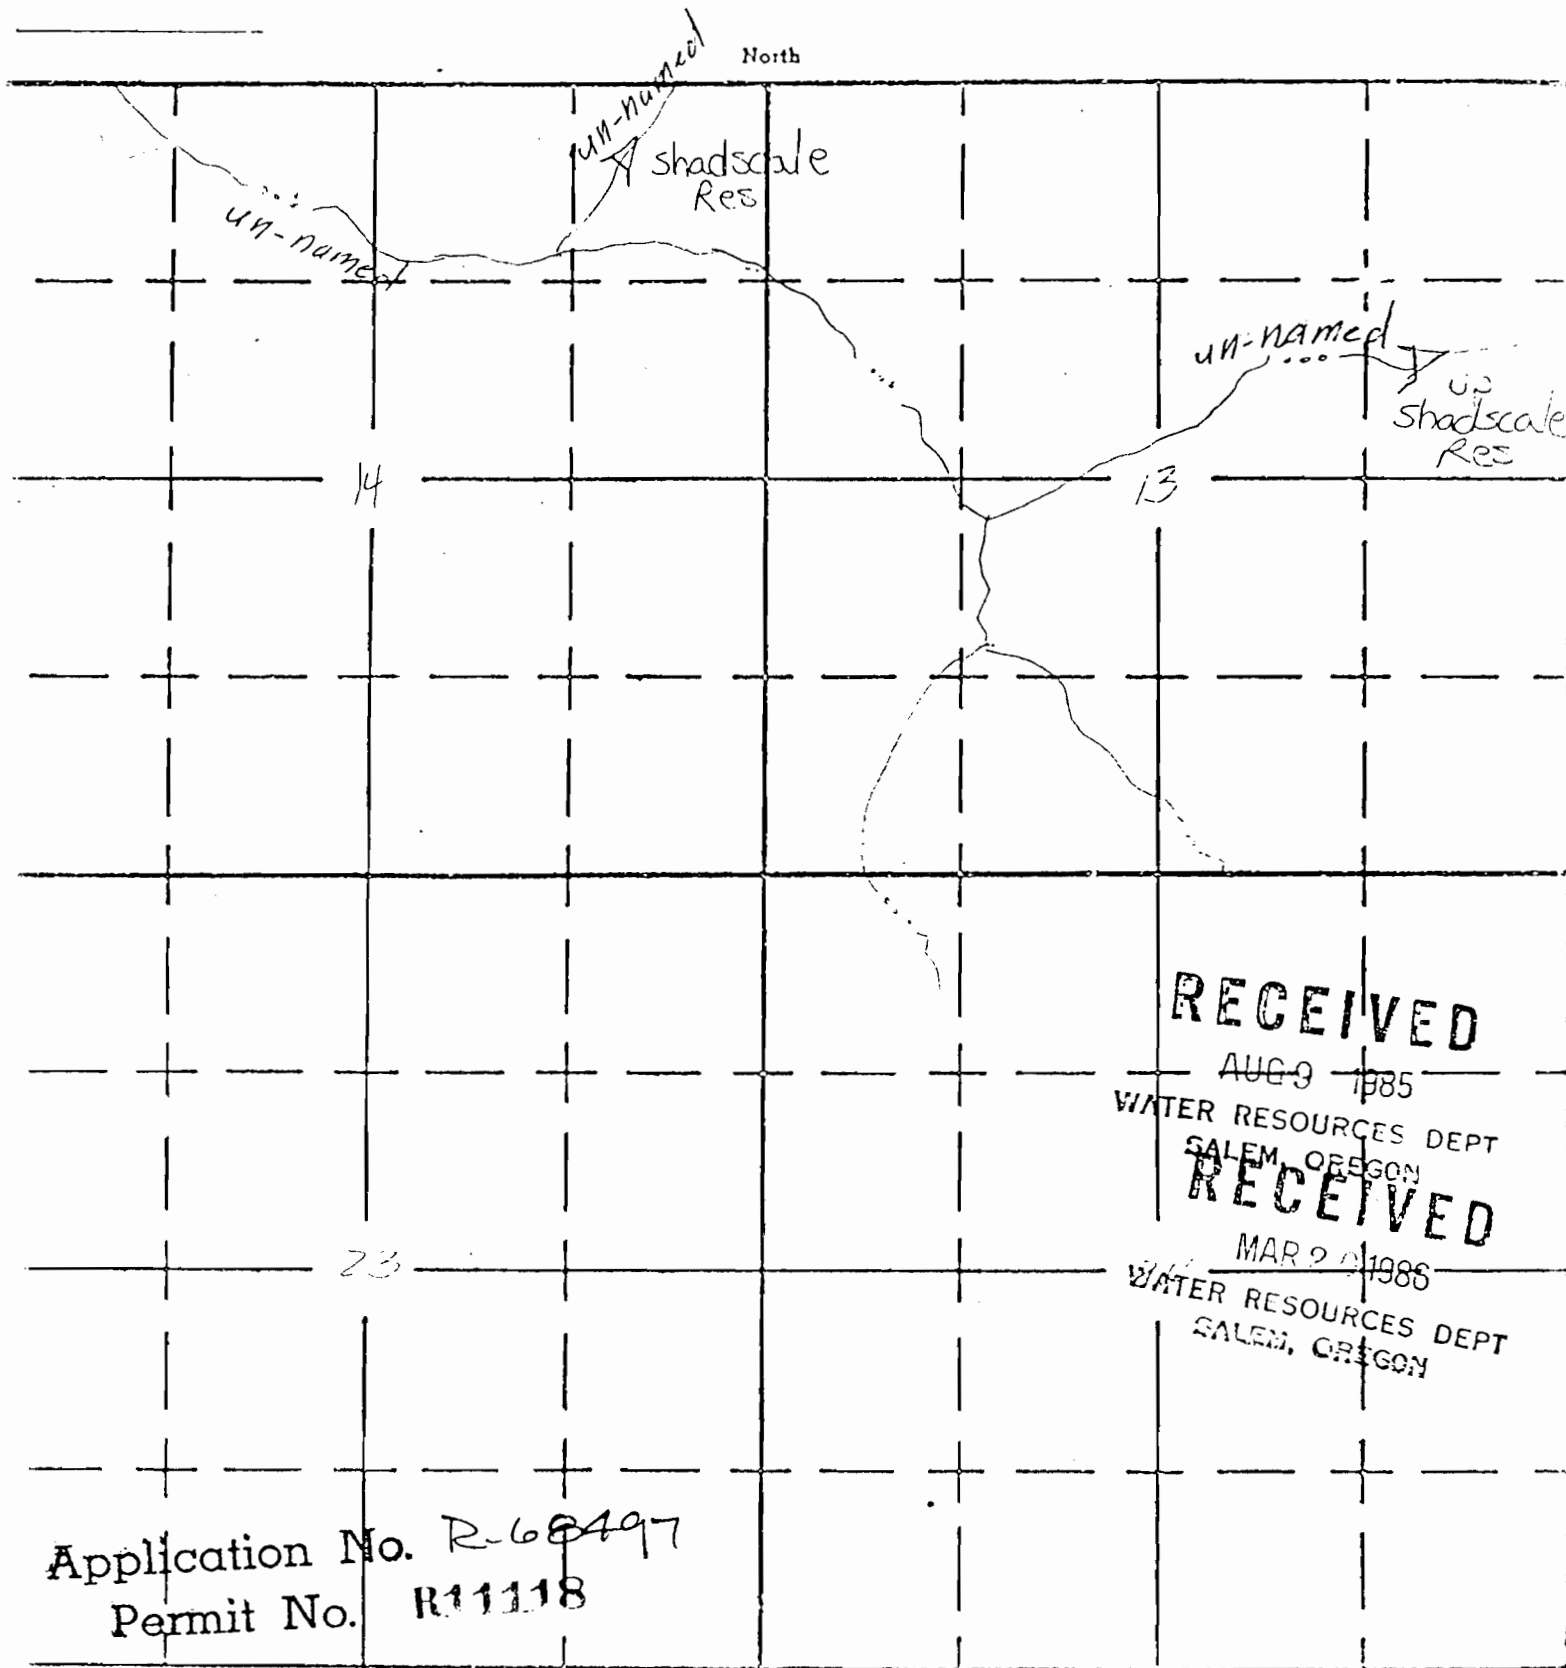

RECEIVED

AUG 9 1985

WATER RESOURCES DEPT
SALEM, OREGON

RECEIVED

MAR 20 1986

WATER RESOURCES DEPT
SALEM, OREGON

Application No. R-68497
Permit No. R11118

APPLICATION No.