


SECTION

27 SW SW
31 NESW
28 SESE

TOWNSHIP 33 S, RANGE 36 E, W. M.

10-#5409
Ed Davis Res. #2
10-5274 Phil Res
10-5408 Ed Davis Res #1

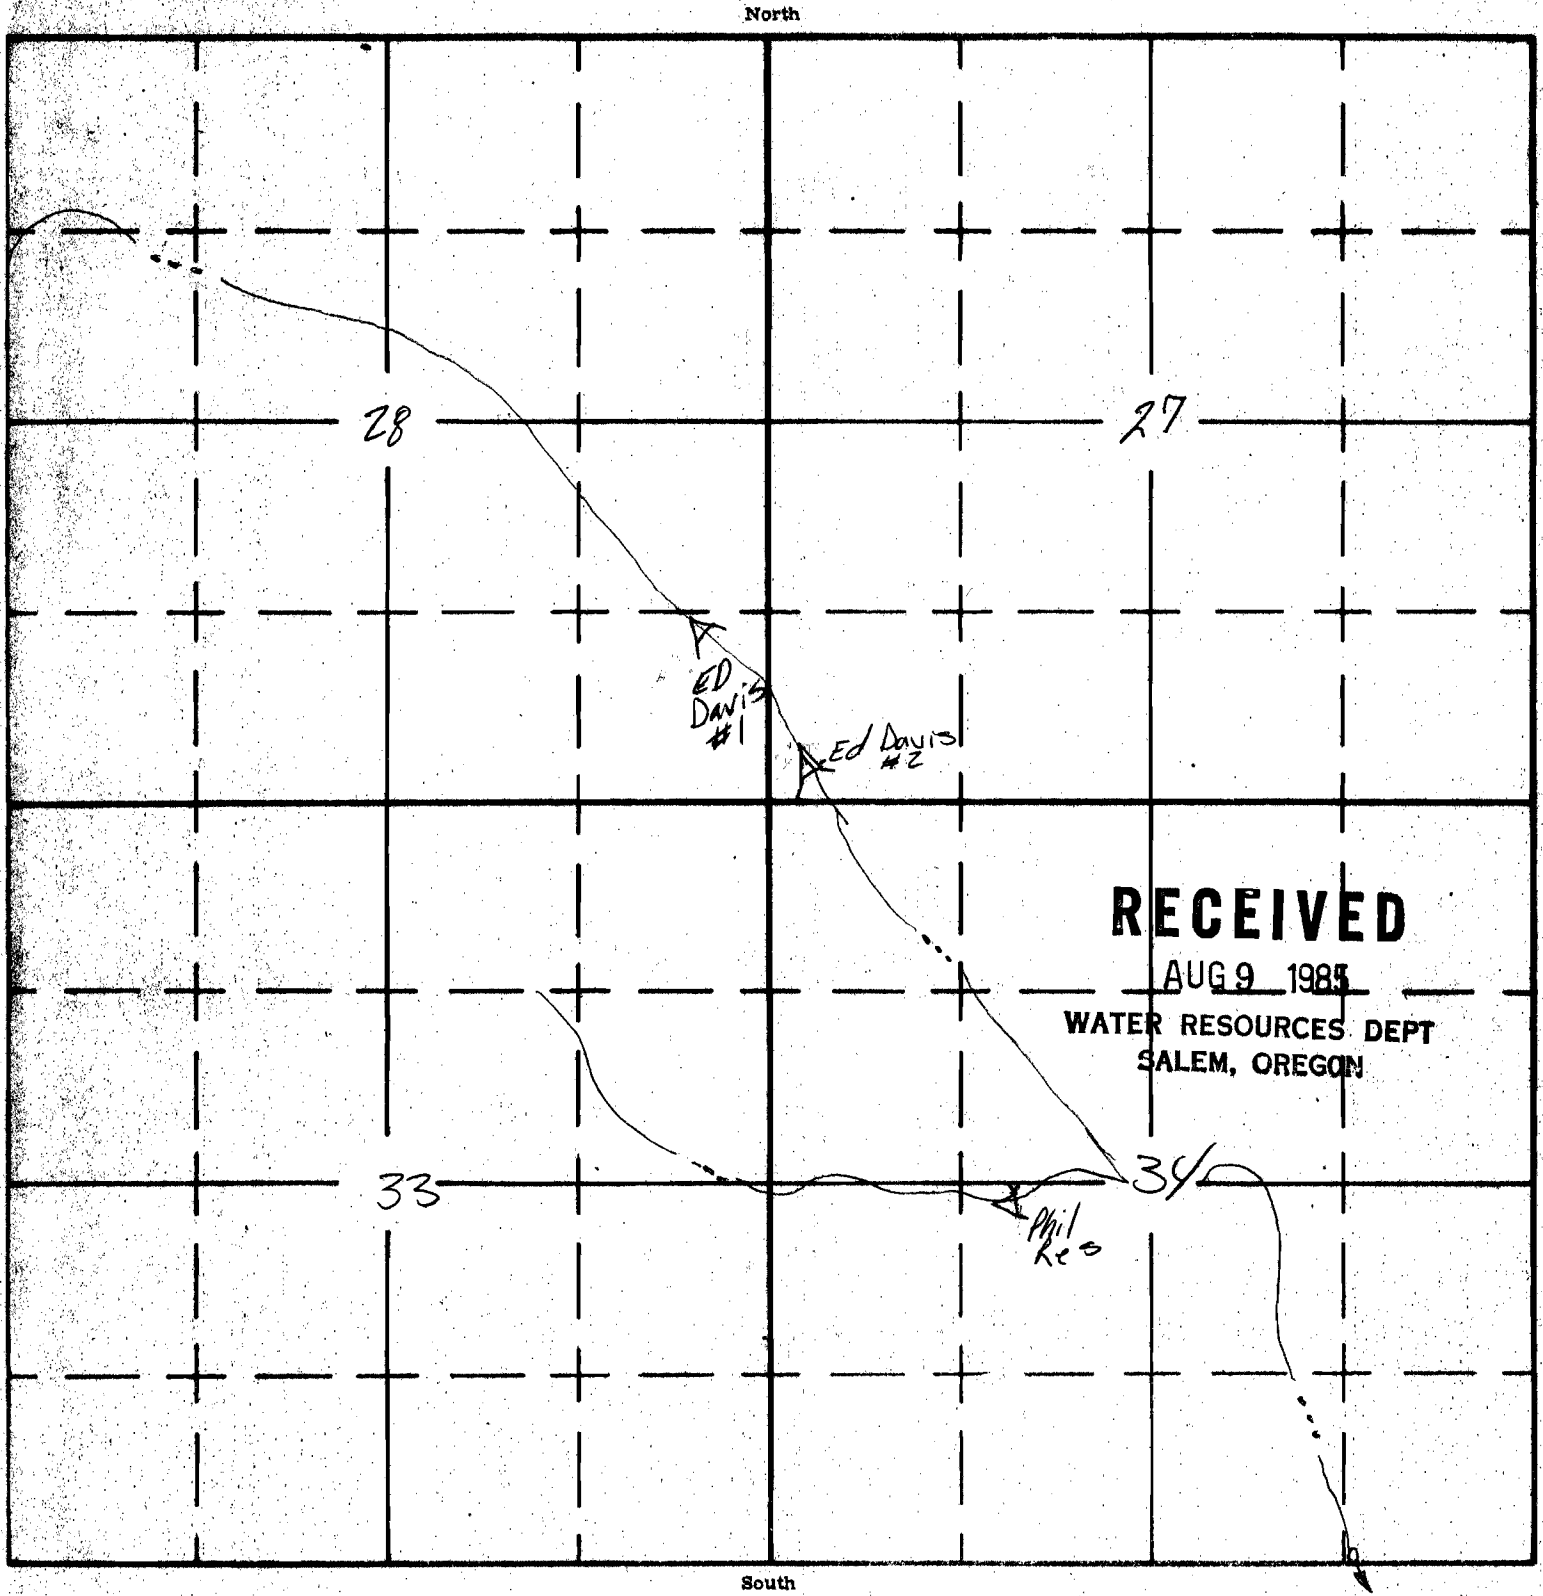

APPLICATION NO R-68509
PERMIT NQ R11120

RECEIVED
MAR 20 1986
WATER RESOURCES DEPT
SALEM, OREGON