


36 NESW
36 NESE

TOWNSHIP 31 S, RANGE 28 E, W. M.

08-#5563
Buckhorn Spr. Res.
08-#5562
Buckhorn Canyon Res.

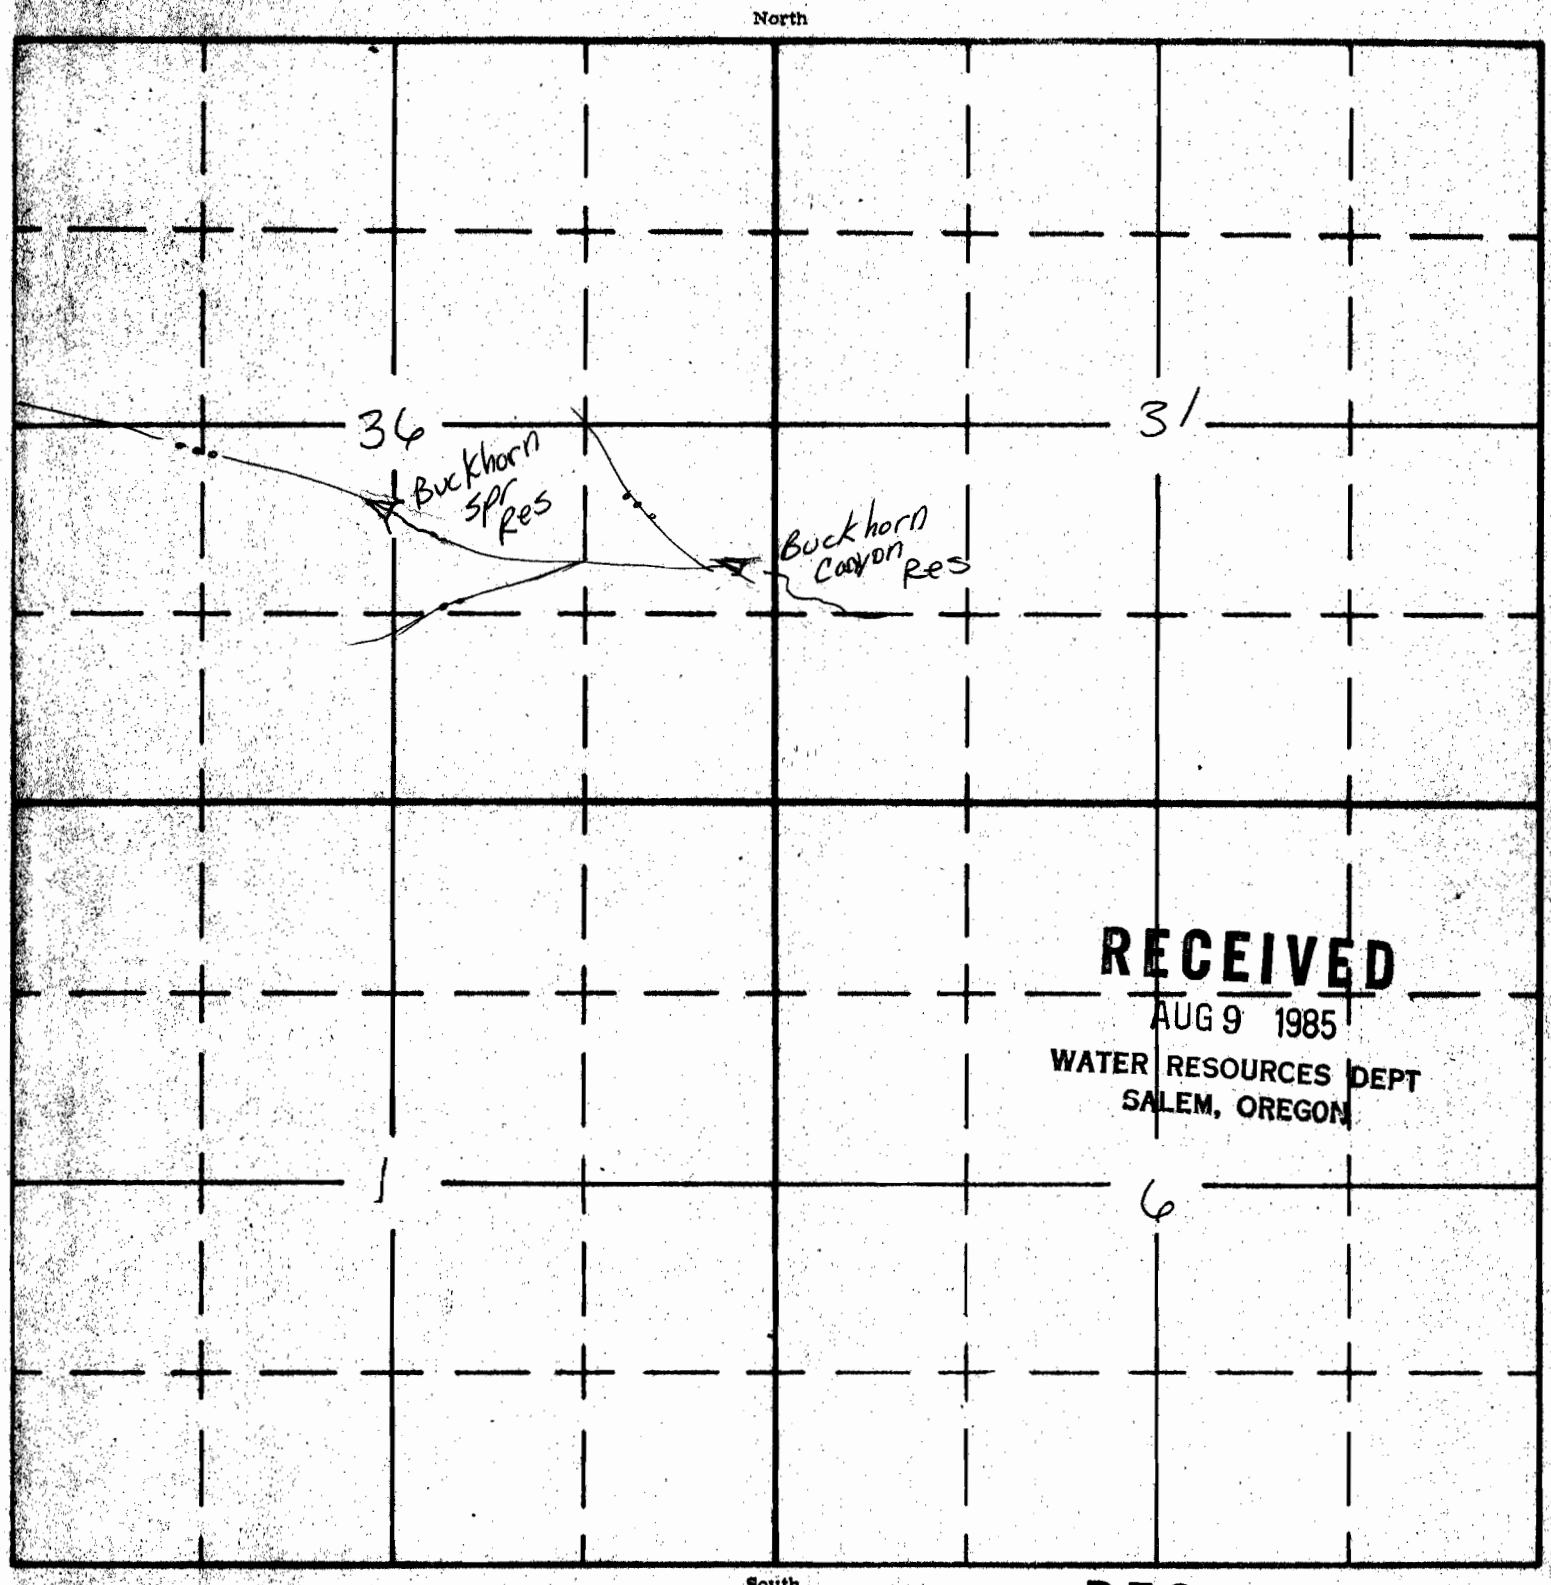

APPLICATION NO R-68510

PERMIT NQ

R11121

RECEIVED

MAR 20 1986

WATER RESOURCES DEPT

SALEM, OREGON