


SECTION

16 NE SE
16 NW NE

TOWNSHIP 33^S, RANGE 32^E, W. M.

09-5553
State pickup #1
09-5554
State pickup #2

North

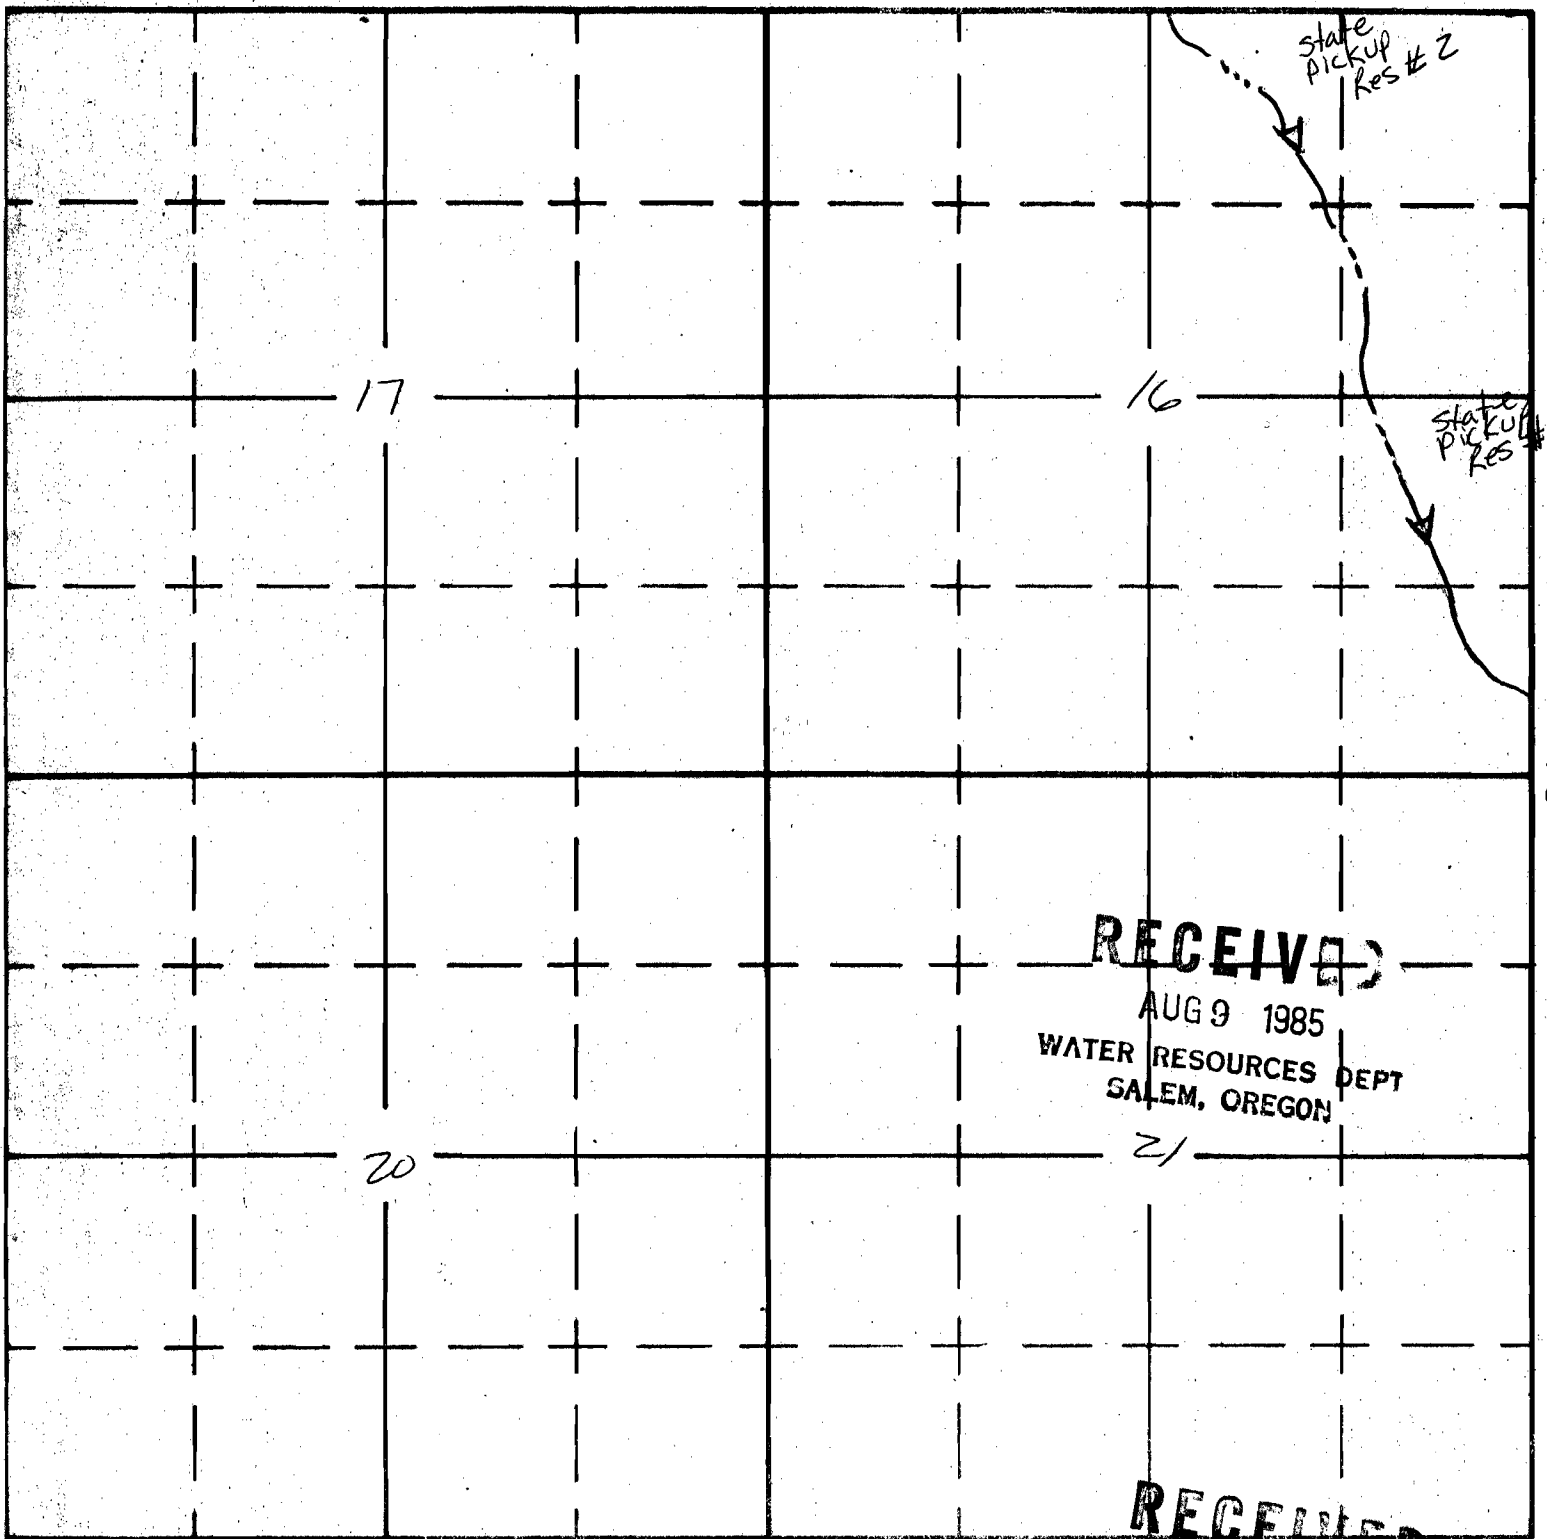

East

RECEIVED

AUG 9 1985
WATER RESOURCES DEPT
SALEM, OREGON

RECEIVED

MAR 20 1986
WATER RESOURCES DEPT
SALEM, OREGON

APPLICATION NO R-68528

PERMIT NQ

R11123