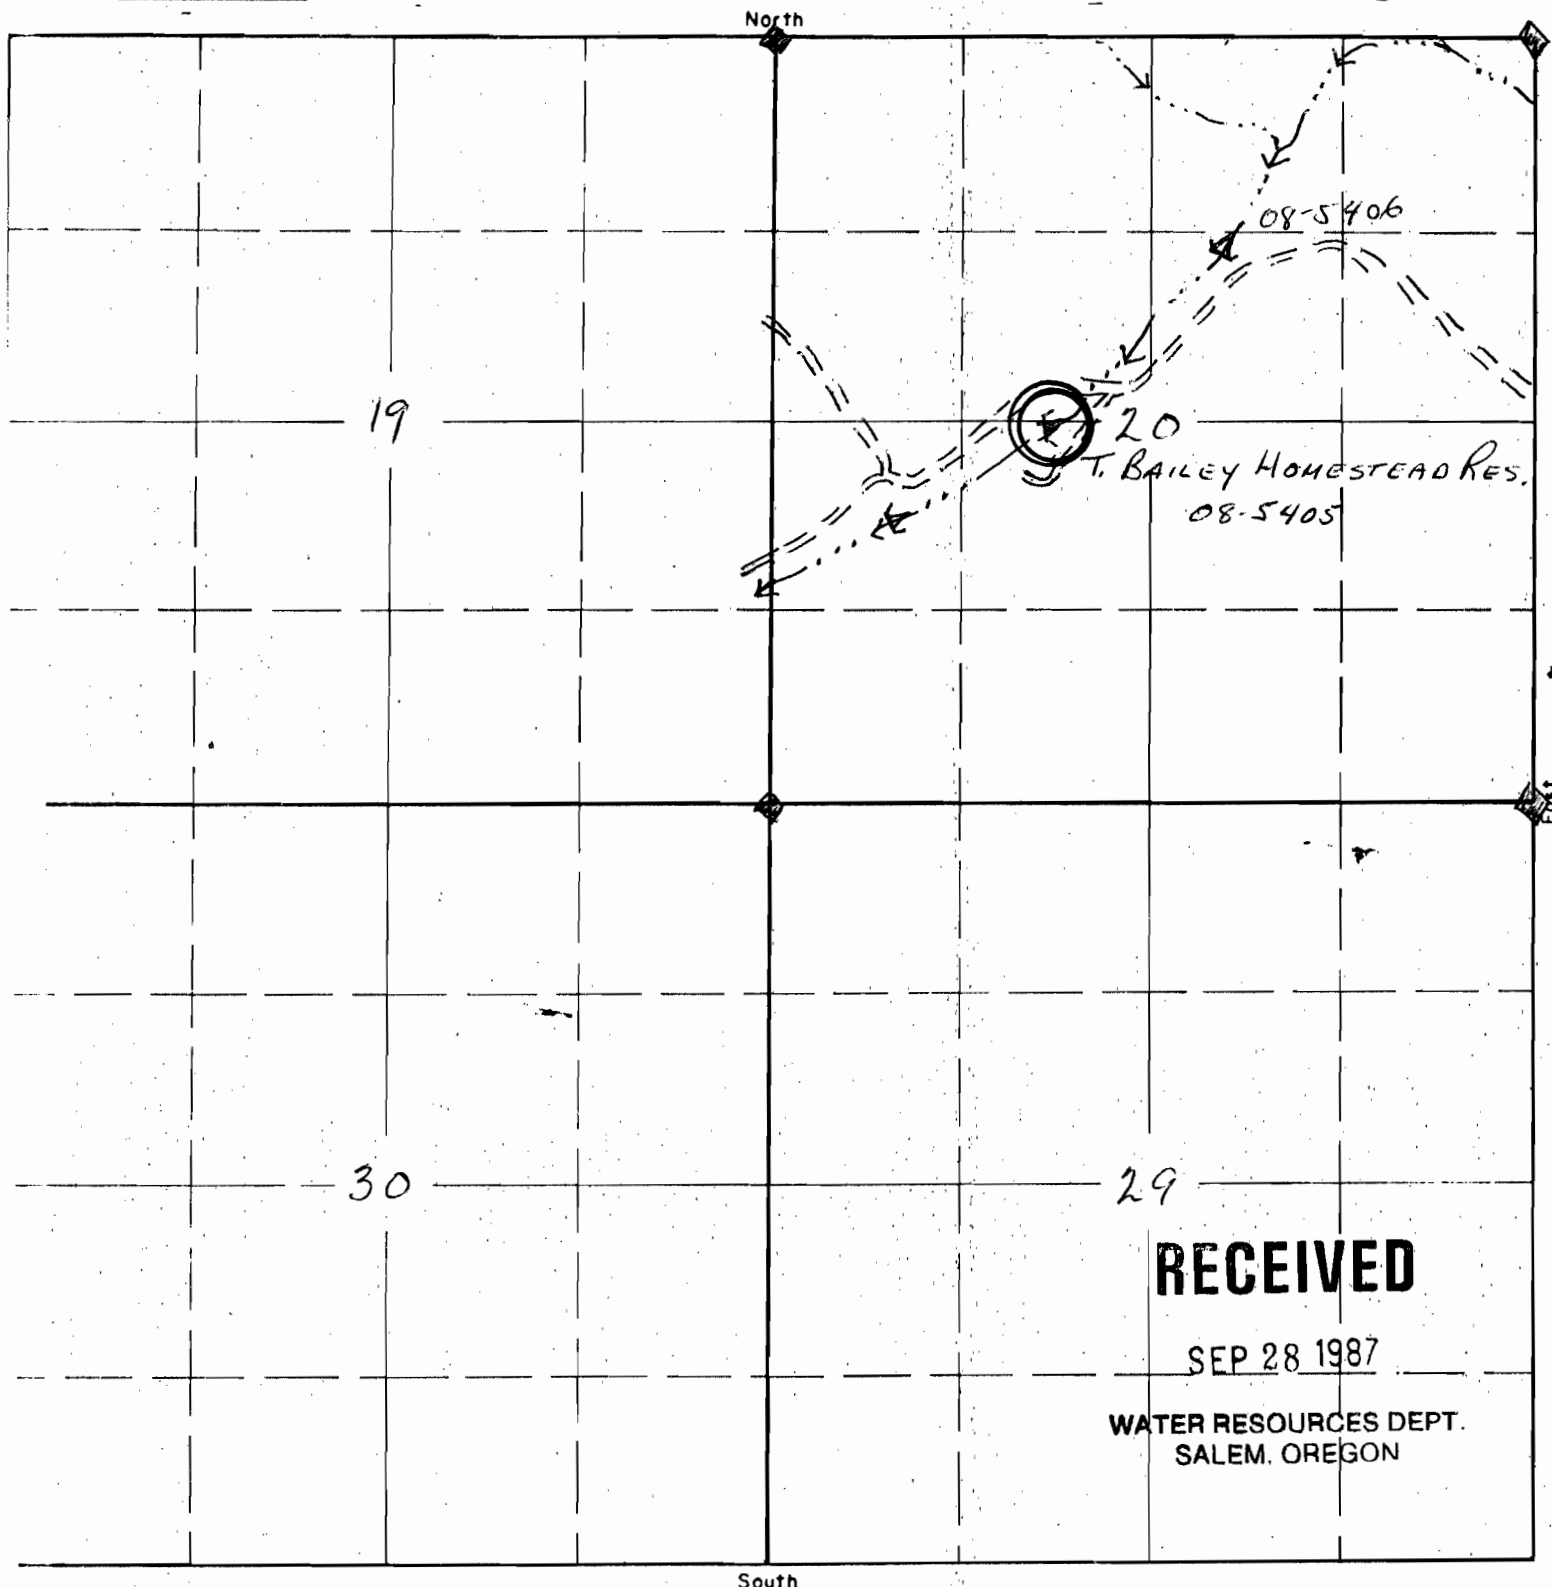


SECTION

20NESWTOWNSHIP 31S, RANGE 32E, W.M.**RECEIVED**

SEP 28 1987

WATER RESOURCES DEPT.
SALEM, OREGON

South

U.S. DEPARTMENT OF INTERIOR
BUREAU OF LAND MANAGEMENTBURNS, ORT. BAILEY HOMESTEAD RES.08-5405LOCATION: 2600' N AND 1880' E
FROM THE SW CORNER OF
SEC. 20FROM USGS 7.5' TOPOG
(FRENCH GLEN)

APPLICATION No.


R-69337

PERMIT No.

R11126

G. GETTY 9-5-87

SECTION

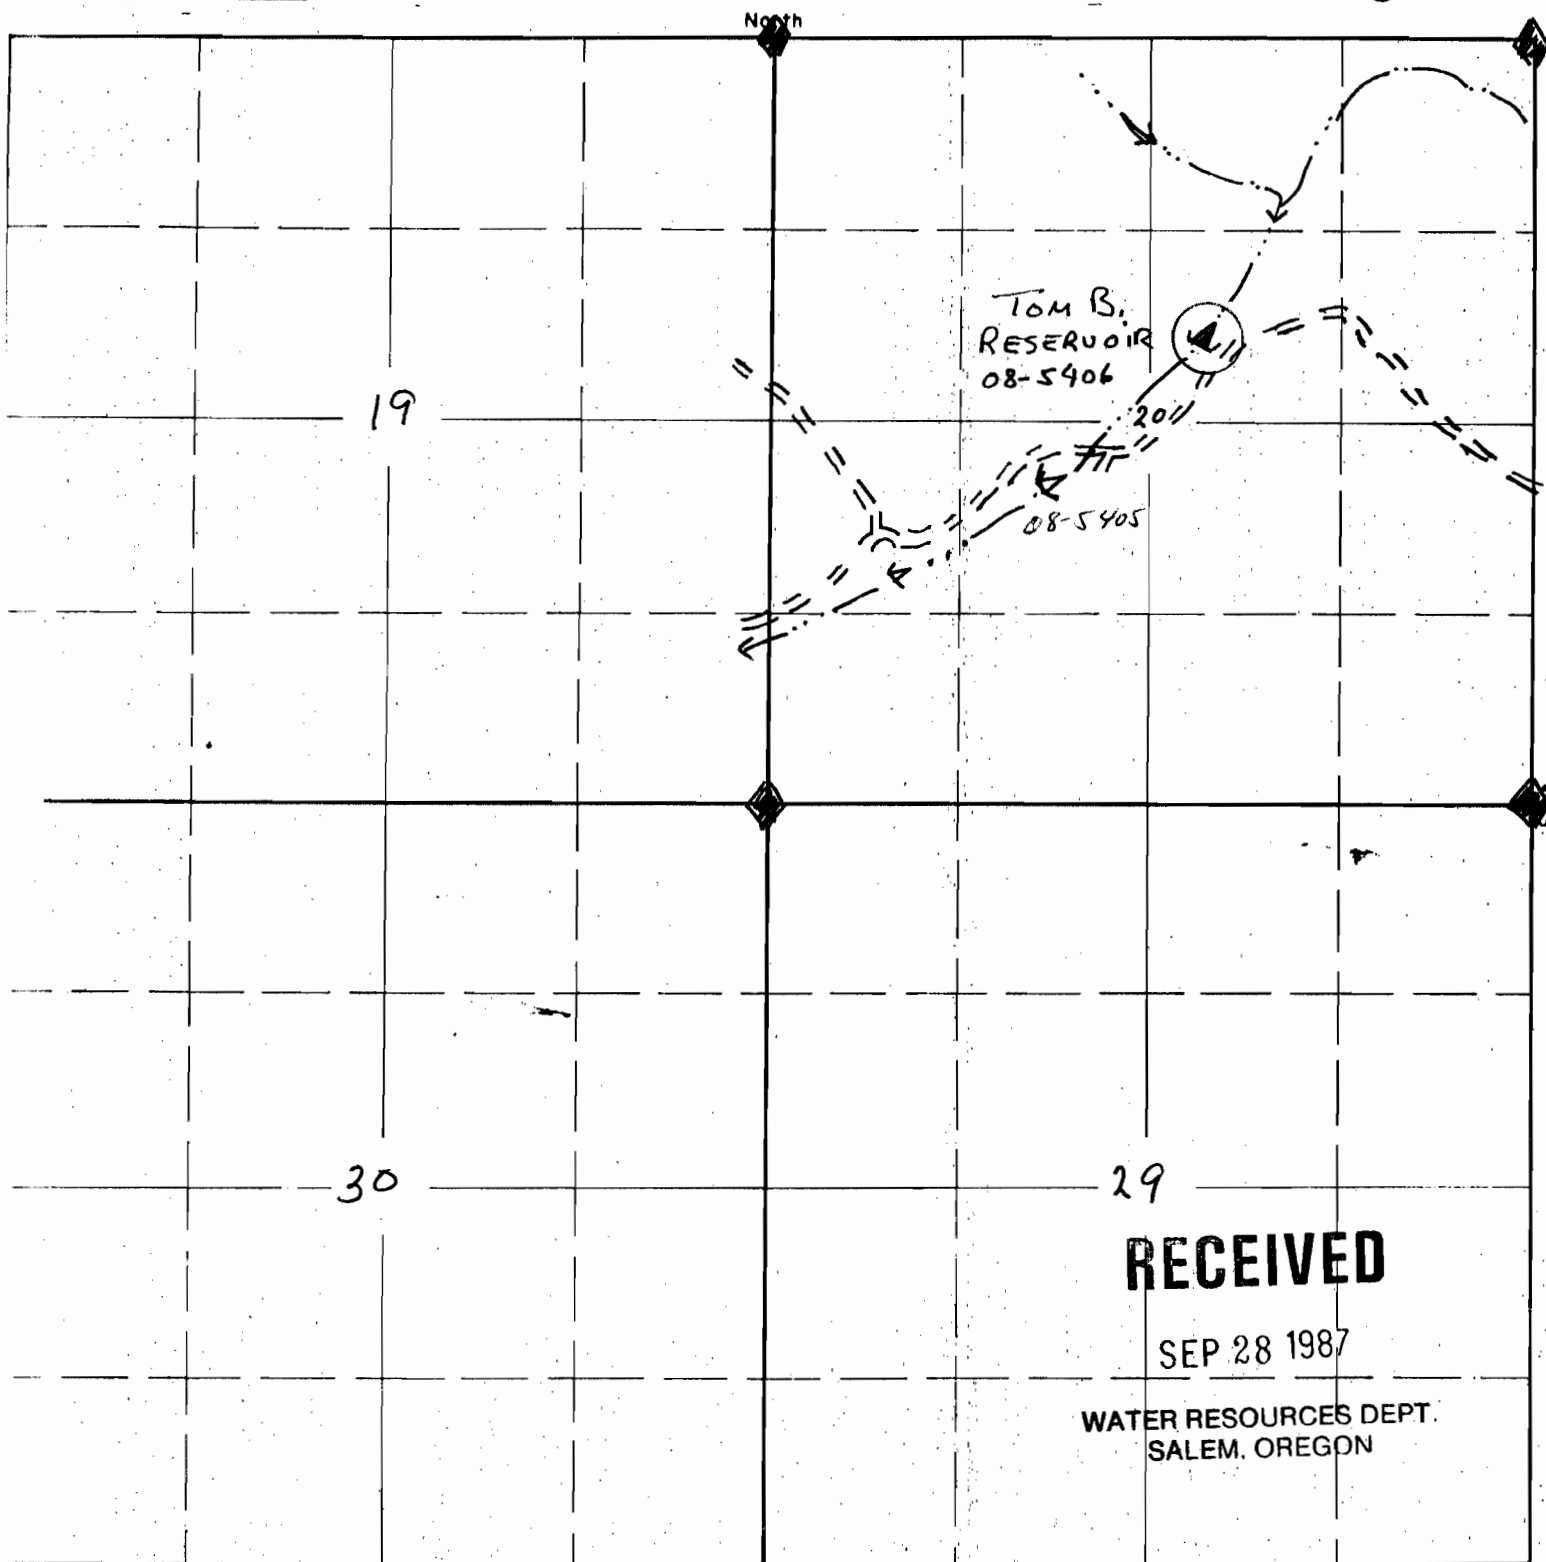20SWNETOWNSHIP 31S, RANGE 32E, W.M.**RECEIVED**

SEP 28 1987

WATER RESOURCES DEPT.
SALEM, OREGONU.S. DEPARTMENT OF INTERIOR
BUREAU OF LAND MANAGEMENTBURNS, ORTOM B. RESERVOIR08-5406LOCATION: 2100' S. AND 2200' W
FROM THE NE CORNER OF
SEC. 20FROM USGS 7.5' TOPOG
(FRENCH GLEN)

APPLICATION NO.

PERMIT NO.

R-69337
R11126