

SECTION

34

SWSW

TOWNSHIP 30 S , RANGE 33 E , W.M.



North

34

East

RECEIVED

SEP 28 1987

WATER RESOURCES DEPT.
SALEM, OREGON

South

U.S. DEPARTMENT OF INTERIOR
BUREAU OF LAND MANAGEMENT
BURNS OREGON

Flat Dike Reservoir
09-5657

LOCATION: 200 Ft N and 1000 Ft E
from the SW corner of
Sec. 34.

APPLICATION No. R-69384

From USGS 7.5' Quad (Krumbs Ridge)

PERMIT No. R11063

SECTION

34

SE SW

TOWNSHIP 30 S , RANGE 33 E , W.M.



North

34

West

East

South

U.S. DEPARTMENT OF INTERIOR
BUREAU OF LAND MANAGEMENT
Burns Oregon

Closed Road Dugout
09-5656

LOCATION: 400' N and 2300' E
From The SW Corner of
Sec. 34

From USGS 7.5' Topog
(Krumbo Ridge)

APPLICATION NO. R-69384

PERMIT NO. R11062

RECEIVED

SEP 28 1987

WATER RESOURCES DEPT.
SALEM, OREGON


Section

8

NW NE

TOWNSHIP 31S, RANGE 33E, W.M.

North

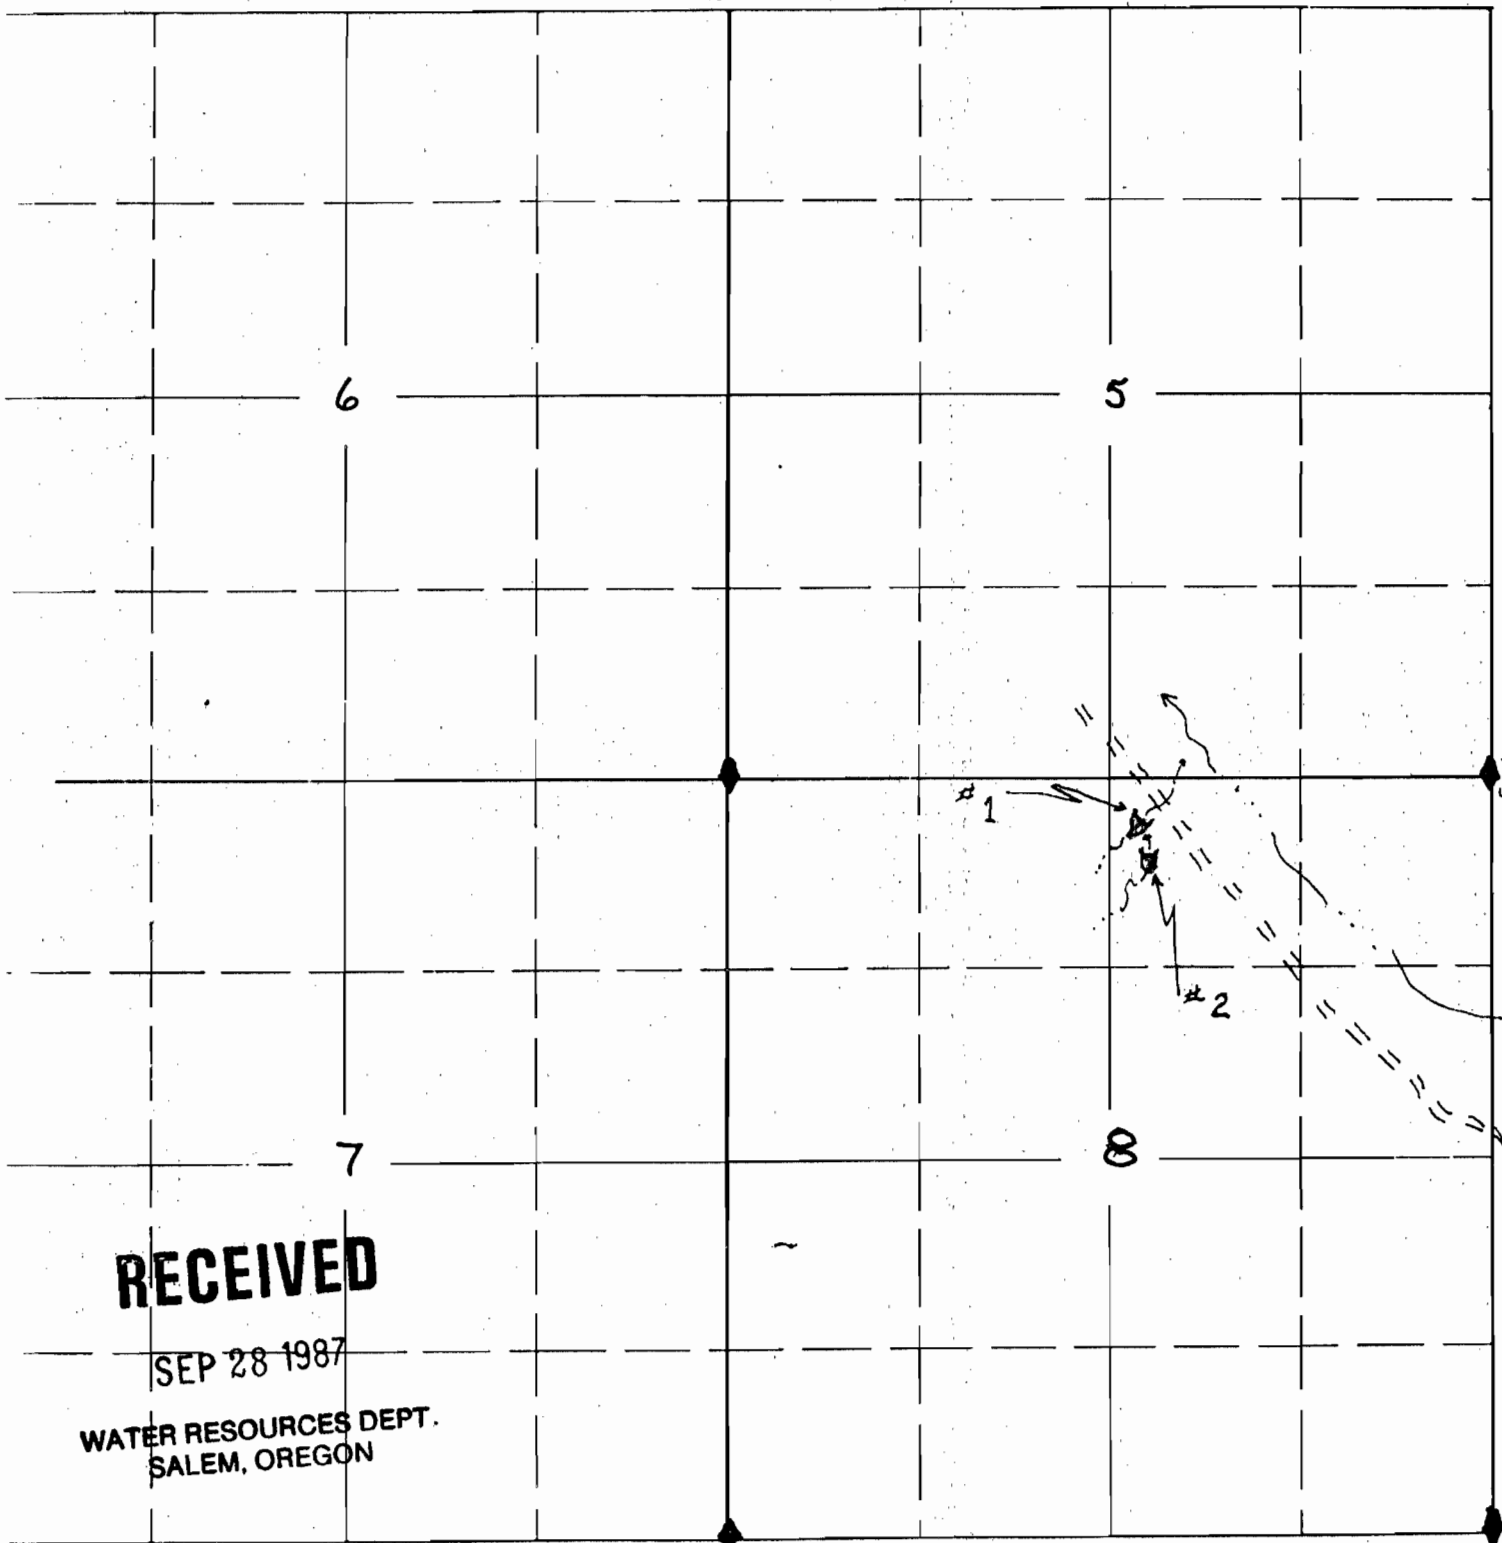

RECEIVED

SEP 28 1987

WATER RESOURCES DEPT.
SALEM, OREGON

South

DEPARTMENT OF INTERIOR
BUREAU OF LAND MANAGEMENT
Double Dugout 1 and 2
09-5658

LOCATION: #1)- 640'S and 1900'W ,
#2)- 400'S and 1820'W From
The NE corner of Sec. 8
From USGS 7.5' Topog
(Poison Springs)

APPLICATION No. R-69384
PERMIT No. R11063

Betty 9-4-87

SECTION

9

NWSW

TOWNSHIP 31 S , RANGE 33 E , W.M.



North

8

9

17

16

RECEIVED

SEP 28 1987

WATER RESOURCES DEPT.
SALEM, OREGON

South

DEPARTMENT OF INTERIOR
BUREAU OF LAND MANAGEMENT
Burns, OregonRoad Spring Dugout
09-5659LOCATION: 2440' N and 286' E
From the SW Corner of
Section 9From USGS 7.5' Topog
(Poison Springs)

APPLICATION No.

R-69384

PERMIT No.

R11063


Getty 9-4-87

SECTION

9

SW SW

TOWNSHIP 31 S , RANGE 33 E , W.M.

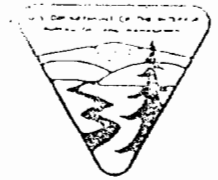

North

East

South

RECEIVED

SEP 28 1987

WATER RESOURCES DEPT.
SALEM, OREGONDEPARTMENT OF INTERIOR
BUREAU OF LAND MANAGEMENT
BURNS, OregonWet Meadow Waterhole
09 - 5661

LOCATION: 300' N and 840' E

From the SW corner of
Sec. 9From USGS 7.5' Topog
(Poison Springs)

APPLICATION NO.

R-69384

PERMIT NO.

R11063

SECTION


16

NWNW

TOWNSHIP 31 S, RANGE 33 E, W.M.



North

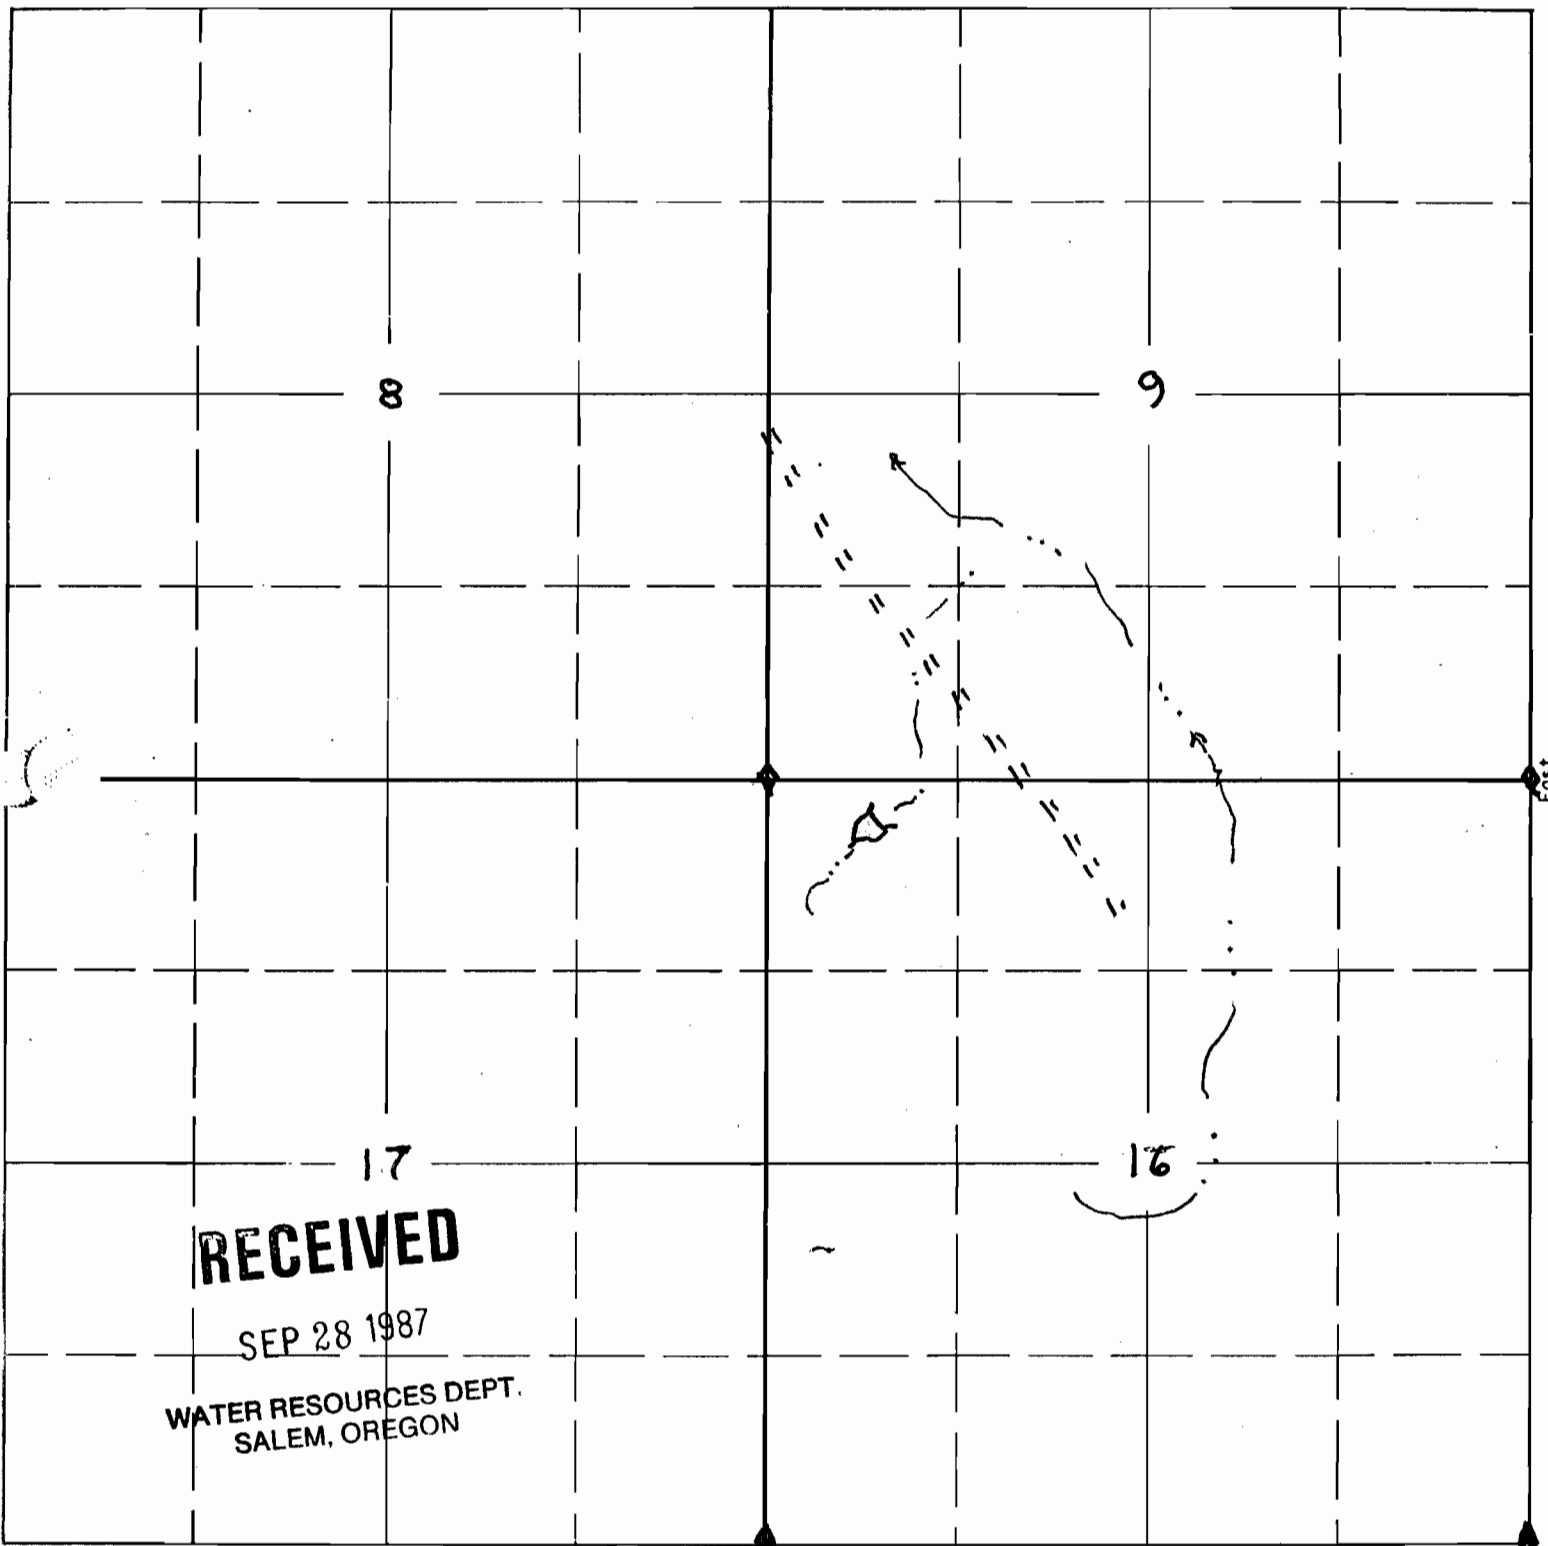

RECEIVED

SEP 28 1987

WATER RESOURCES DEPT.
SALEM, OREGON

South

DEPARTMENT OF INTERIOR
BUREAU OF LAND MANAGEMENT
BURNS, OREGON

Otley Reservoir # 1
09-5660

LOCATION: 100' S and 1100' E
of The NW corner of
Section 16

from USGS 7.5' topog
(Poison Springs)

APPLICATION No.

R-69384

PERMIT No.

R11063