


Township 16,

Range

10TH

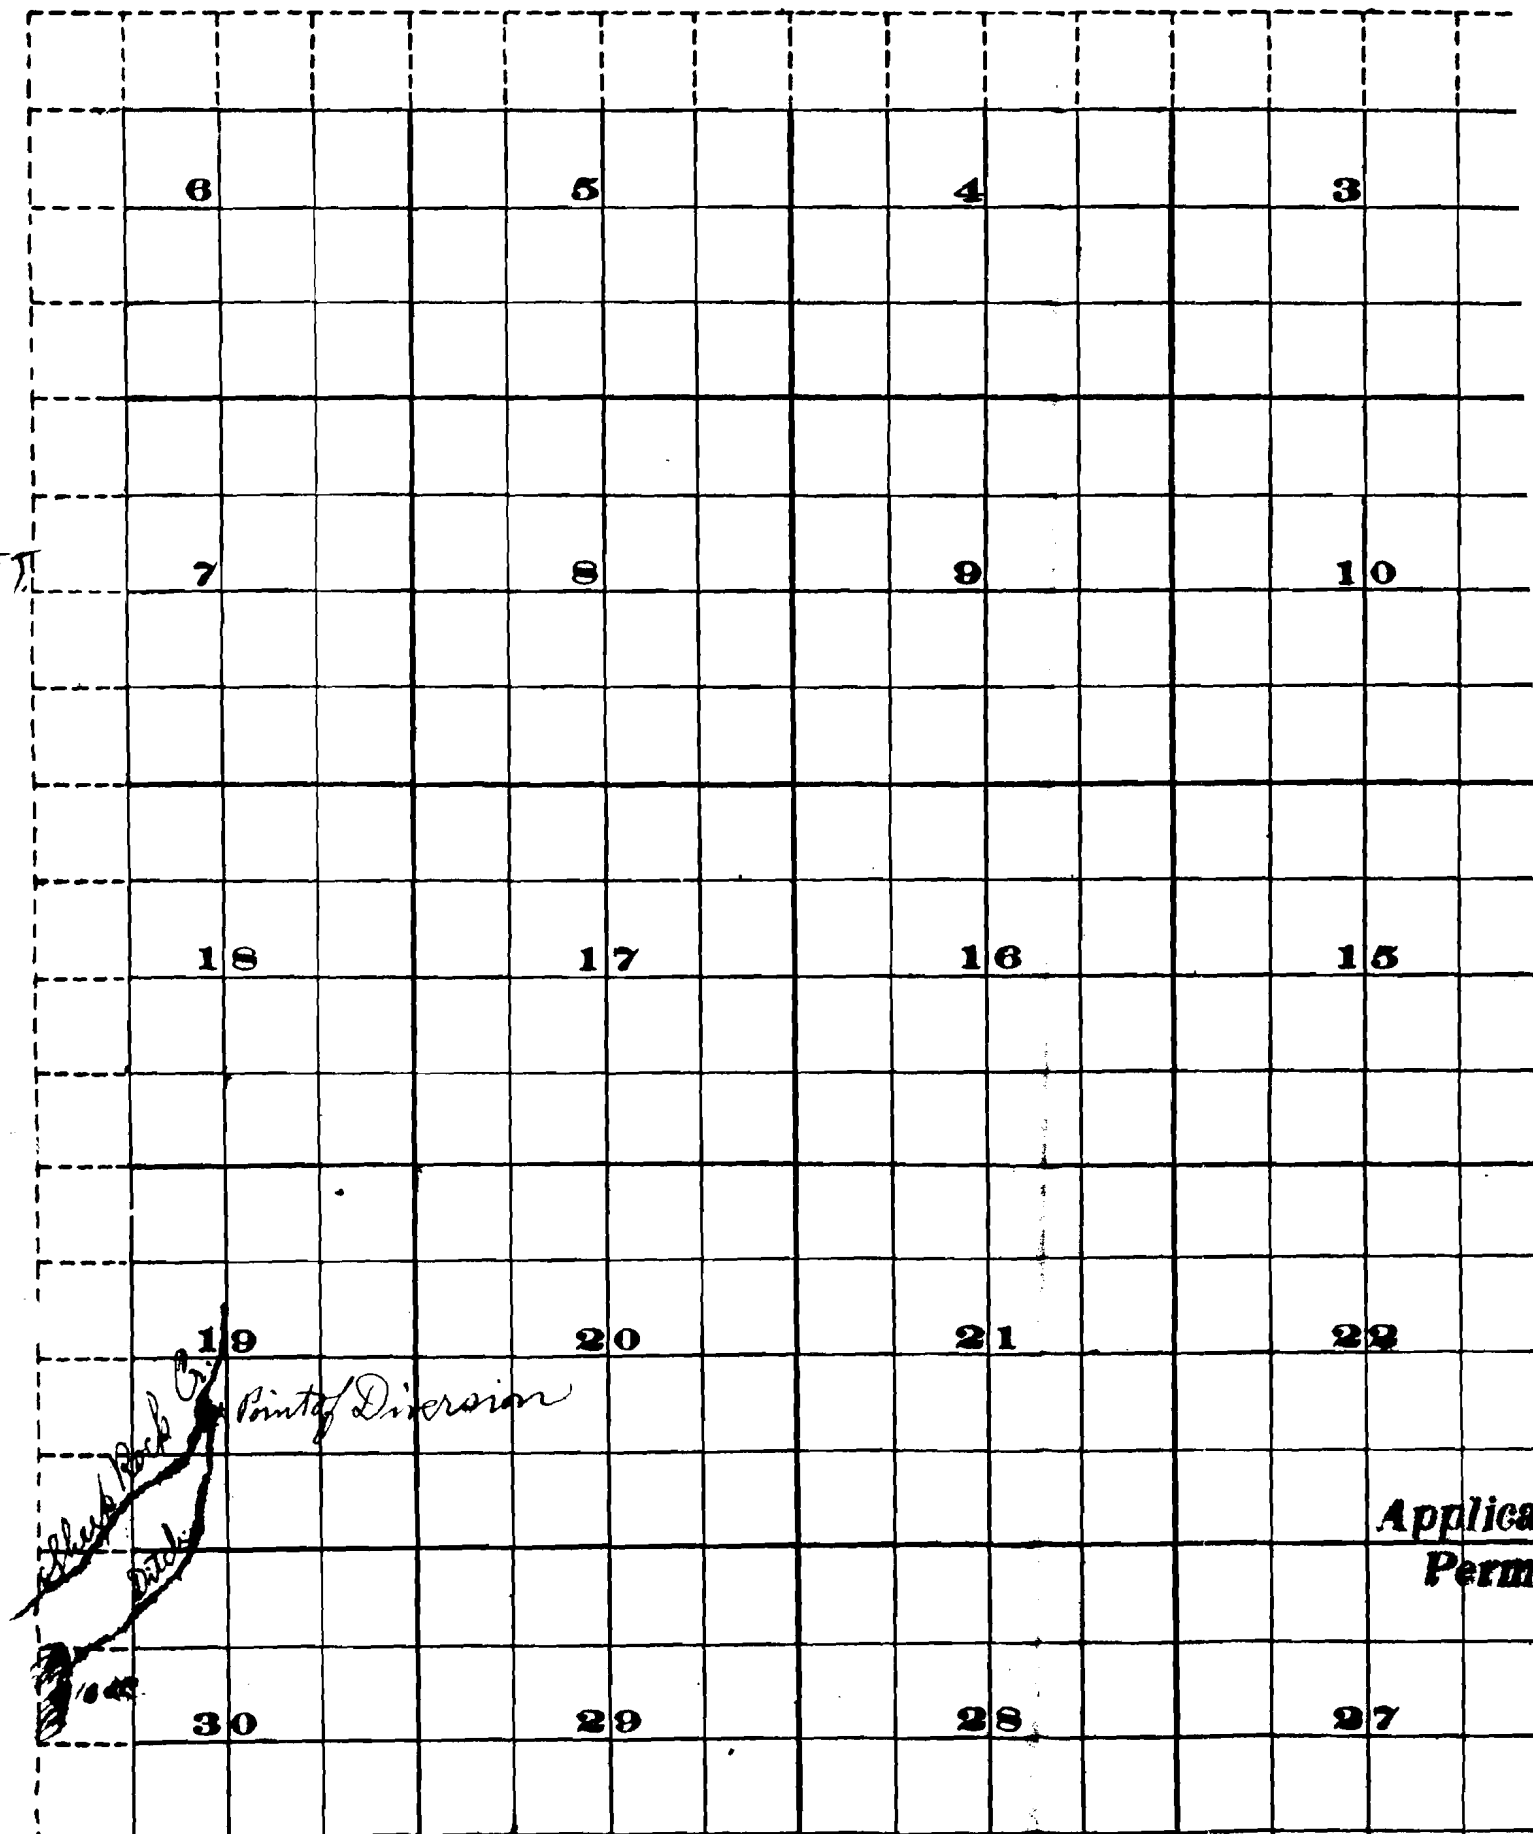

Applica
Perm