

WATER RIGHT MAP FOR LOCATION CHANGE


RECEIVED

NW1/4 SW1/4 SEC 21 T 23S R 38E W.M.

AUG - 1 1997

U.S.G.S. QUD - MOSQUITO MTN., OREG. - 7 1/2'



WATER RESOURCES DEPT.
SALEM, OREGON

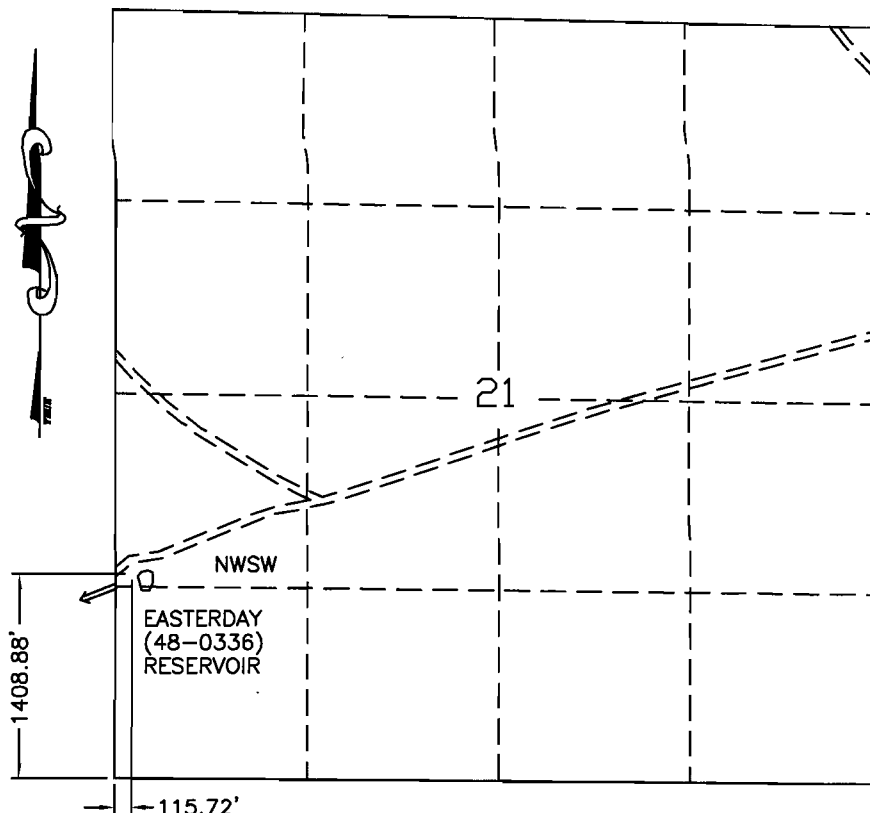

LEGEND

- RESERVOIR
- == ROAD
- CHANNEL

EASTERDAY (48-0336) RESERVOIR

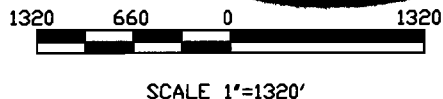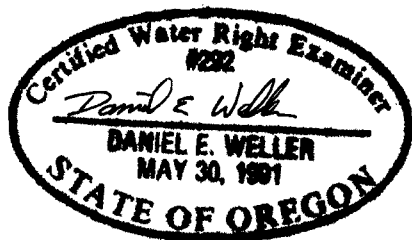

THIS MAP IS FOR THE PURPOSE OF LOCATING A WATER RIGHT AND IS NOT INTENDED TO PROVIDE LEGAL DIMENSIONS FOR LOCATION OF PROPERTY BOUNDARIES.

ACAD 13/SDESK
DWG FILEEASTERDY.DWG

UNITED STATES DEPARTMENT OF THE INTERIOR BUREAU OF LAND MANAGEMENT DIVISION OF OPERATIONS VALE DISTRICT	
EASTERDAY (48-0336) RESERVOIR	
DESIGNED	
REVIEWED	<i>Daniel E. Weller</i>
APPROVED	<i>[Signature]</i> CHIEF, BRANCH OF ENGINEERING
DRAWN: CG	SCALE: 1"=1320'
DATE: 12/17/96	SHEET 1 OF 1
DRAWING NO. OR-03-9172.45-946	

Form Al-187

March 1961

UNITED STATES

DEPARTMENT OF THE INTERIOR

BUREAU OF LAND MANAGEMENT

Application No. ^{R-72873}

Permit No. 20 NESE

Oregon State Water Filings



TOWNSHIP 23 S, RANGE 38 E, W. M.

CERTIFICATE NO.

68866

North

EASTERDAY

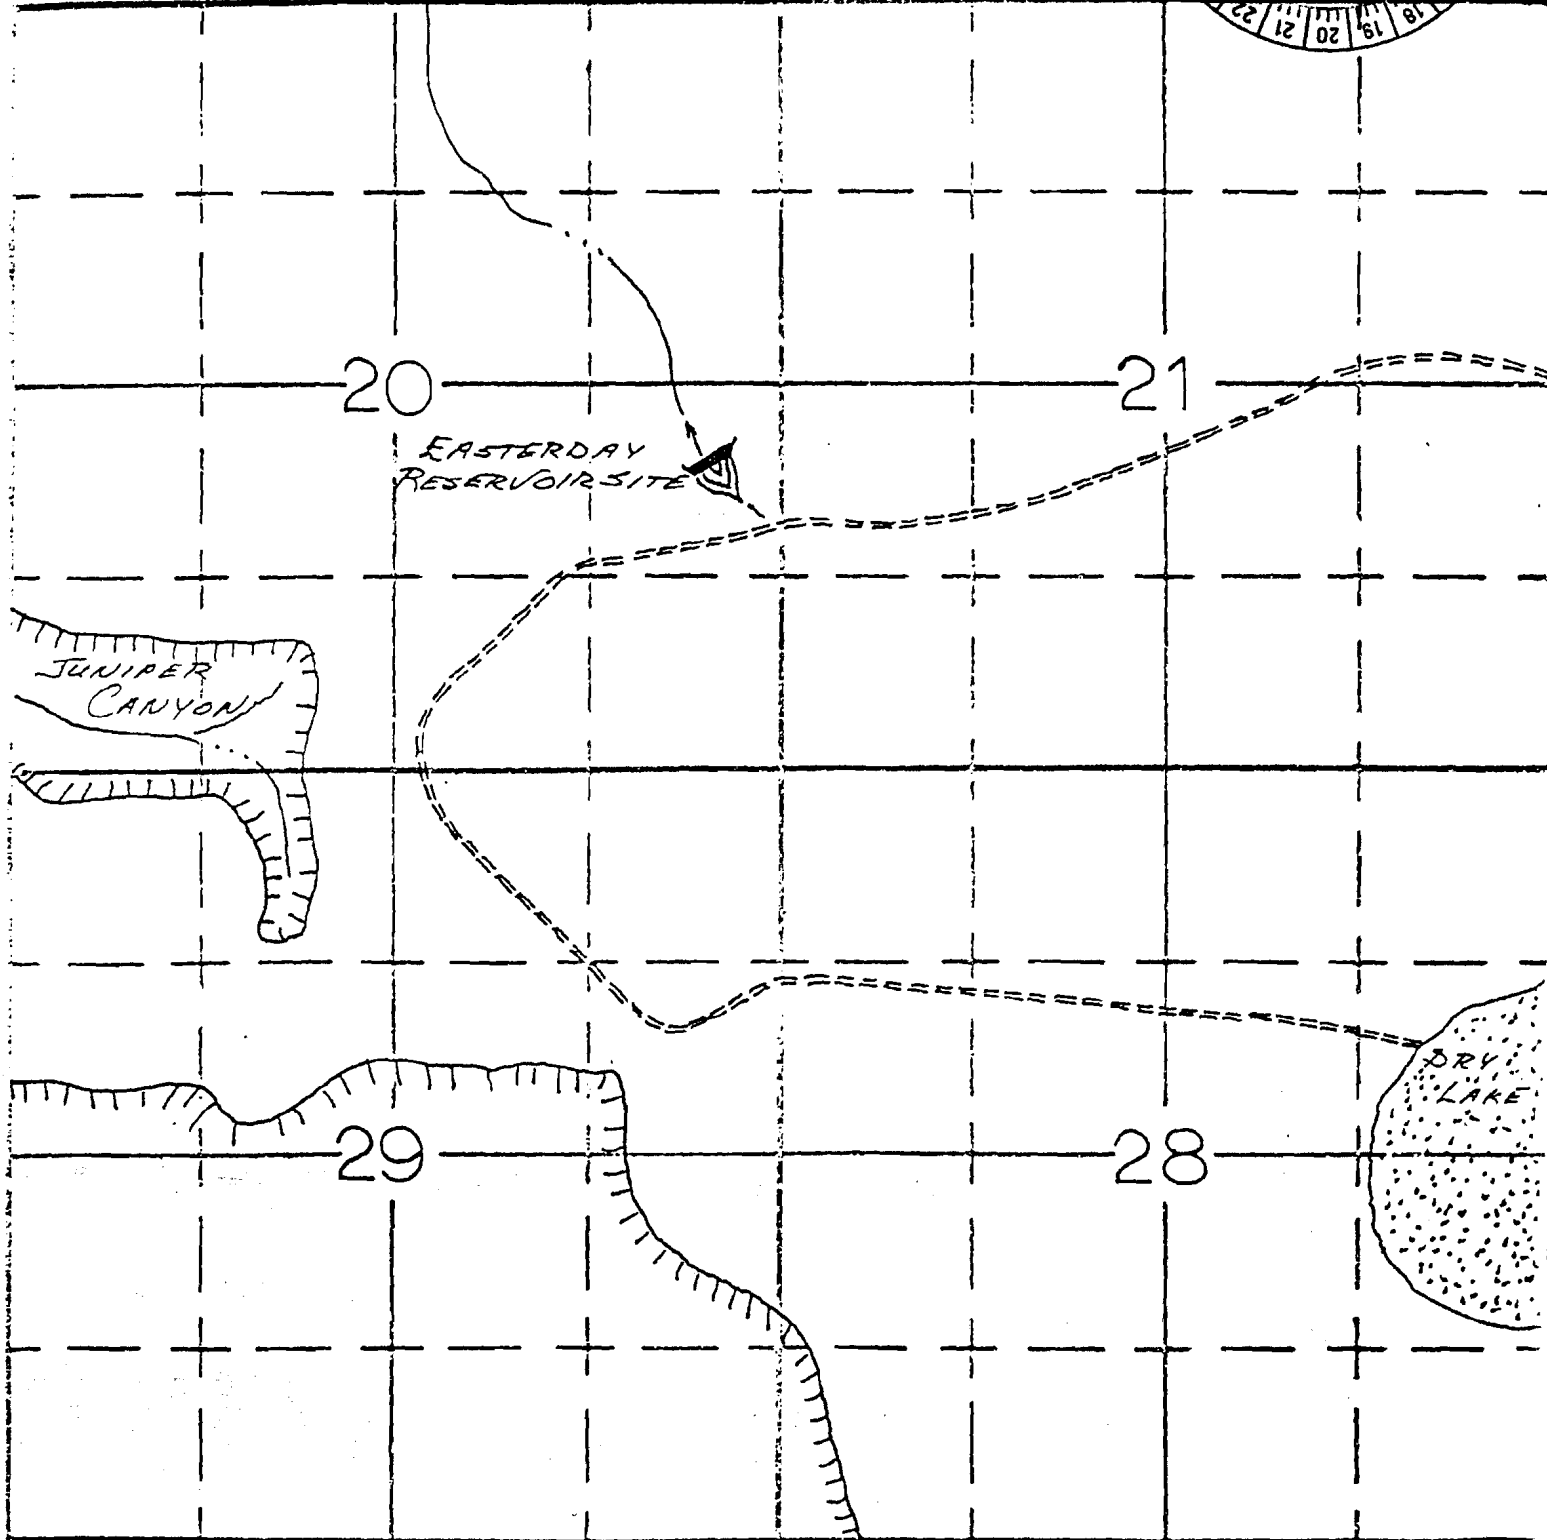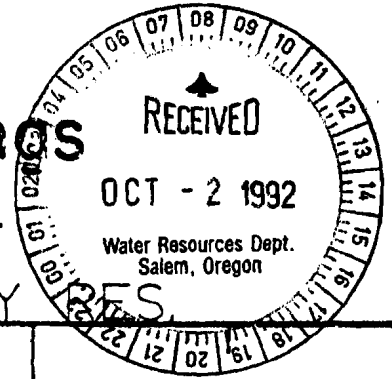

South

APPLICATION No. ^{R-6786}
PERMIT No. **R1068**