

RECEIVED

AUG - 1979

WATER RESOURCES DEPT
SALEM, OREGON


Application No. R-73574
Permit No.

T. 21 S. R. 44 E. W.M.

RECEIVED

AUG - 2 1993

WATER RESOURCES DEPT
SALEM, OREGON

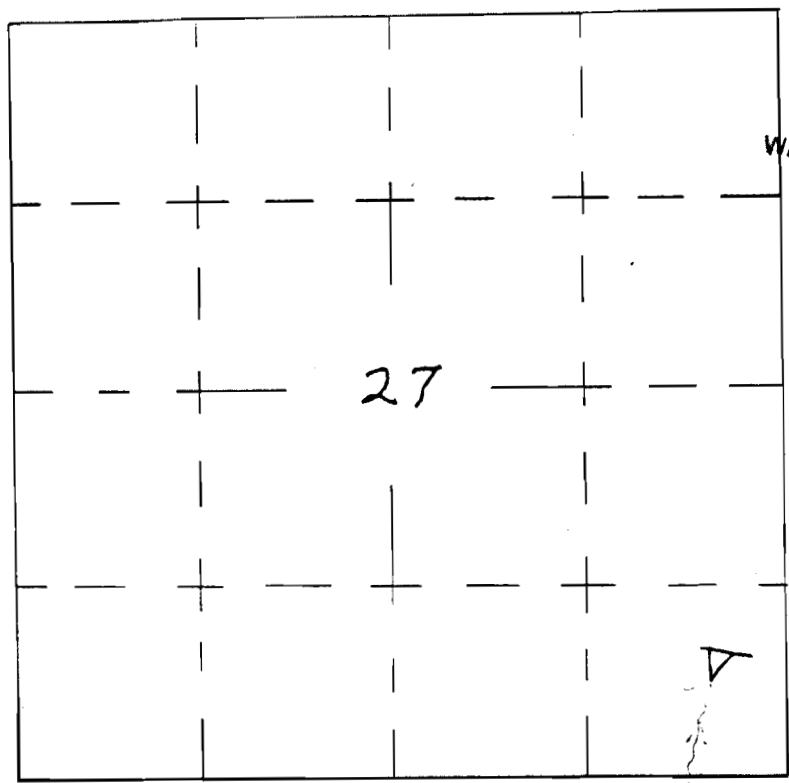

Application No. R59067
Permit No. R 8712

CERTIFICATE NO. 68939

U. S. DEPARTMENT OF THE INTERIOR BUREAU OF LAND MANAGEMENT	
SAGEBRUSH GULCH	
DESIGNED _____	RECOMM. _____
DRAWN _____	RECOMM. _____ CHIEF, DIV. OF ENG.
CHECKED _____	APPROVED _____
SCALE _____	
DATE _____	SHEET _____ OF _____
DRAWING NO. _____	