

Form A1-187
March 1961

UNITED STATES
DEPARTMENT OF THE INTERIOR
BUREAU OF LAND MANAGEMENT

SECTION

Oregon State Water Filings

S28


TOWNSHIP 31S, RANGE 43E., W. M.

RECEIVED

SEP 20 1993

WATER RESOURCES DEPT.
SALEM, OREGON

North

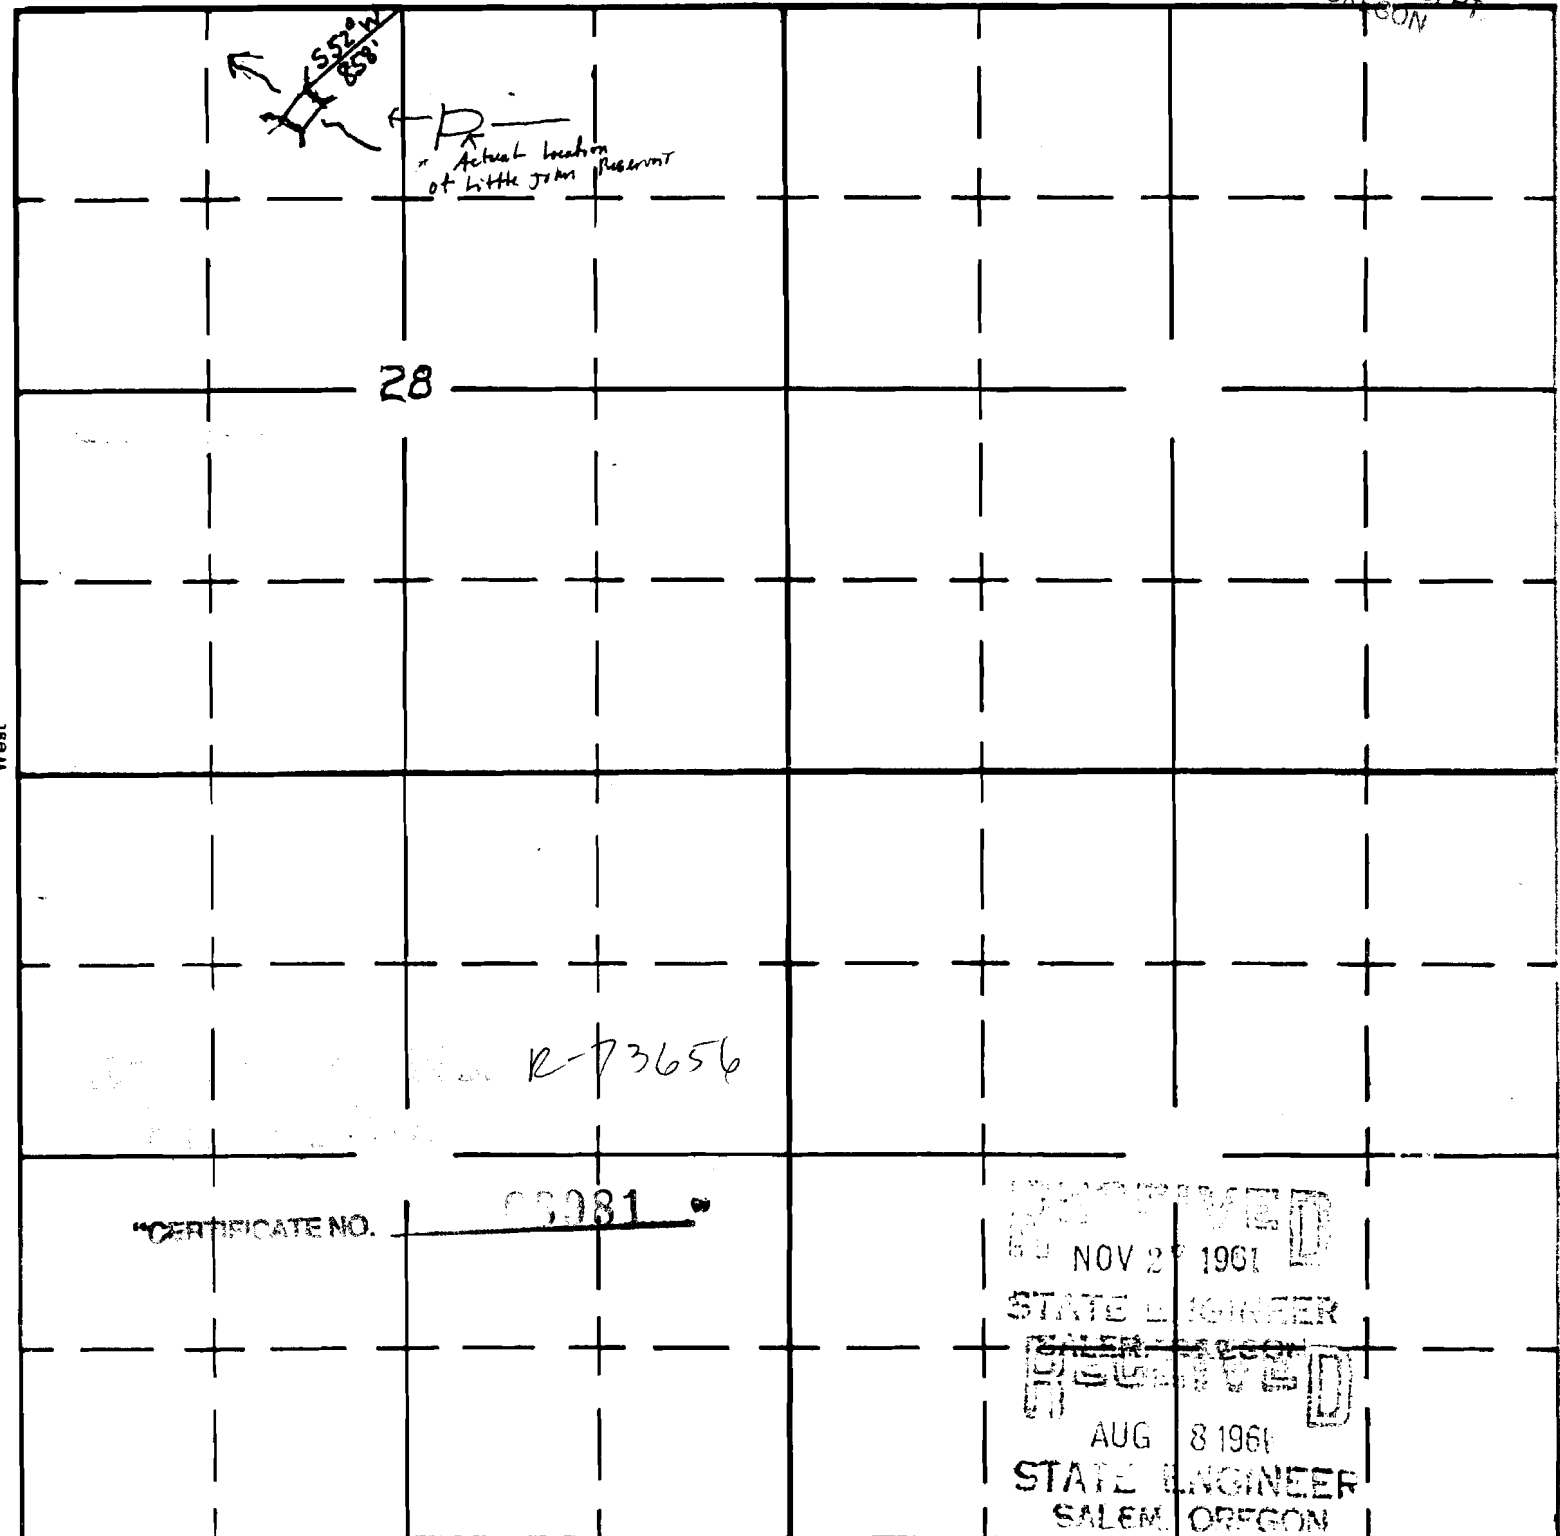

West

South

APPLICATION No. R-3661
PERMIT No. R-351