


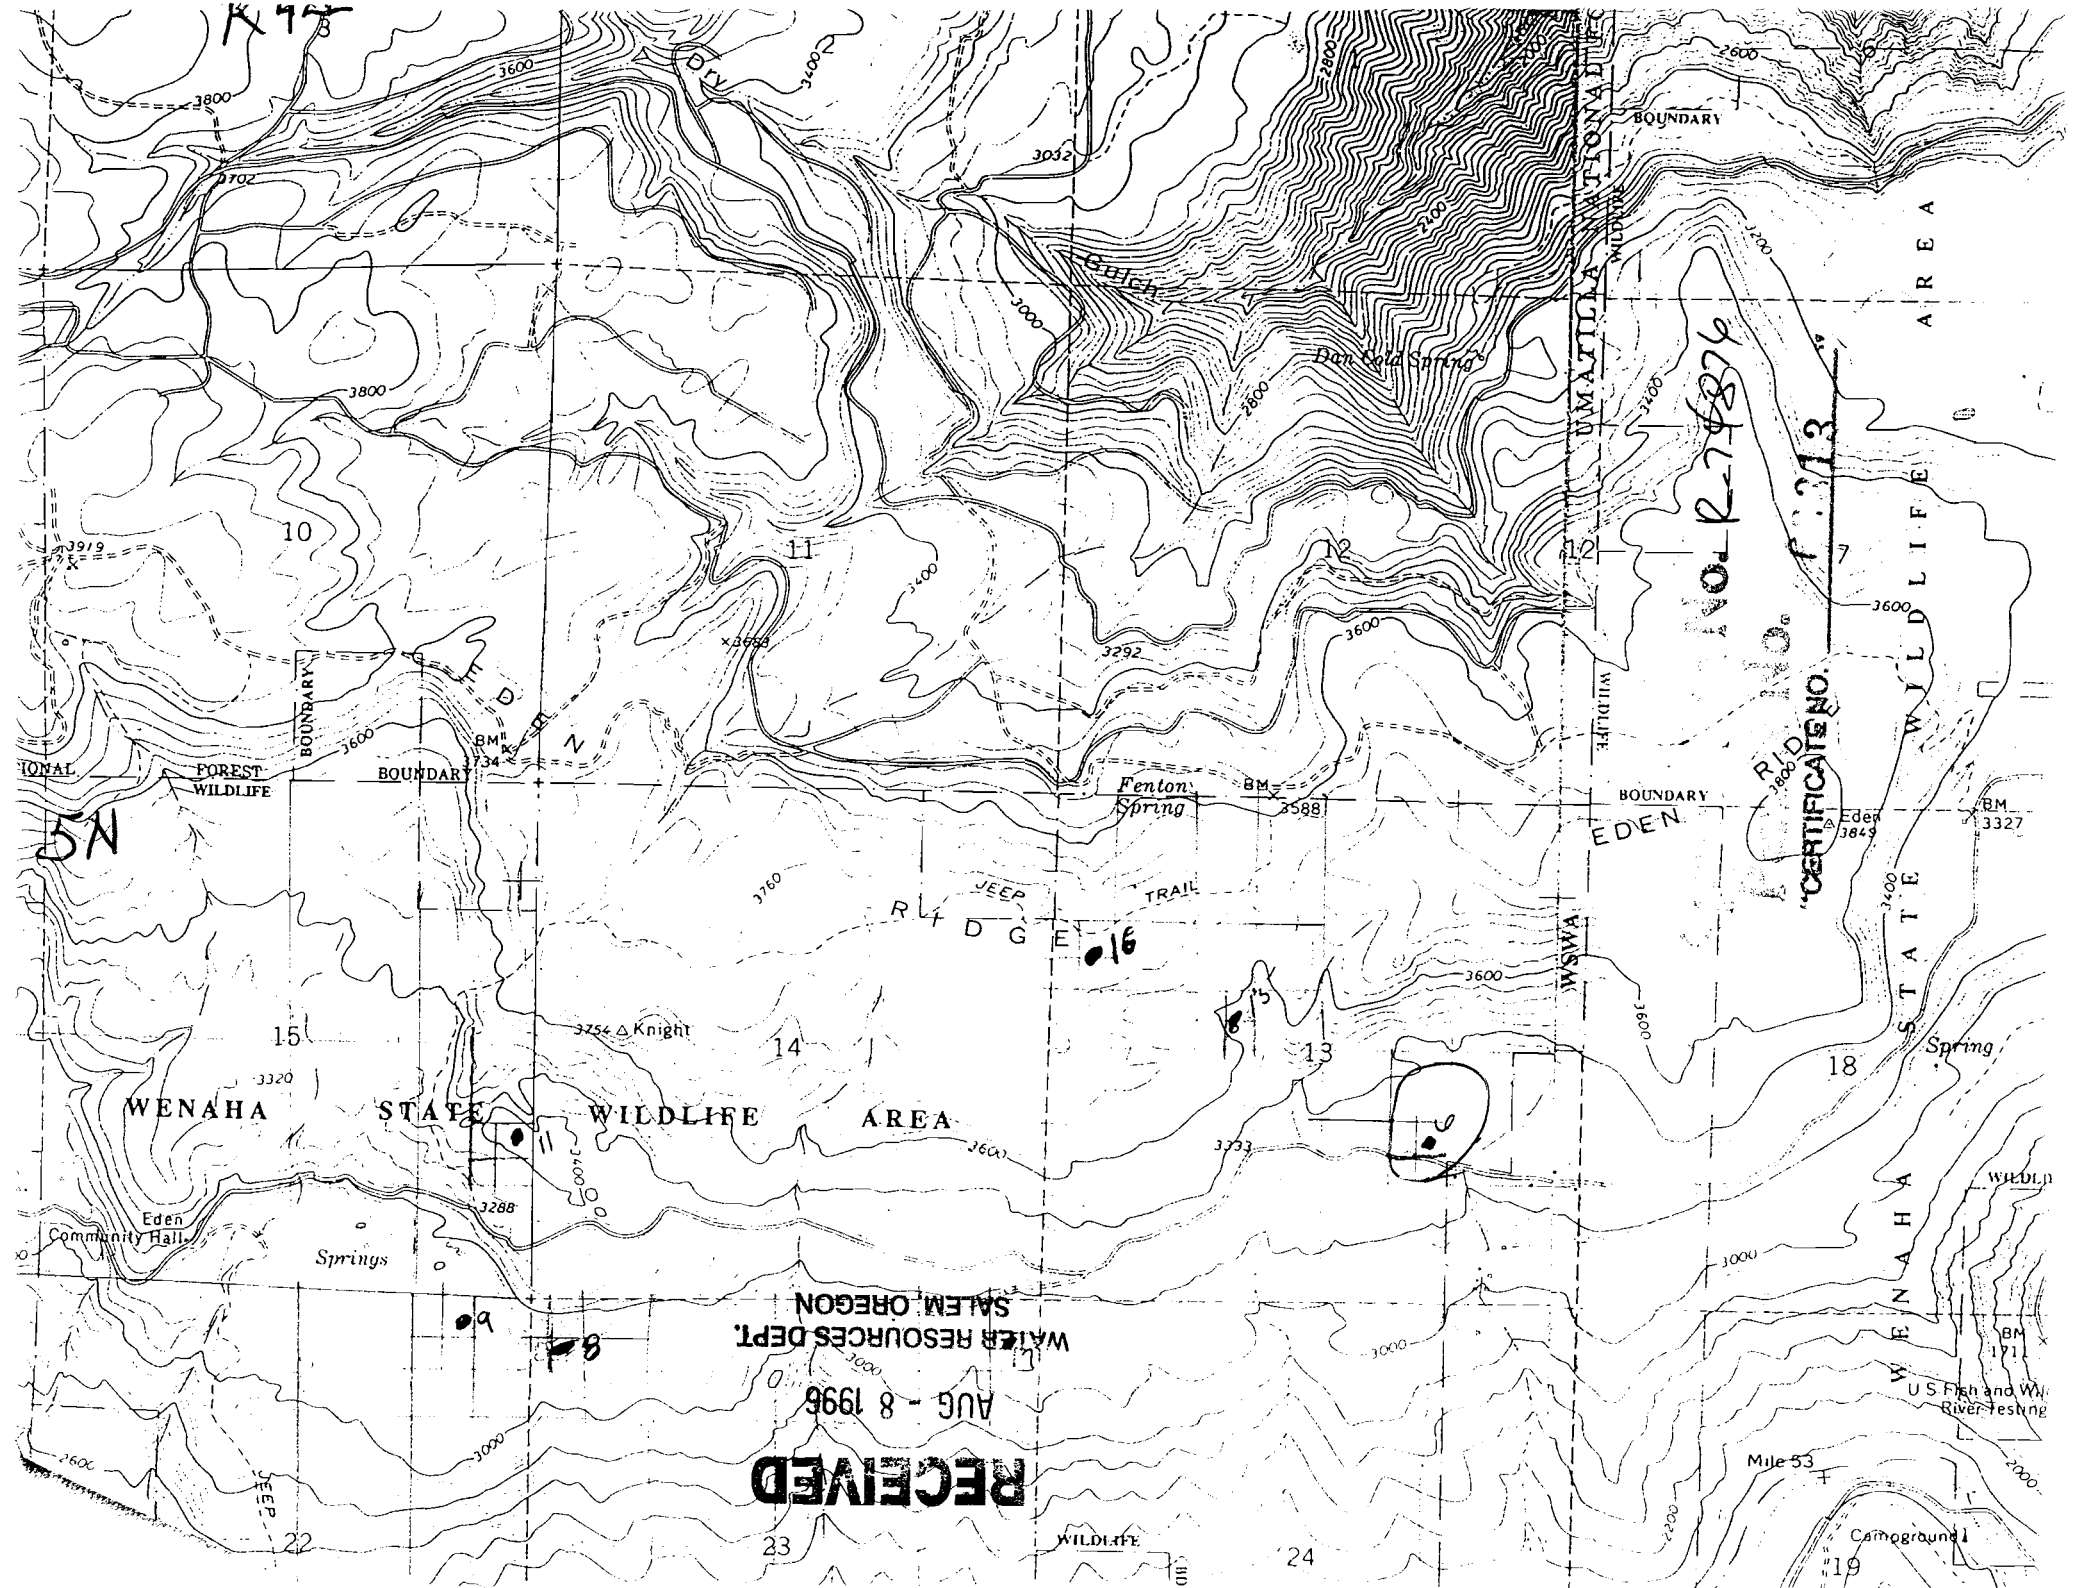


5N

274876

CERTIFICATE NO. 274876

RECEIVED
AUG - 8 1996
WILDER RESOURCES DEPT.
SALEM, OREGON

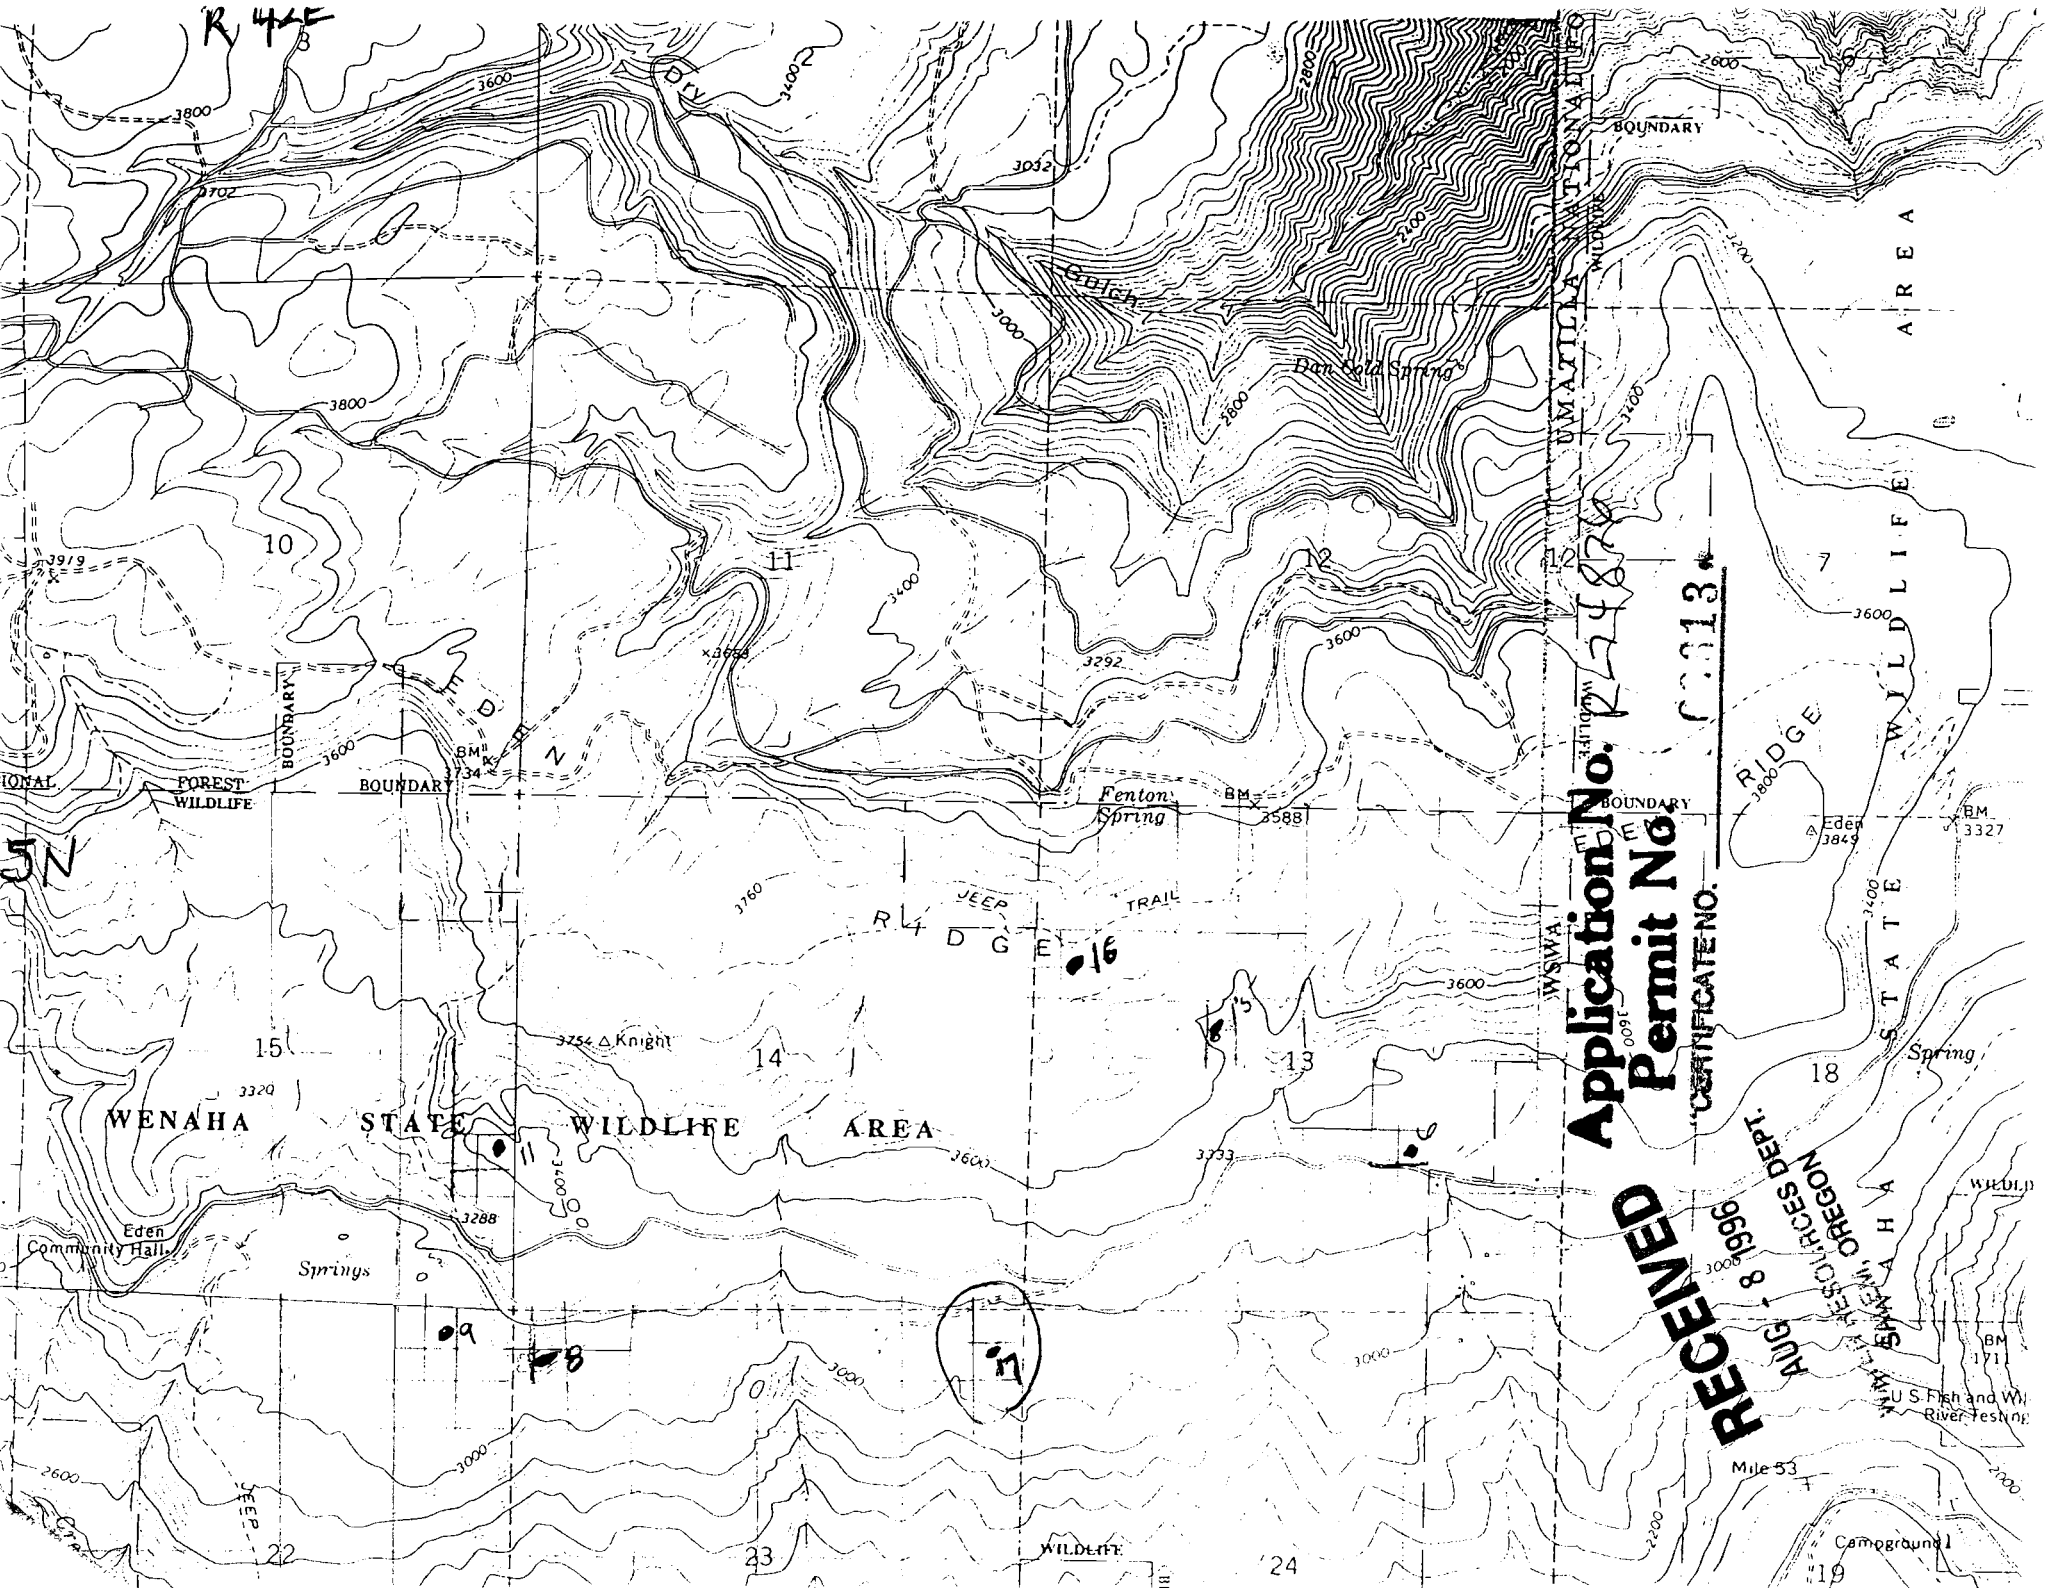

Application No. 274870
Permit No. 0013
RECEIVED

Mile 53

Campground

RECEIVED
AUG 8 1996
OREGON DEPT.

Permit No.

CERTIFICATE NO.

113

TRAIL

16

13

18

17

15

R43E

BOUNDARY

AREA

UMATILLA NATIONAL FOREST

WILDLIFE

EDEN

RIDGE

WILDLIFE

STATE

WENAH

Spring

Spring




U.S. Fish and Wildlife
River Testing Sta

Mile 53


Fenton Spring

Dan Gold Spring

OREGON DEPT.

11

3760

3254 Knight

WILDLIFE

AREA

3600







2800

2600

2600

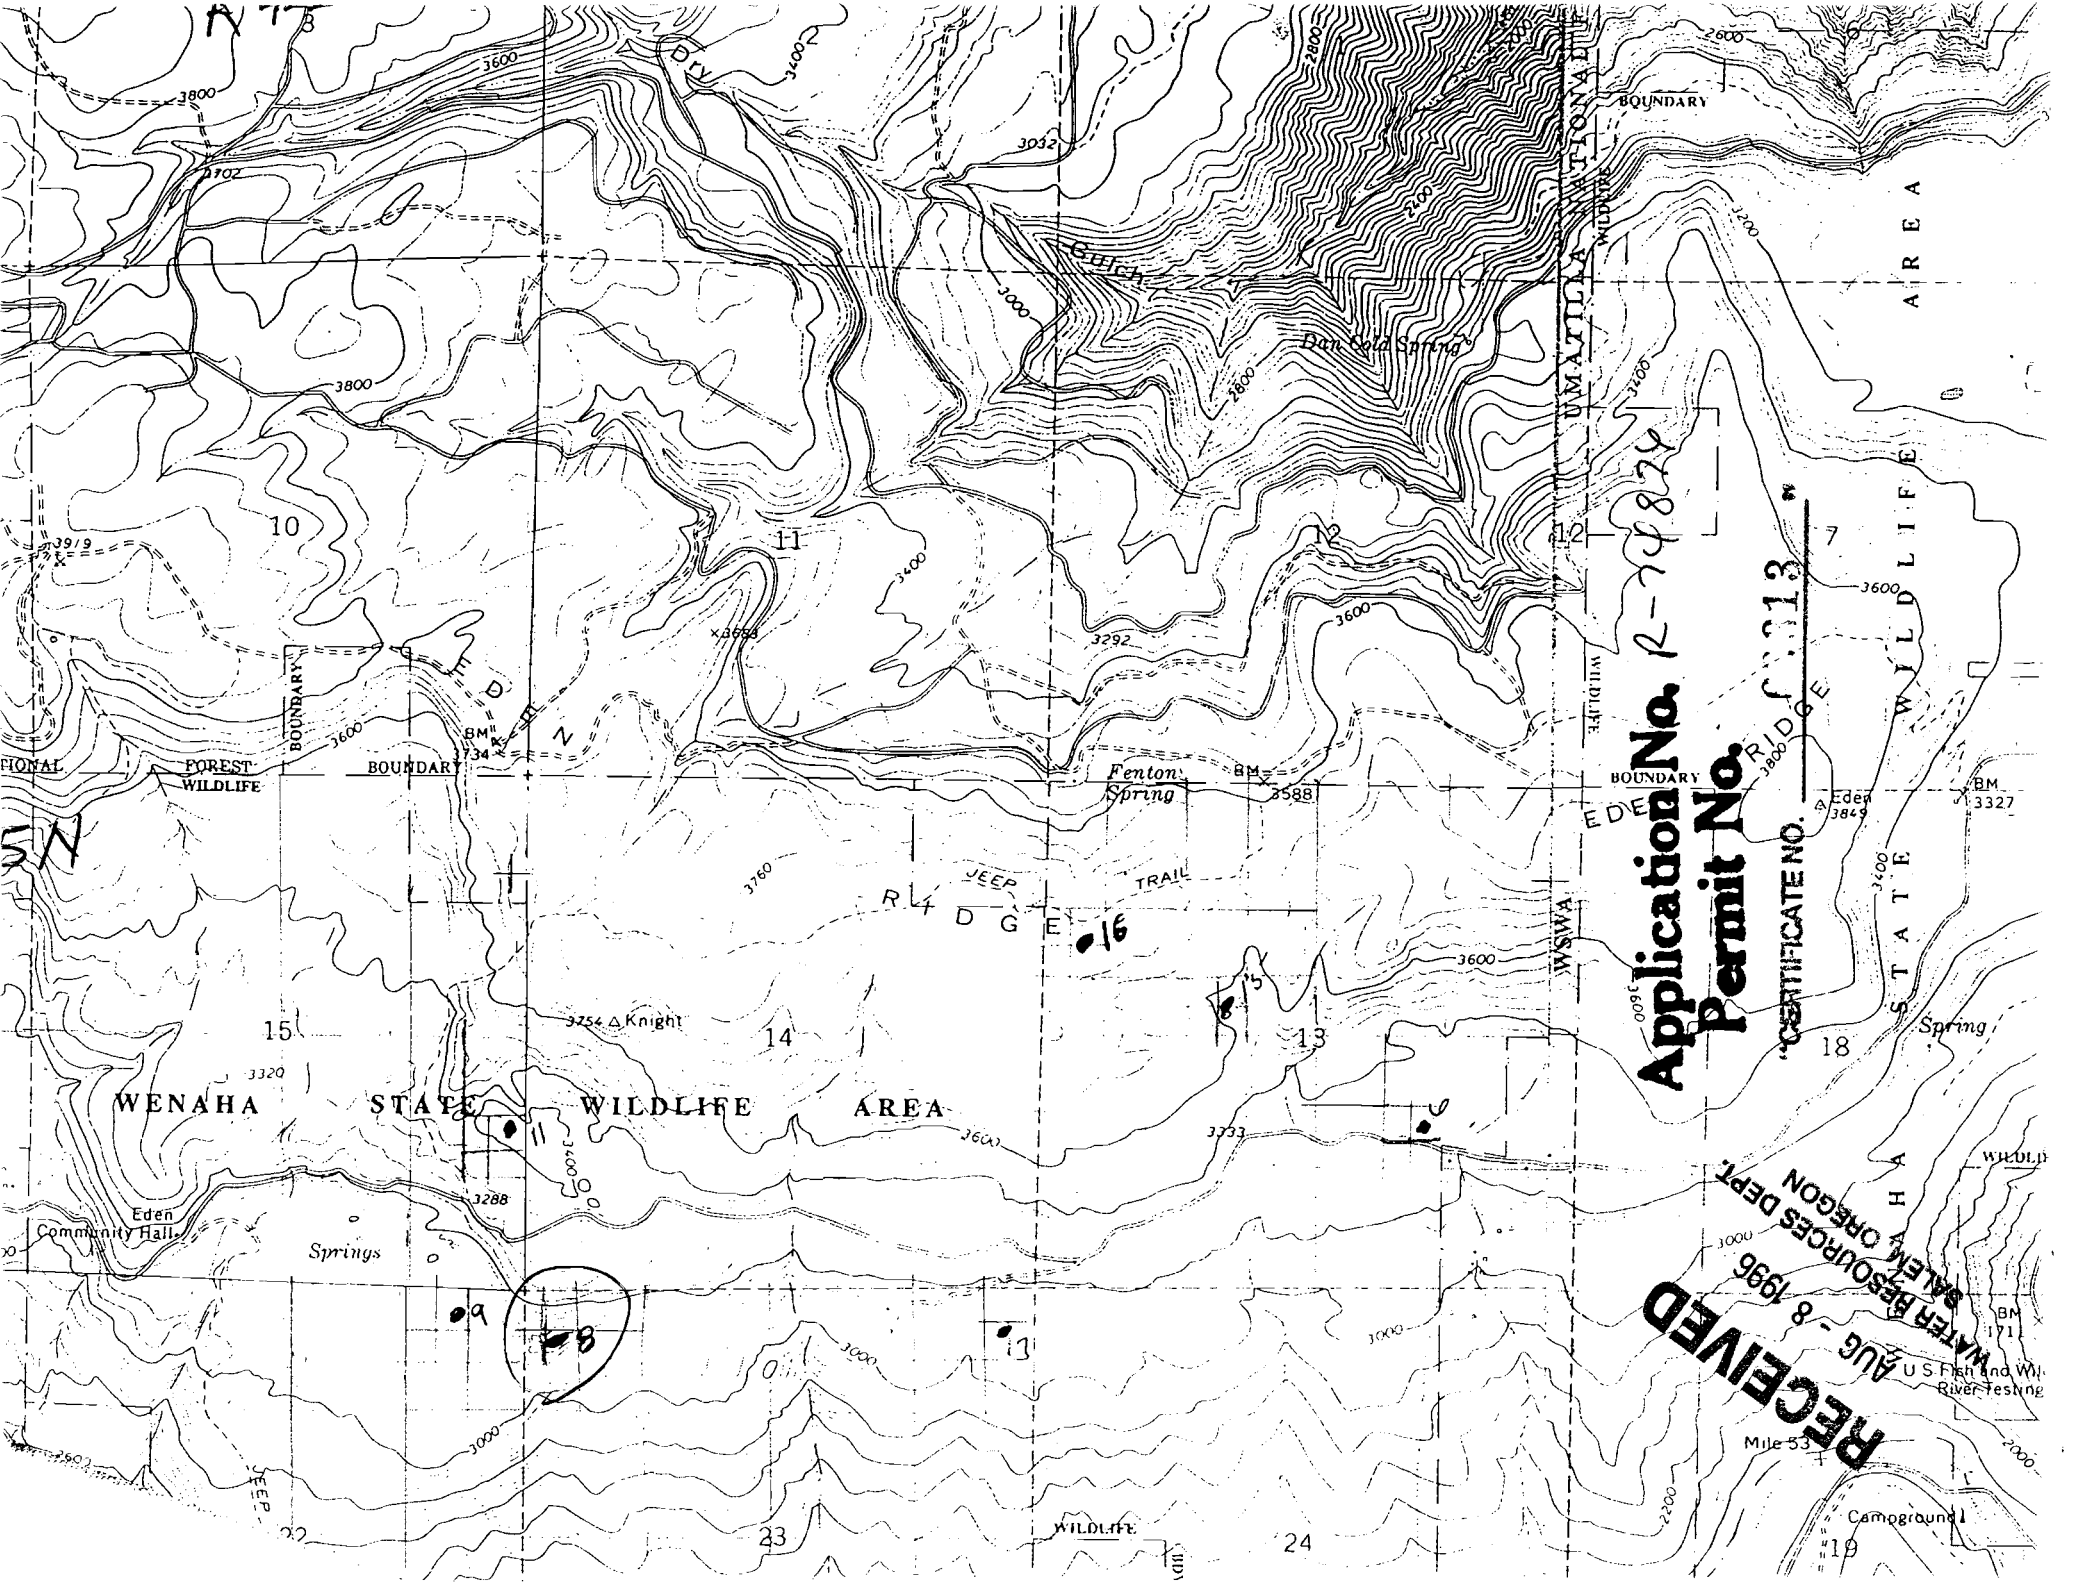

Application No. R-74874
Permit No.

Certificate No. 3313

RECEIVED
Aug - 8 1996
WATER RESOURCES DEPT.
SALEM, OREGON
U.S. Fish and Wildlife Service

Mile 5.3

Campground

WENAHA STATE WILDLIFE AREA

EDEN SPRING

Fenton Spring

Dan Gold Springs


AREA

STATE WILDLIFE

WILDLIFE

WILDLIFE

FOREST WILDLIFE

BOUNDARY

BOUNDARY

BOUNDARY


JEOP TRAIL

Eden Springs

Spring

U.S. Fish and Wildlife Service

River Testing

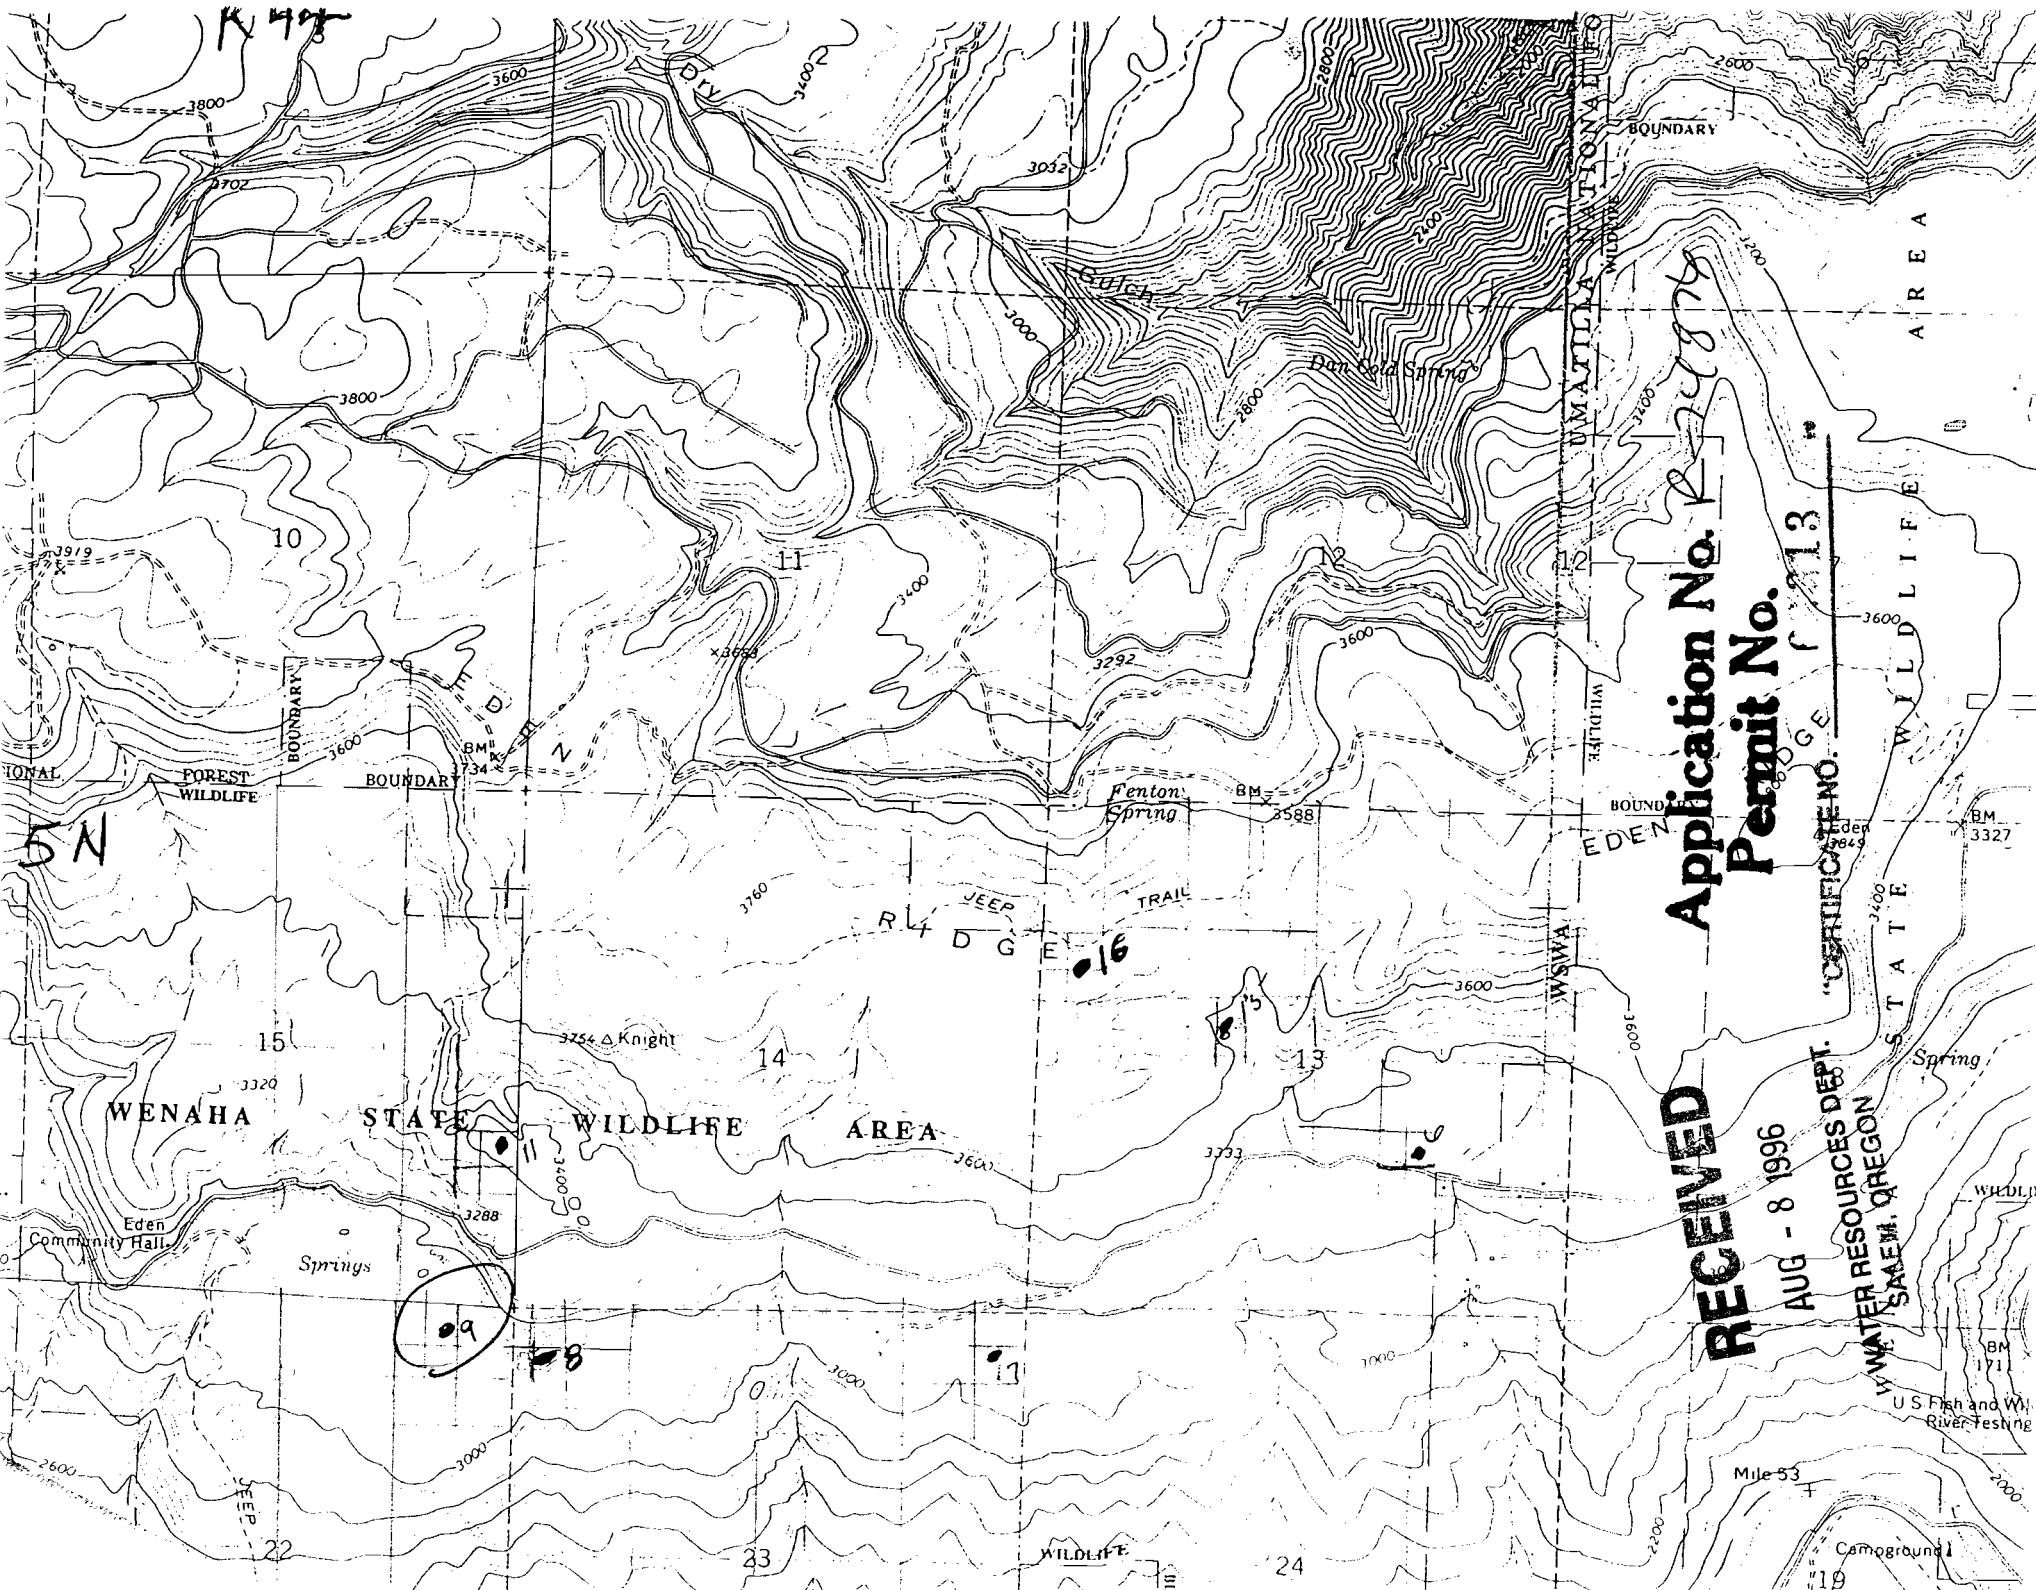

RECEIVED
Application No. **R-24878**
Permit No. **C-113**


AUG - 8 1996
WATER RESOURCES DEPT.
SALEM, OREGON

CERTIFICATE NO. **113**

U.S. Fish and Wildlife
River Testing

Mile 53

Campground

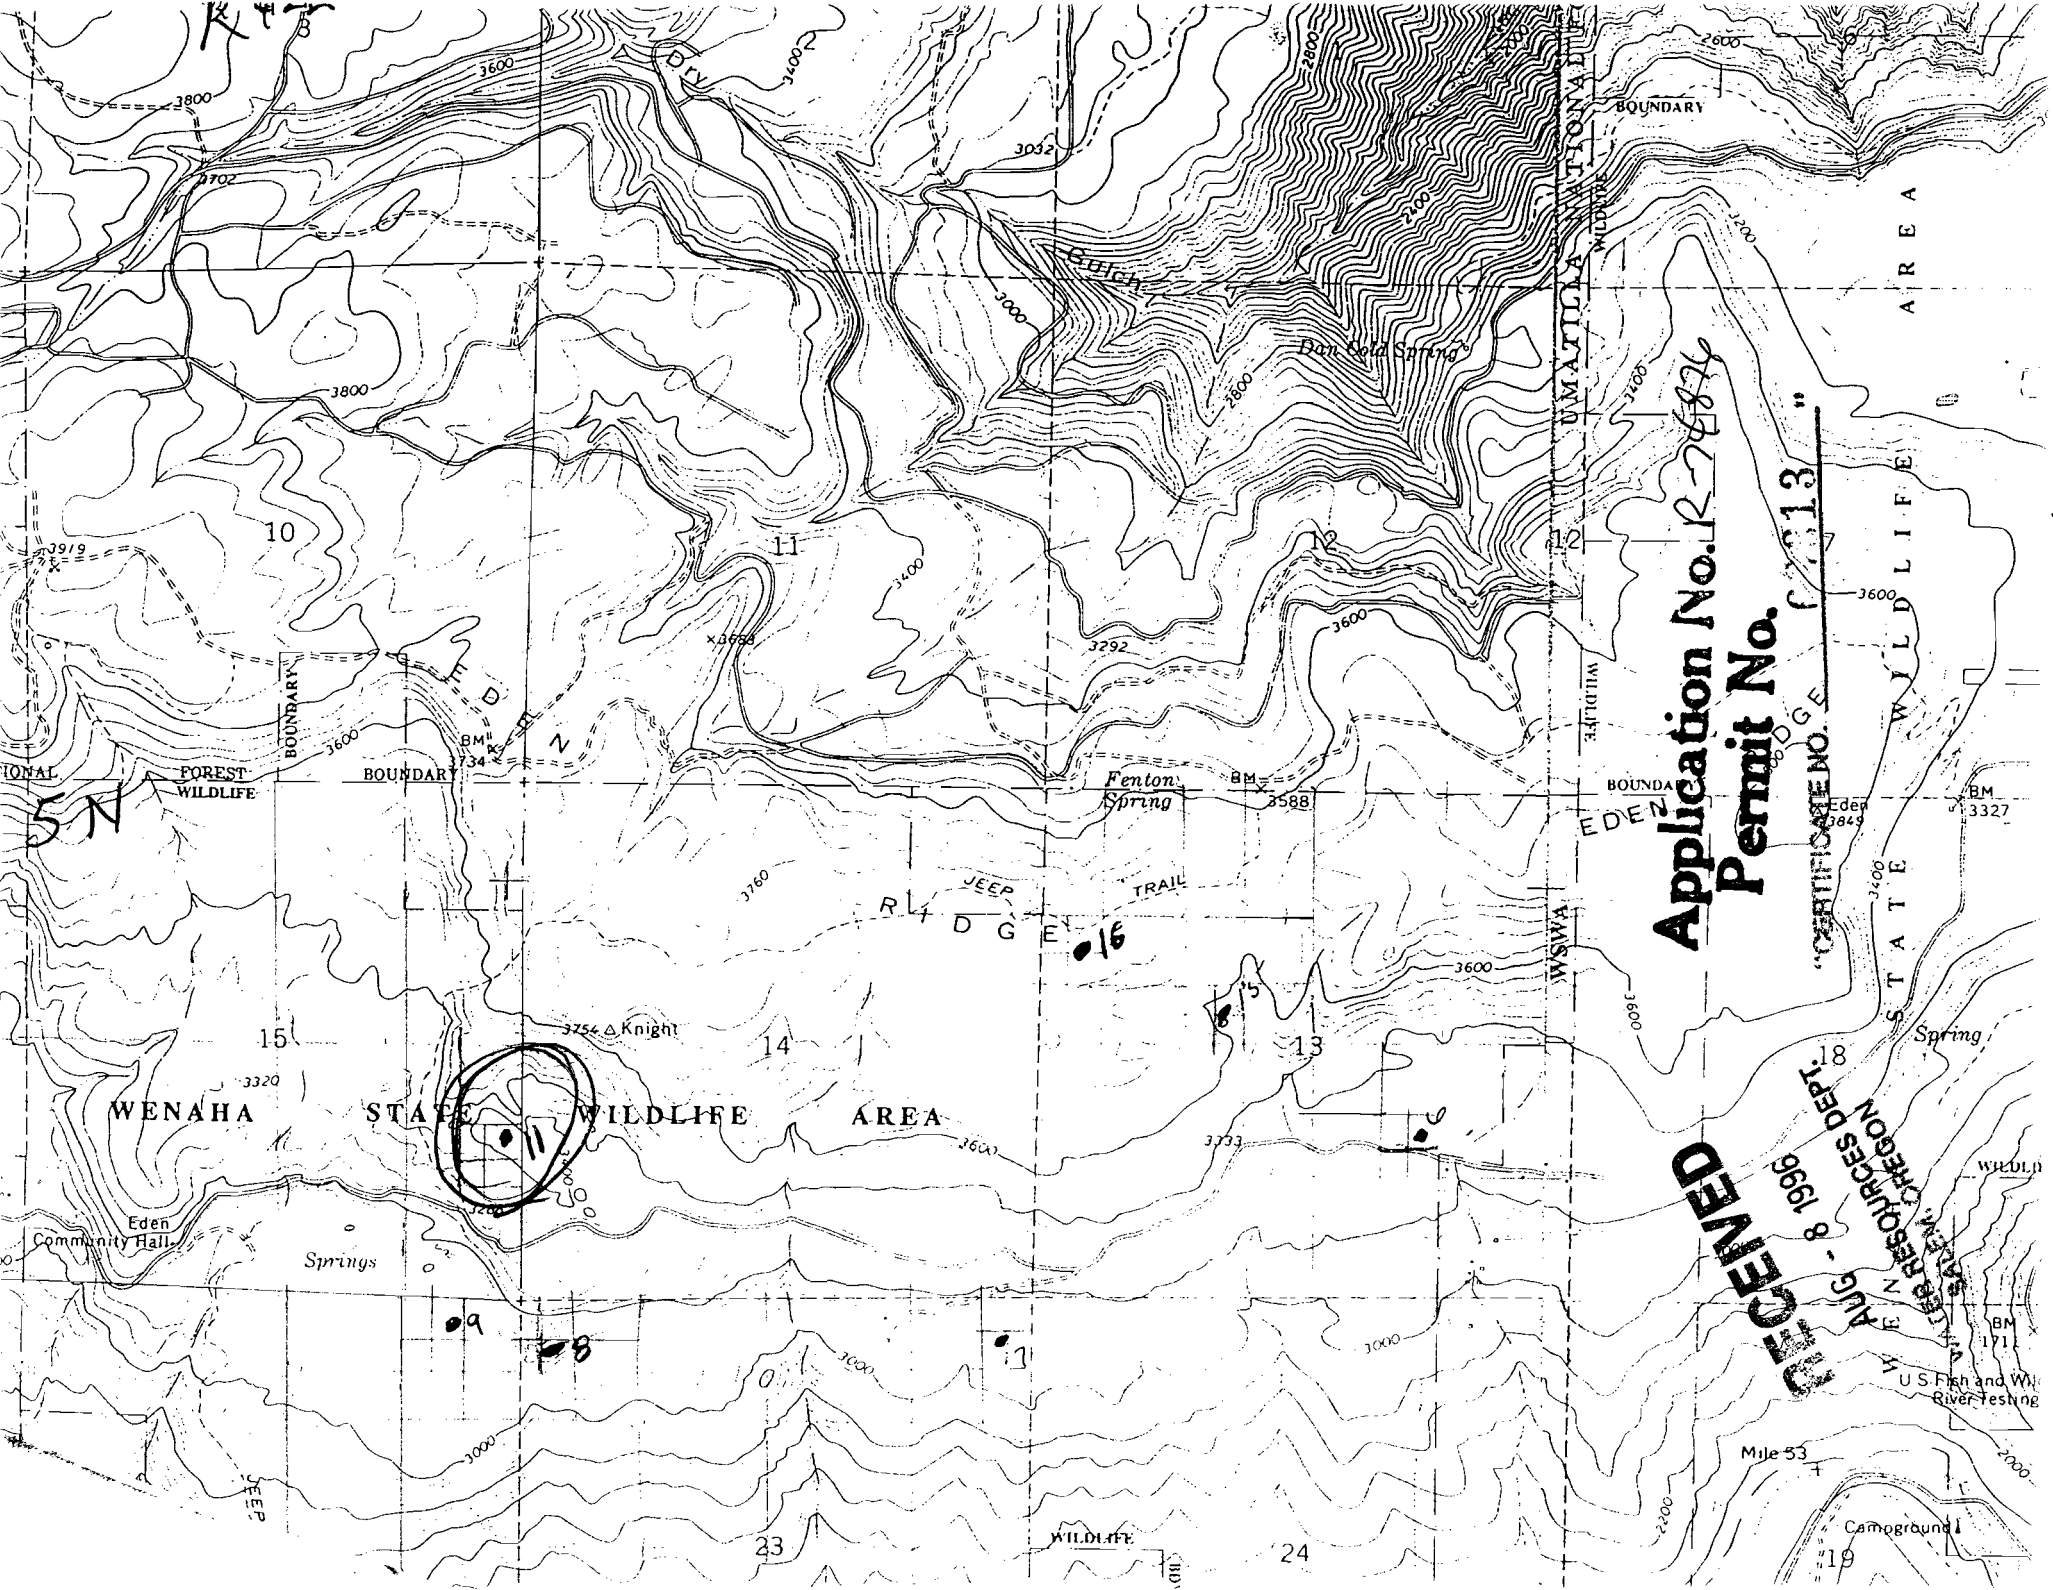


Permit No.


RECEIVED
OREGON

Mile 53

Campground

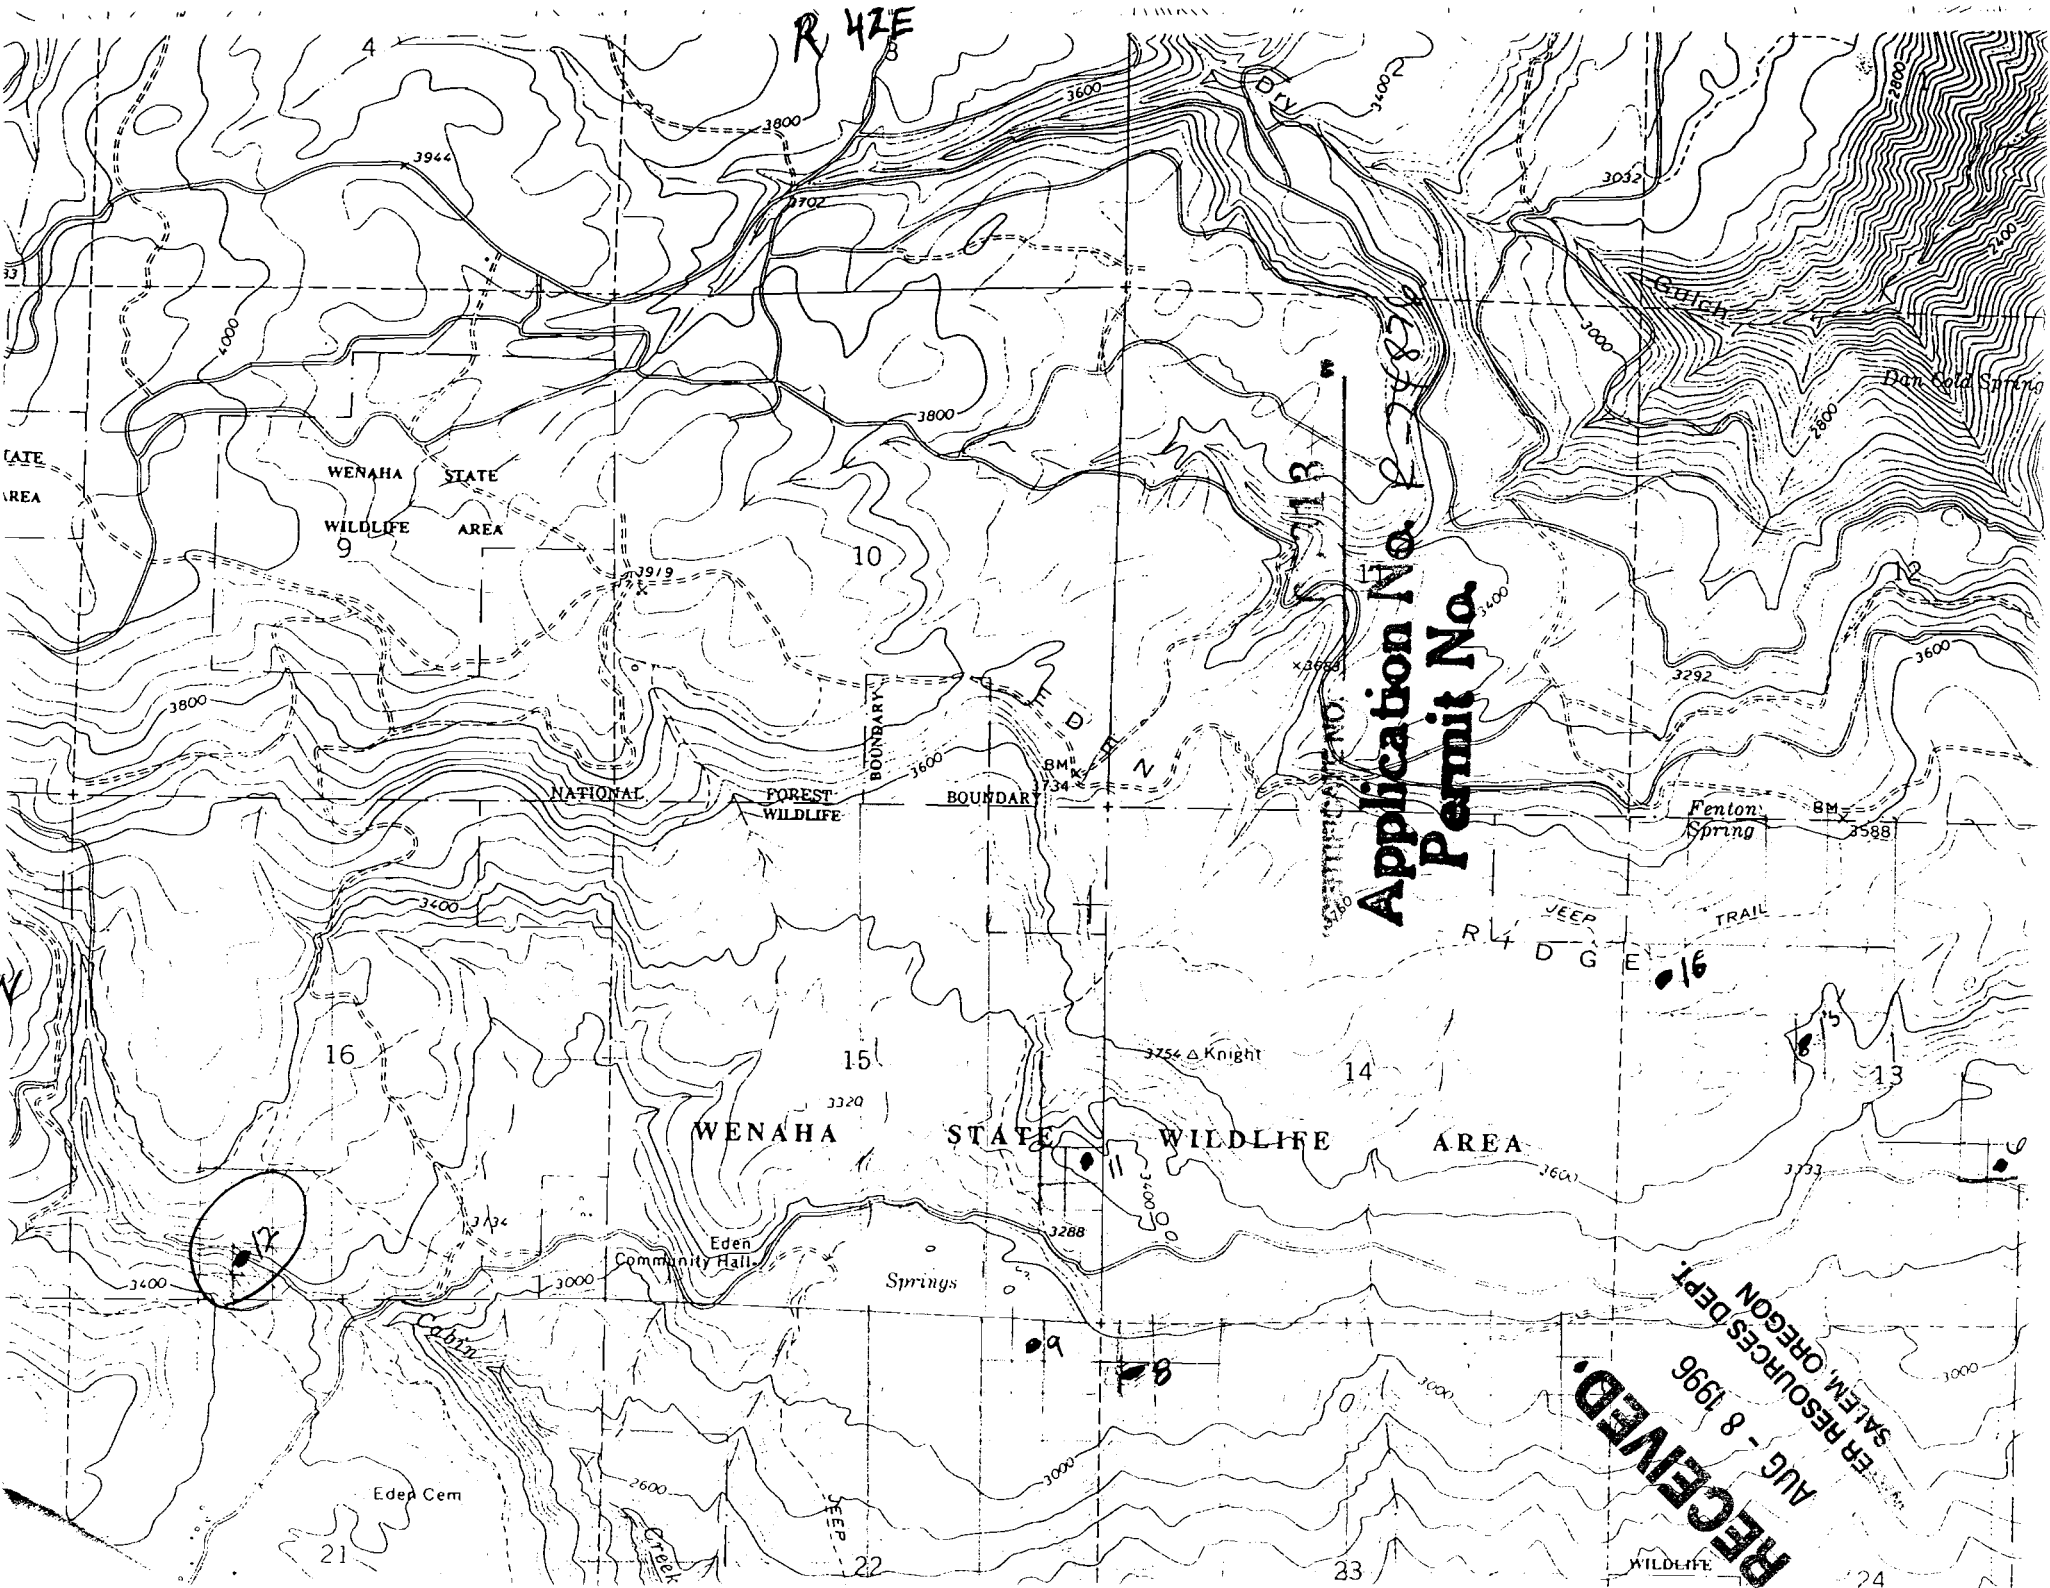

R 42E

Application No. R-24886
Permit No. 113

RECEIVED
AUG - 8 1996
WILDLIFE
ER RESOURCES DEPT.

WENAH
STATE
WILDLIFE
AREA

NATIONAL
FOREST
WILDLIFE

WENAH
STATE
WILDLIFE
AREA


Eden Cem

Eden
Community Hall

Springs

Fenton
Spring

Dan Gold Spring

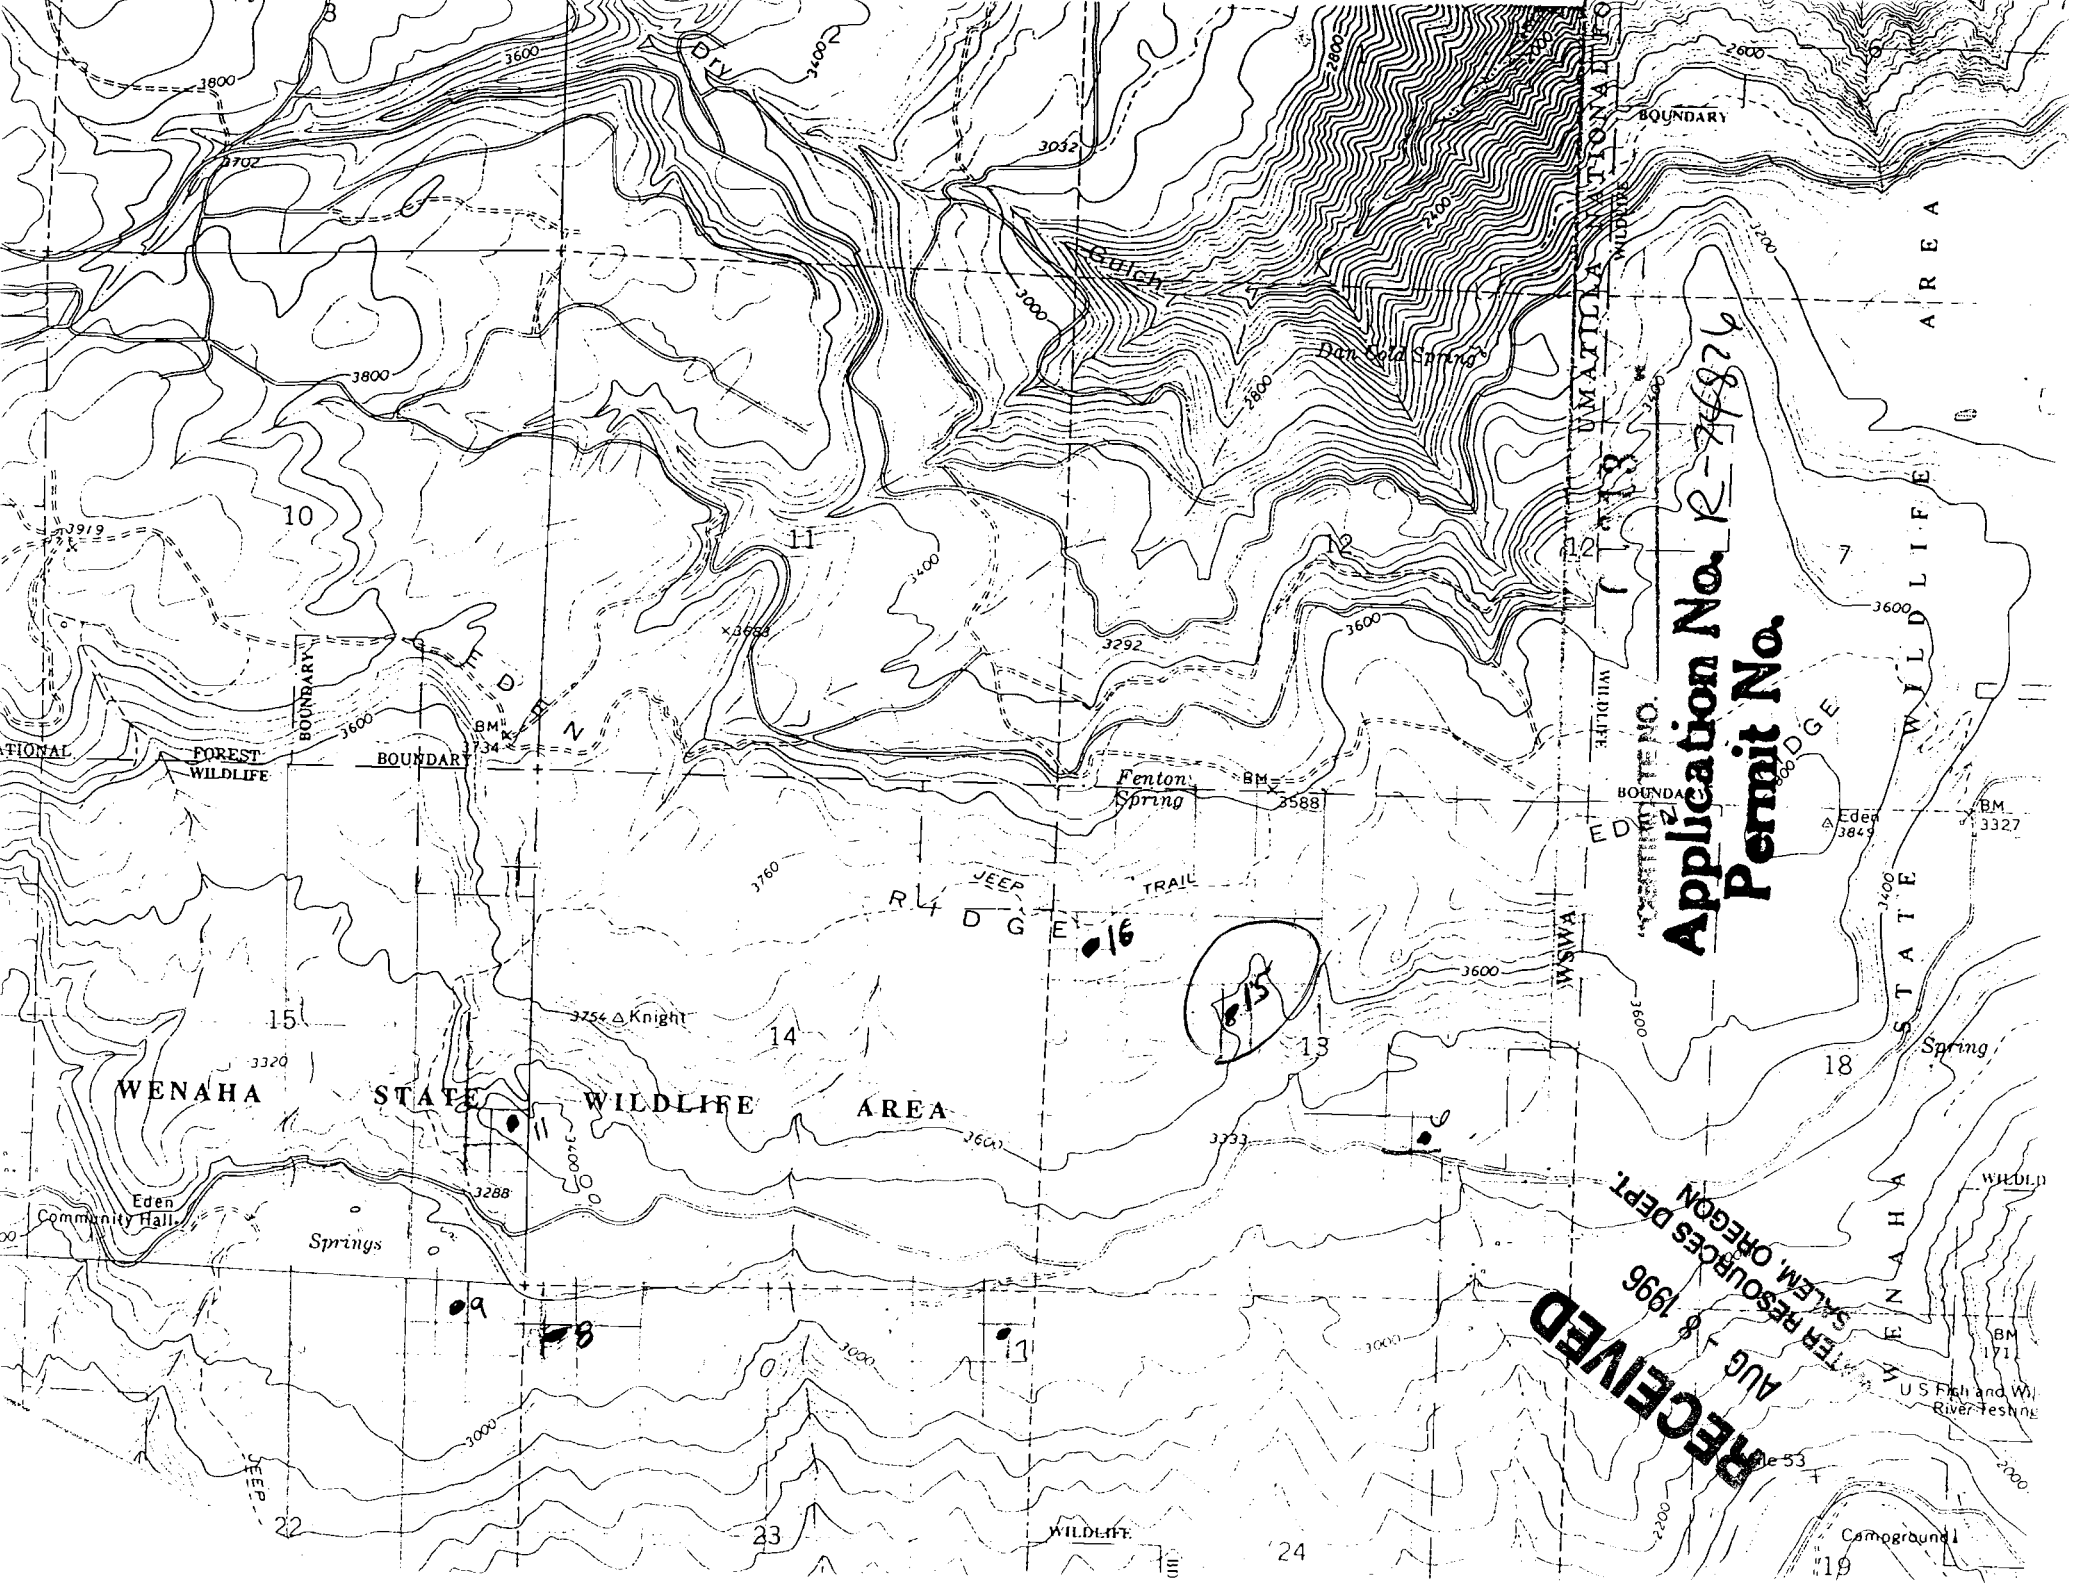

Application No. R-74876
Permit No.

RECEIVED
AUG - 8 1996

R 42E

RECEIVED
AUG - 8 1996


WATER RESOURCES DEPT
SALEM, OREGON

Permit No.

CERTIFICATE NO. 10

1213

5N

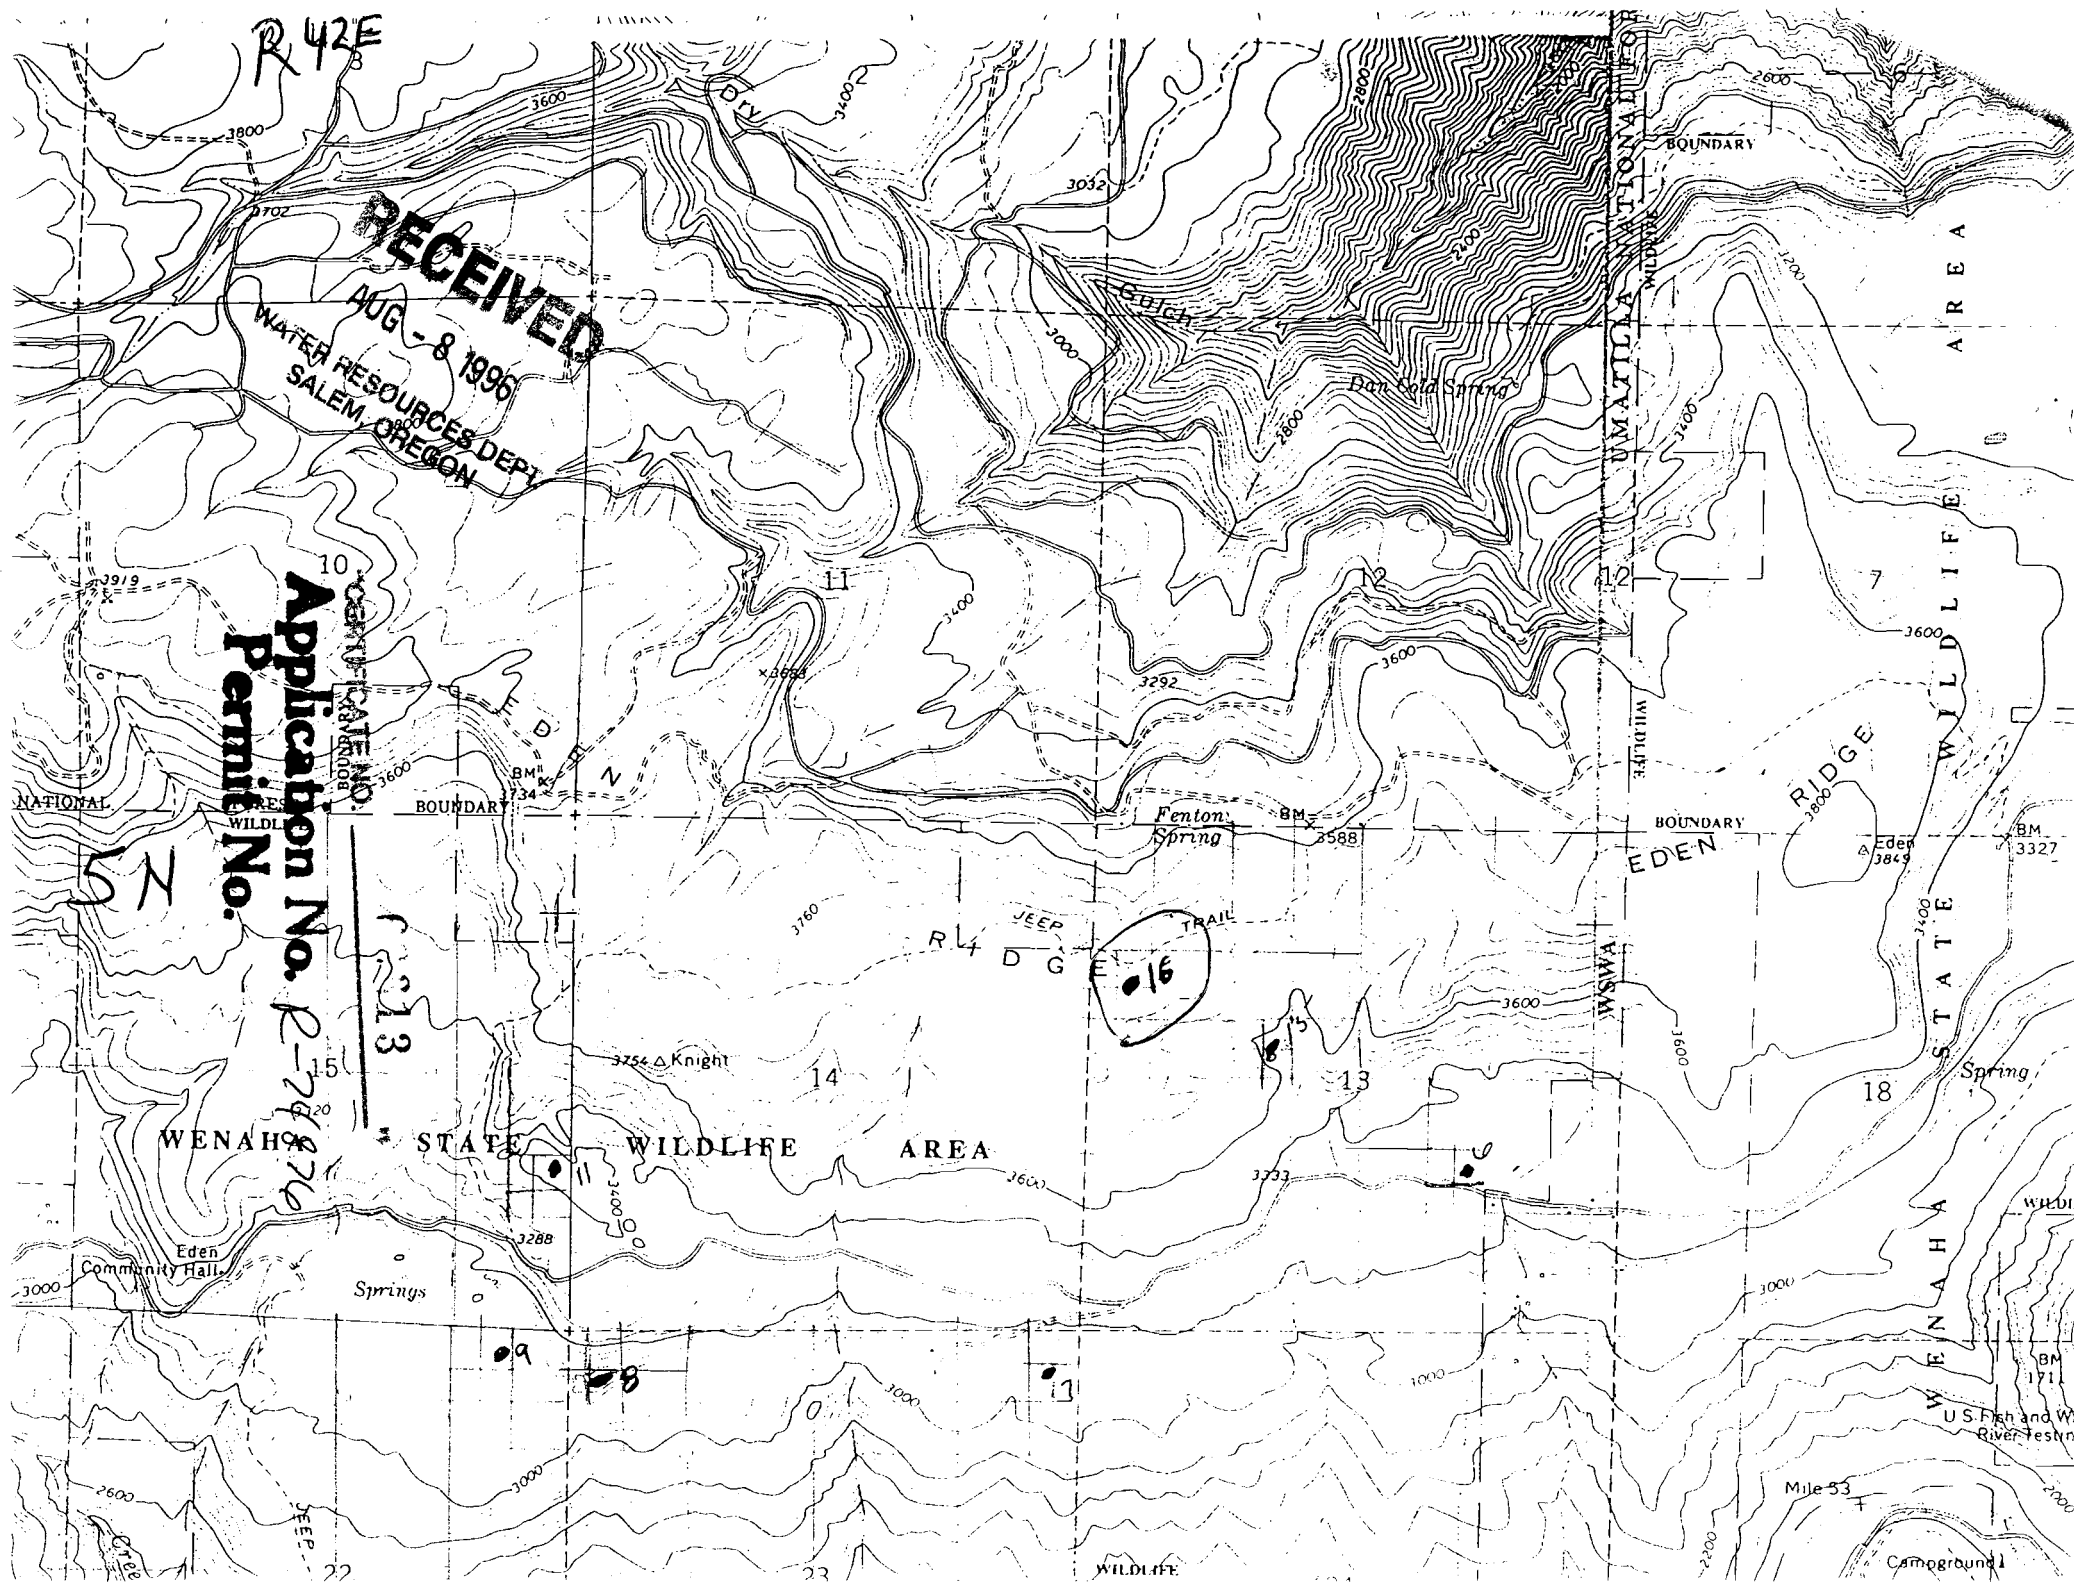

UMATILLA NATIONAL FOREST

AREA

WILDLIFE

STATE

WENAH

U S Fish and W

River Testin

Mile 53

Campground

WILDLIFE

23

22