



Plat Map - Jeff Moore Property
 Township 3 South, Range 45 East, Sections 10 & 15
 Tax lot 3502 - 101 acres

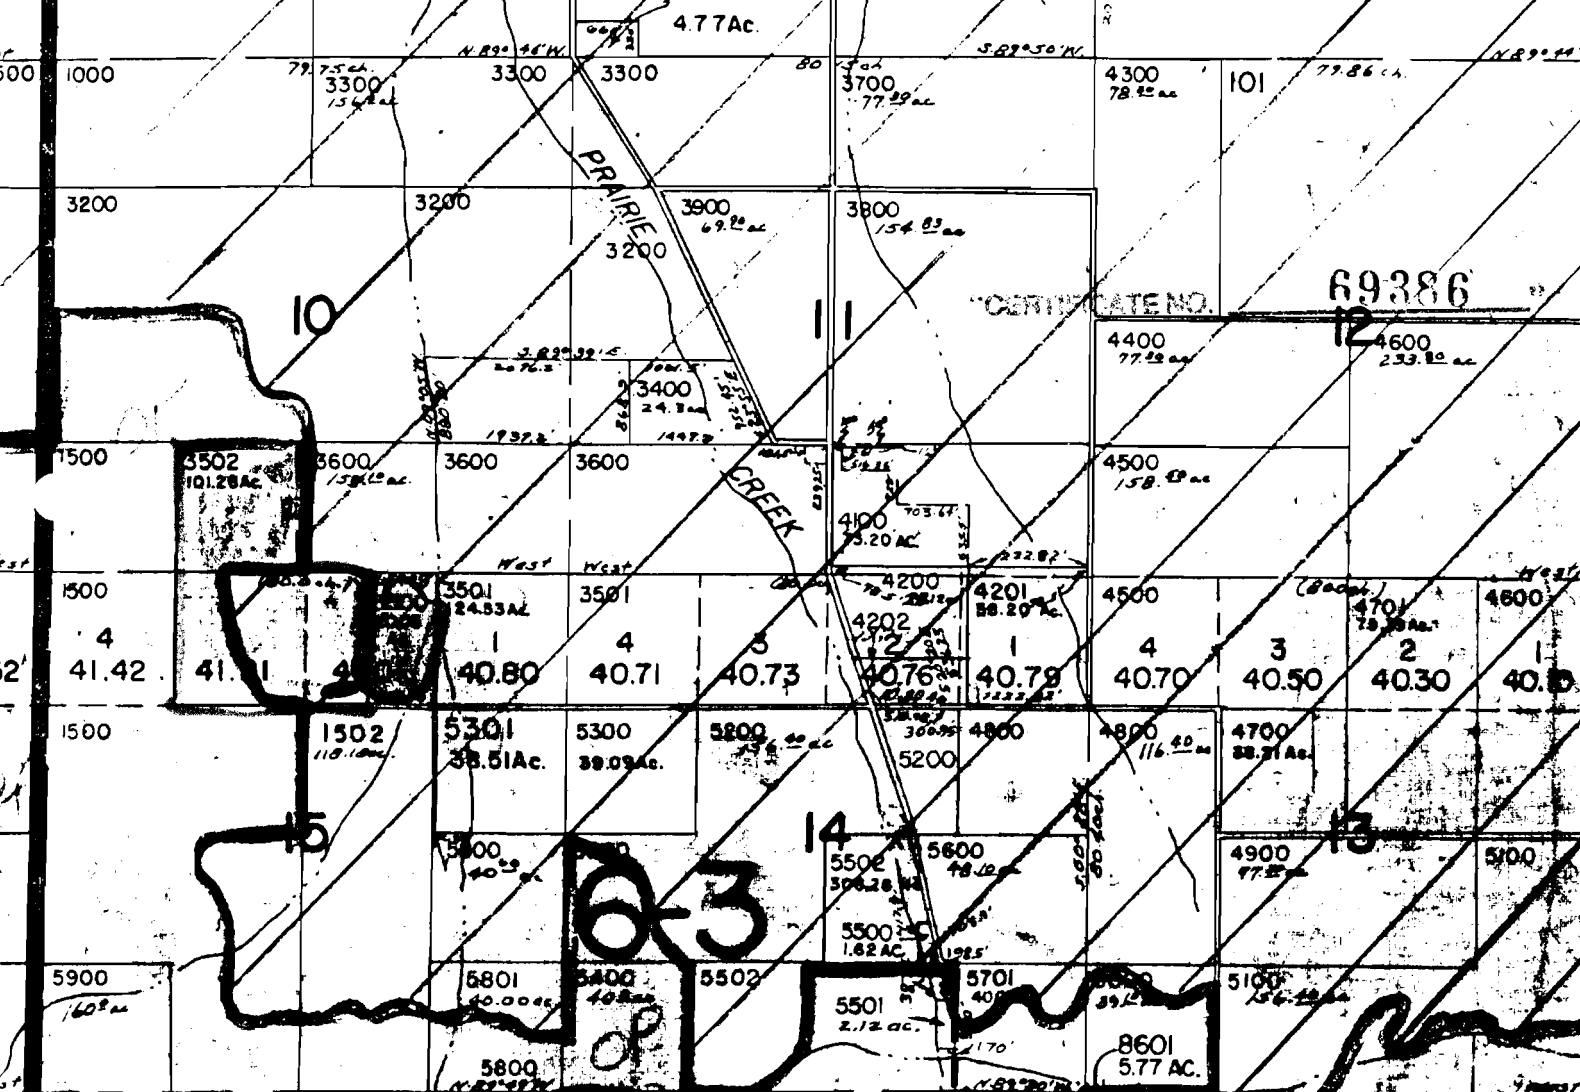

Adjacent Landowners

- Tax lot 1500 Ron Yanke
- Tax lot 1502 George Price
- Tax lot 3200 Jacob Schaefer
- Tax lot 3500 David Clough
- Tax lot 3600 Georgia Marshall Trustee





R75063D

69386

CERTIFICATE NO.

Topographic Map - Jeff Moore Property Township 3 South, Range 45 East, Sections 10 & 15

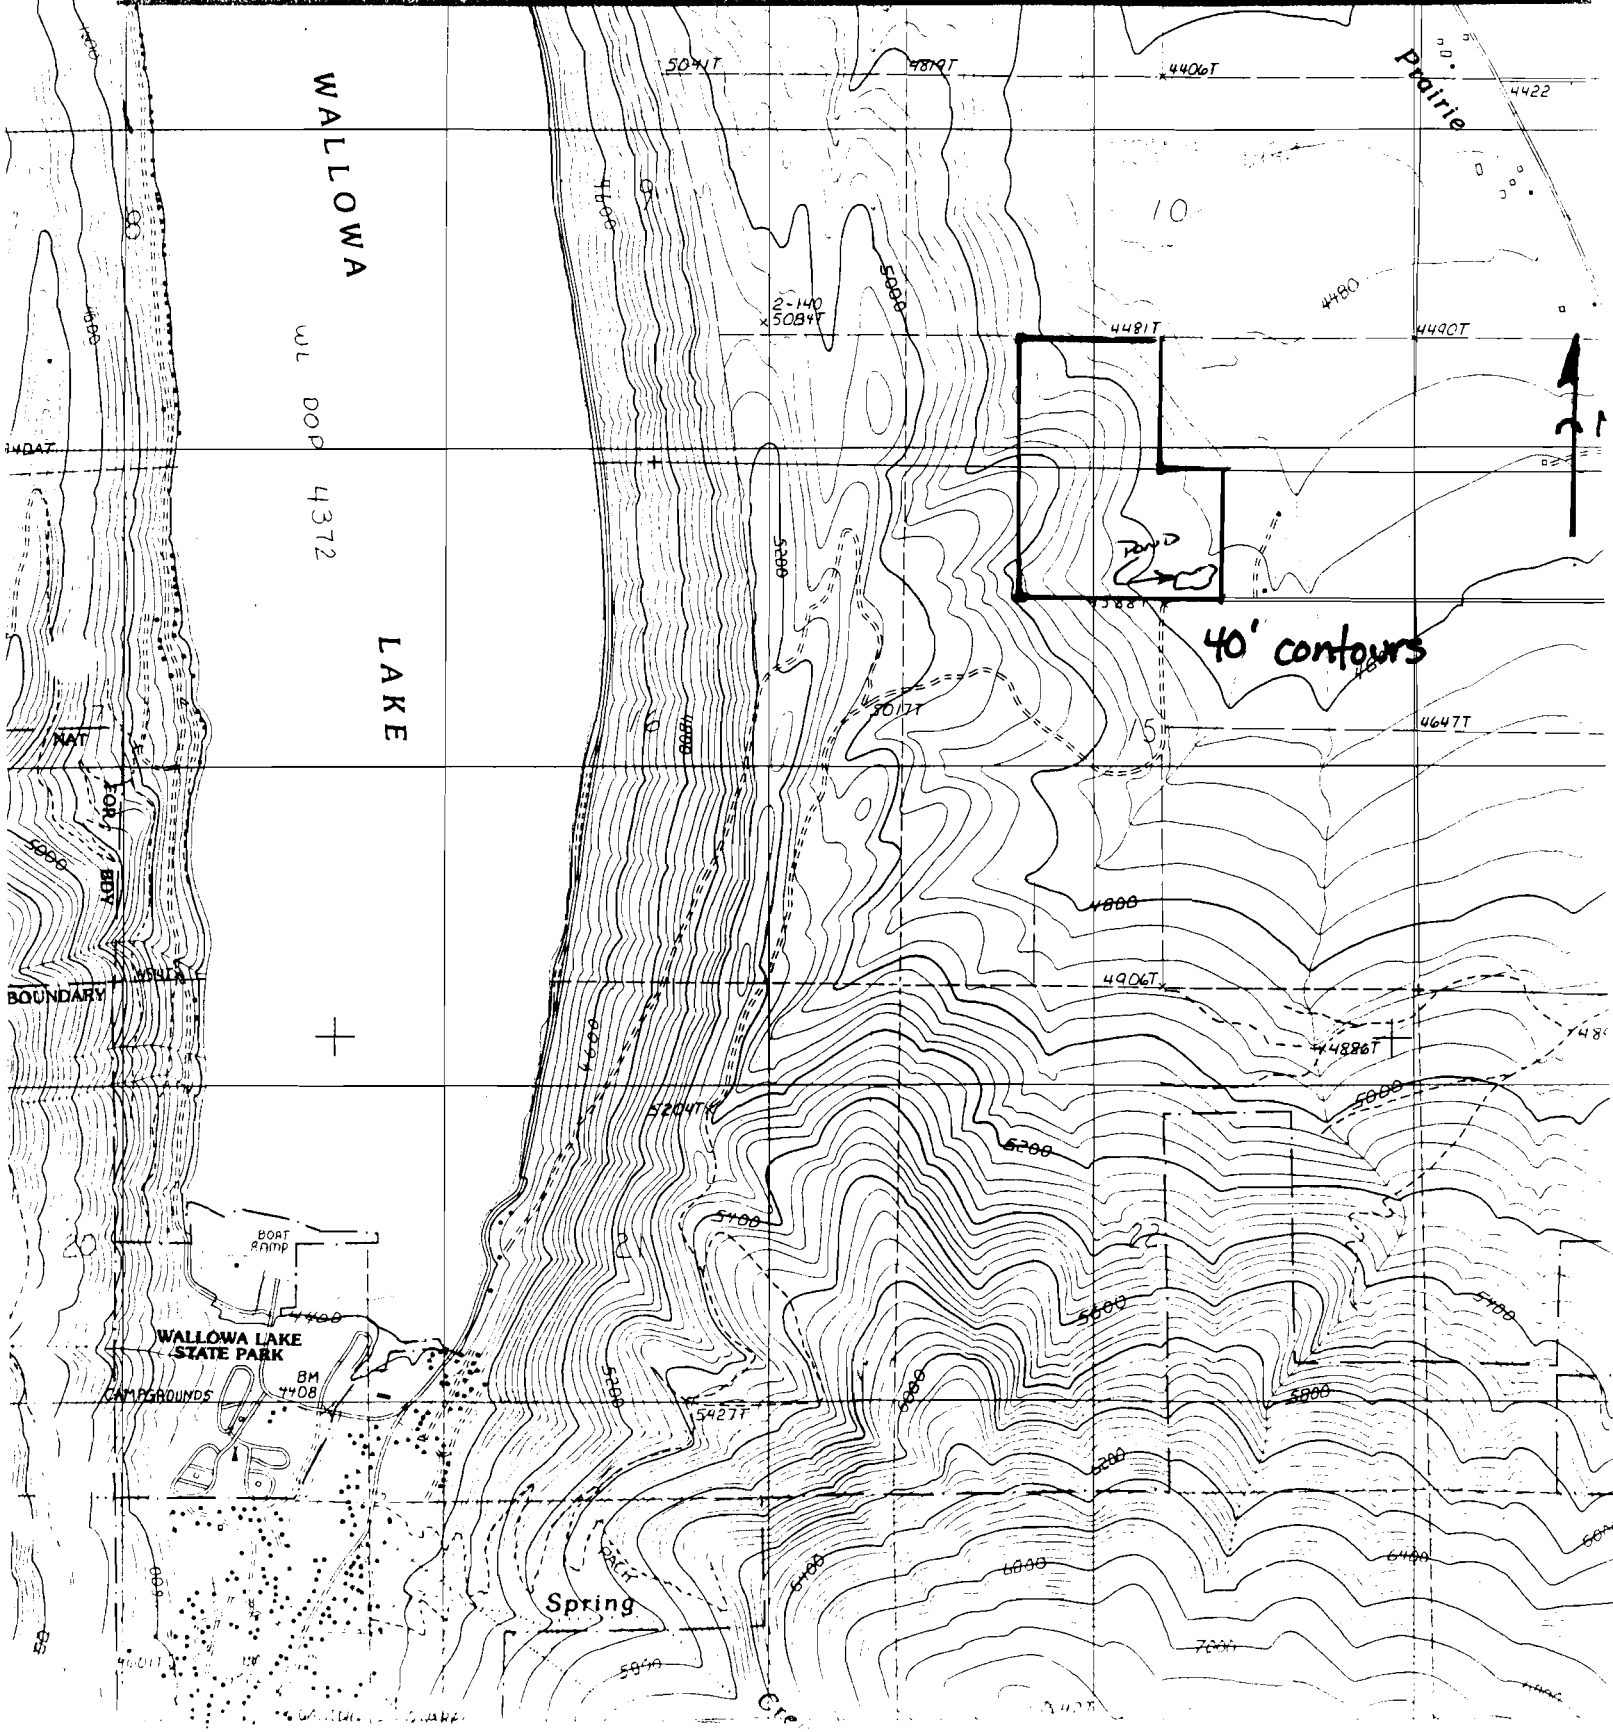

WALLOWA

WL DOP 4372

LAKE

Prairie

40' contours

WALLOWA LAKE STATE PARK

CAMPGROUNDS

Spring


Cre



69386 Three Lakes Country

Vicinity Map - Jeff Moore Property

Township 3 South, Range 45 East, Sections 10 & 15

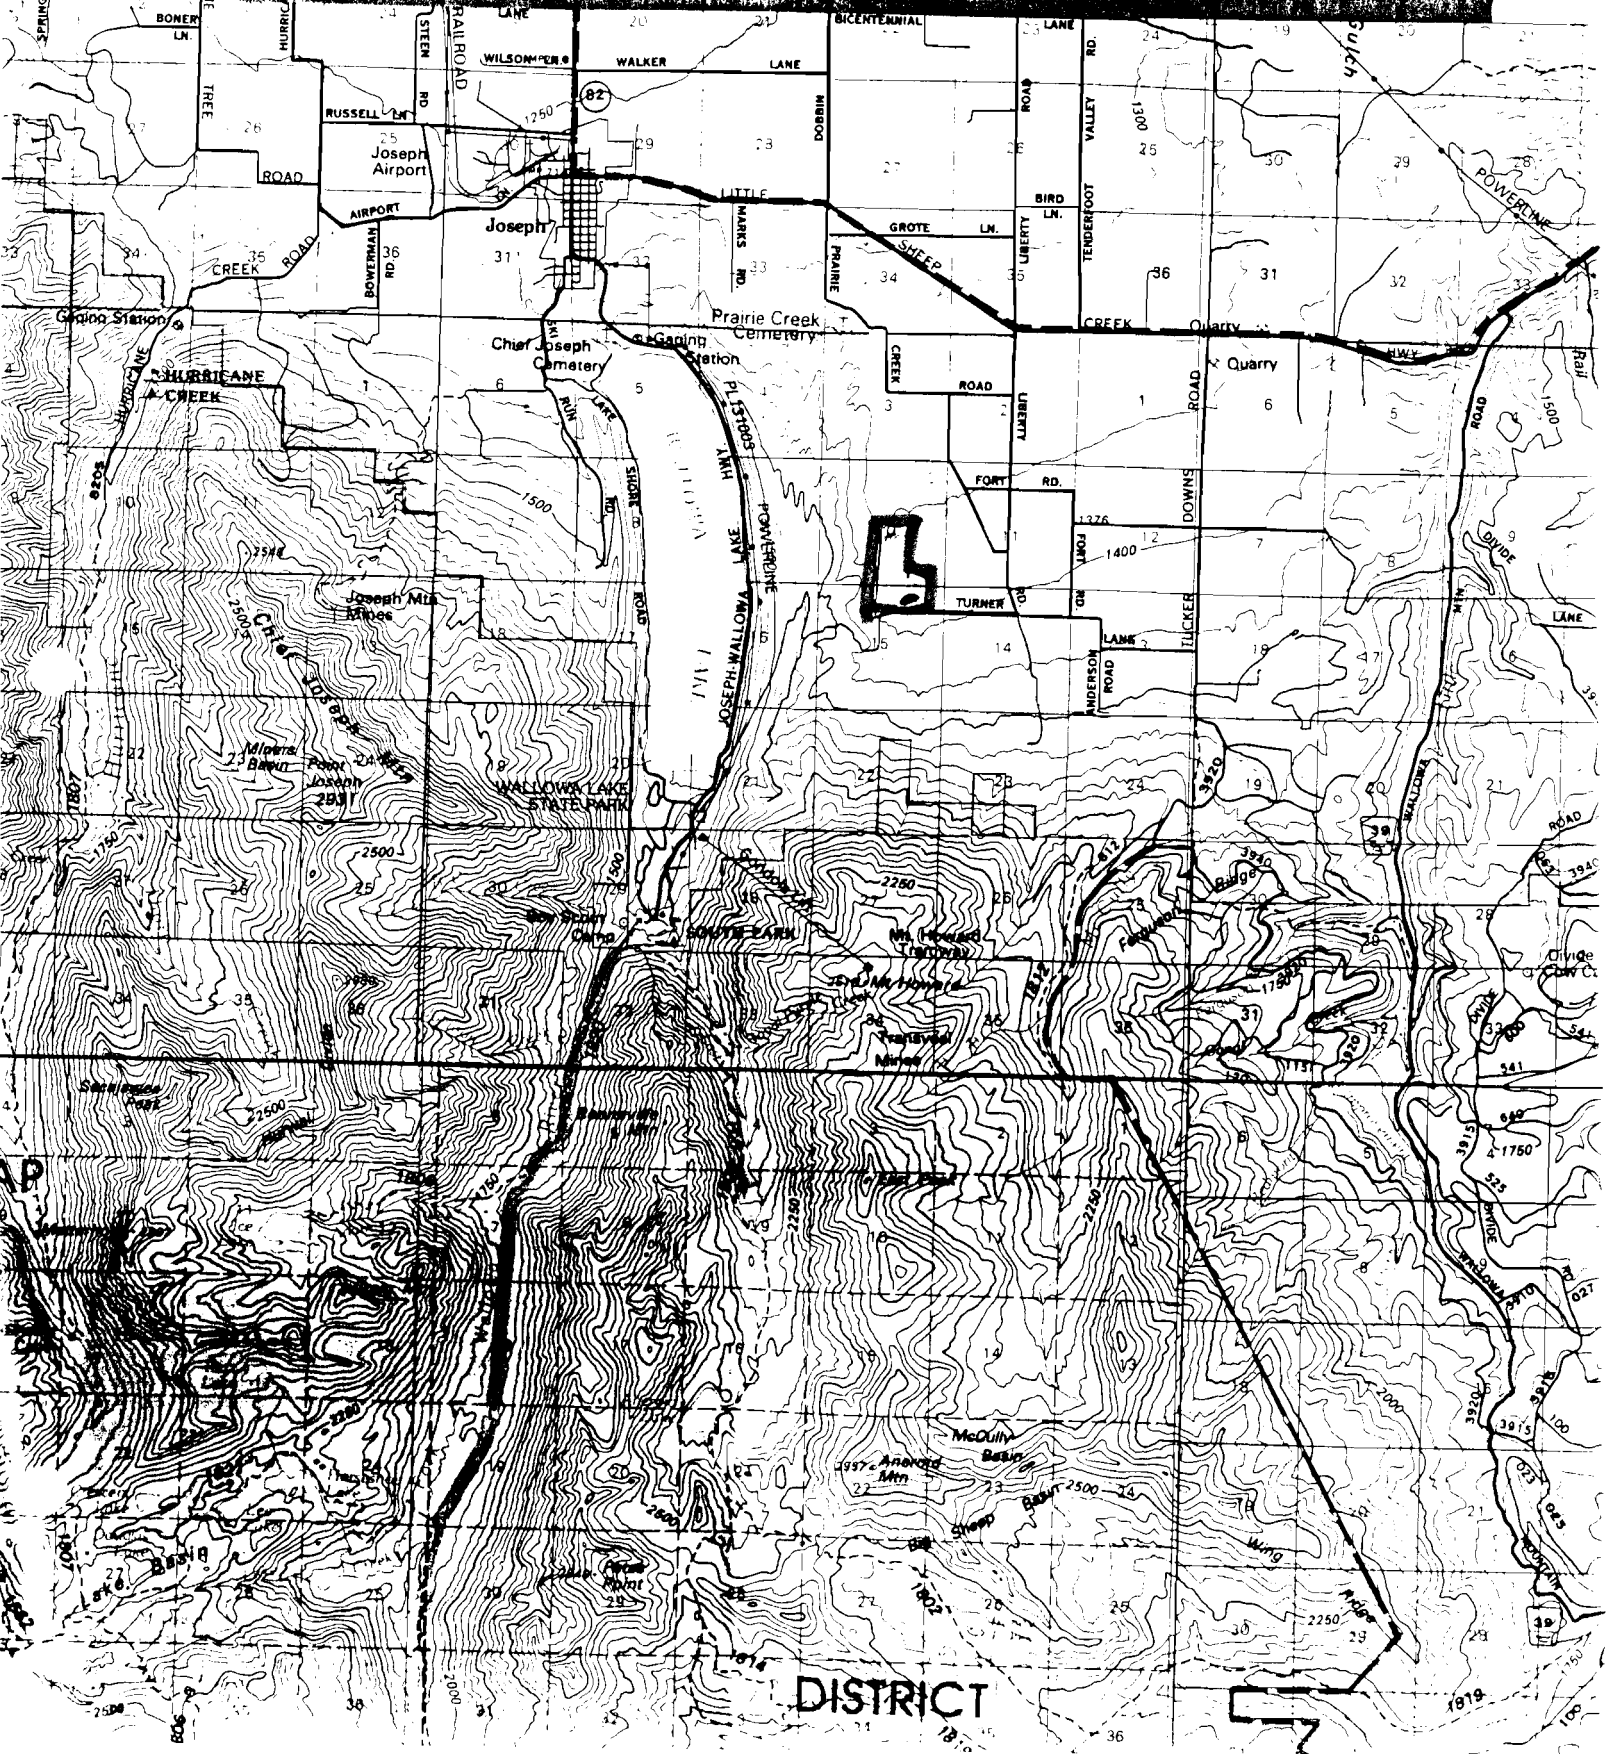

DISTRICT