


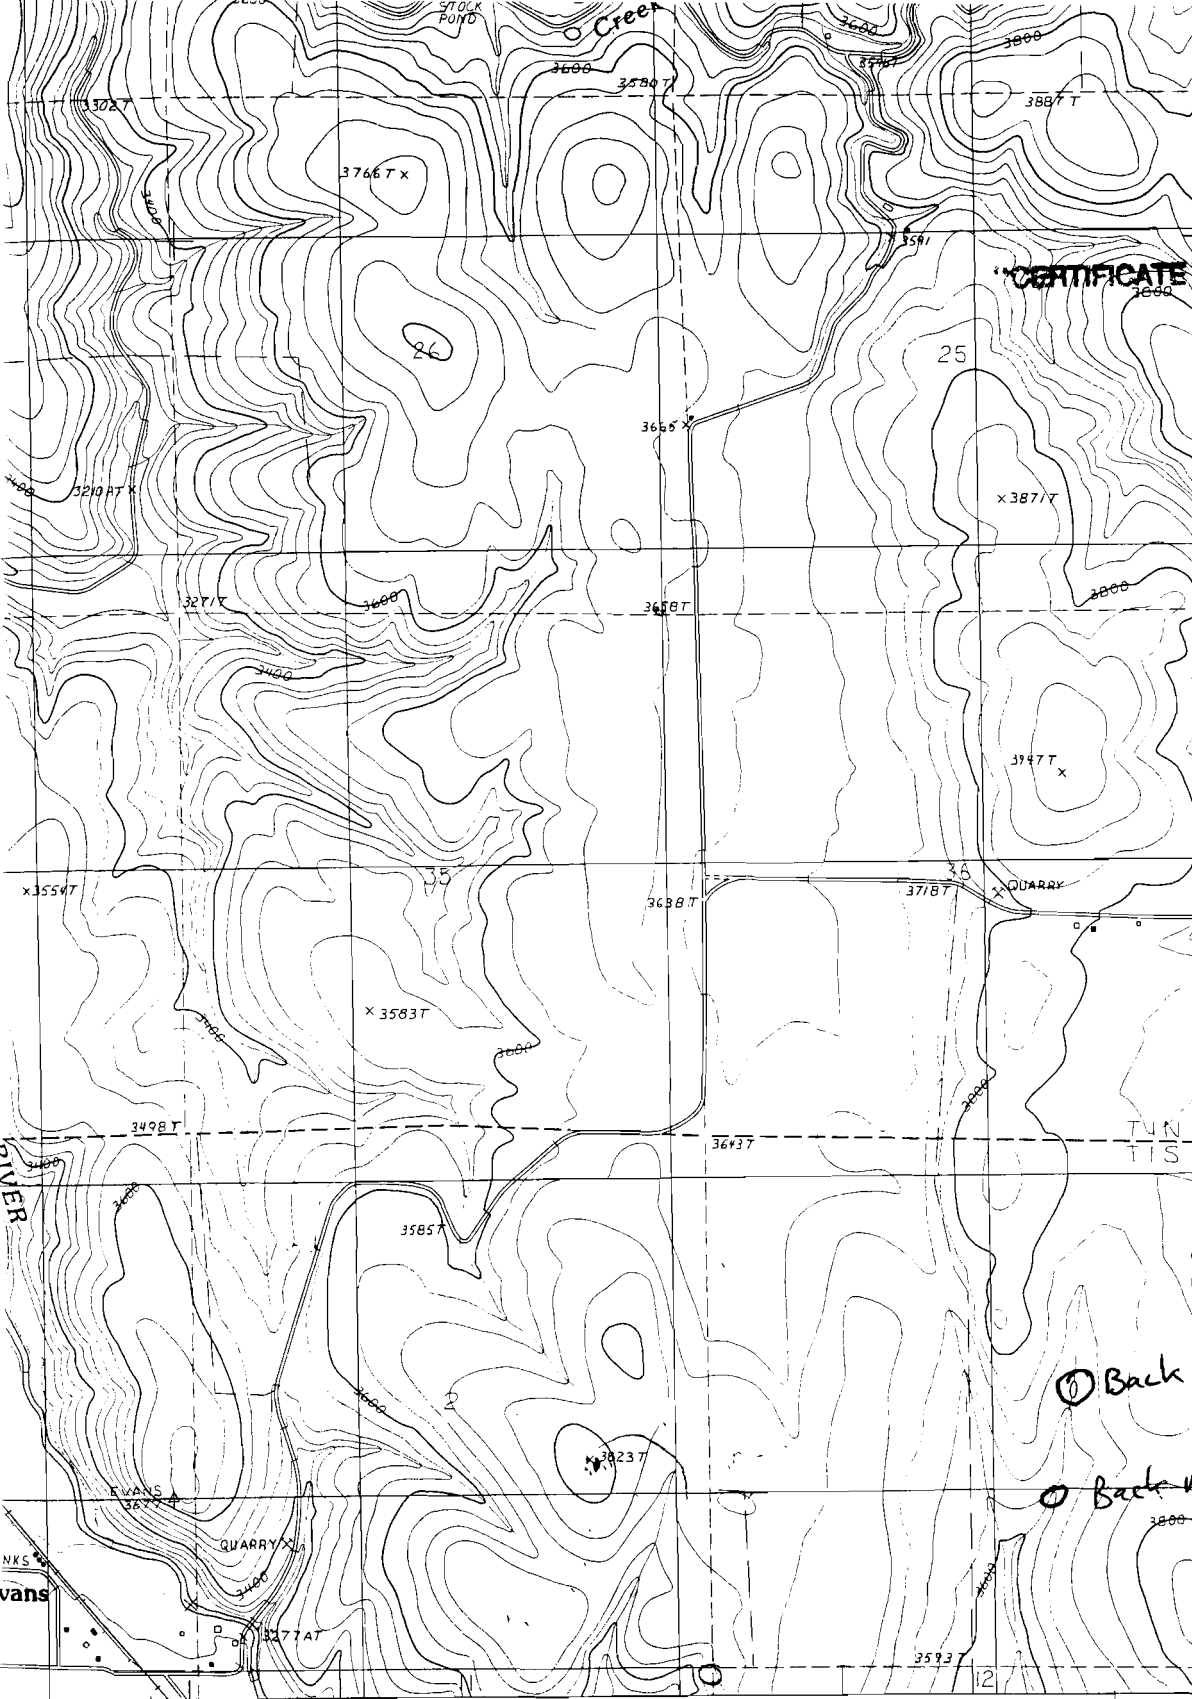

R75292

69464

CERTIFICATE NO.

32' 30"



5042

5041

5040

45° 30'

INTERIOR—GEOLOGICAL SURVEY, RESTON, VIRGINIA—1990

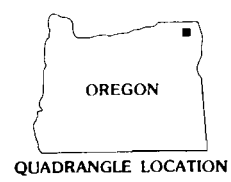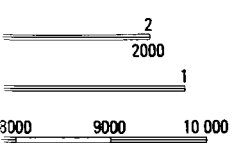

ROAD LEGEND

- Improved Road
- Unimproved Road
- Trail

- Interstate Route
- U. S. Route
- State Route

1	2	3	1 Akers Butte
4		5	2 Sherod Meadows
			3 Sled Springs
			4 Wallowa
			5 Hicks Spring
			6 Fox Point
			7 Lostline

EVANS, OREGON

PROVISIONAL EDITION 1990

R 75292

LOSTINE QUADRANGLE
OREGON-WALLOWA CO.

69464

7.5 MINUTE SERIES (TOPOGRAPHIC)

CERTIFICATE NO.


467

25'

468

469

2800000 FEET 117° 22' 30" 45° 30'

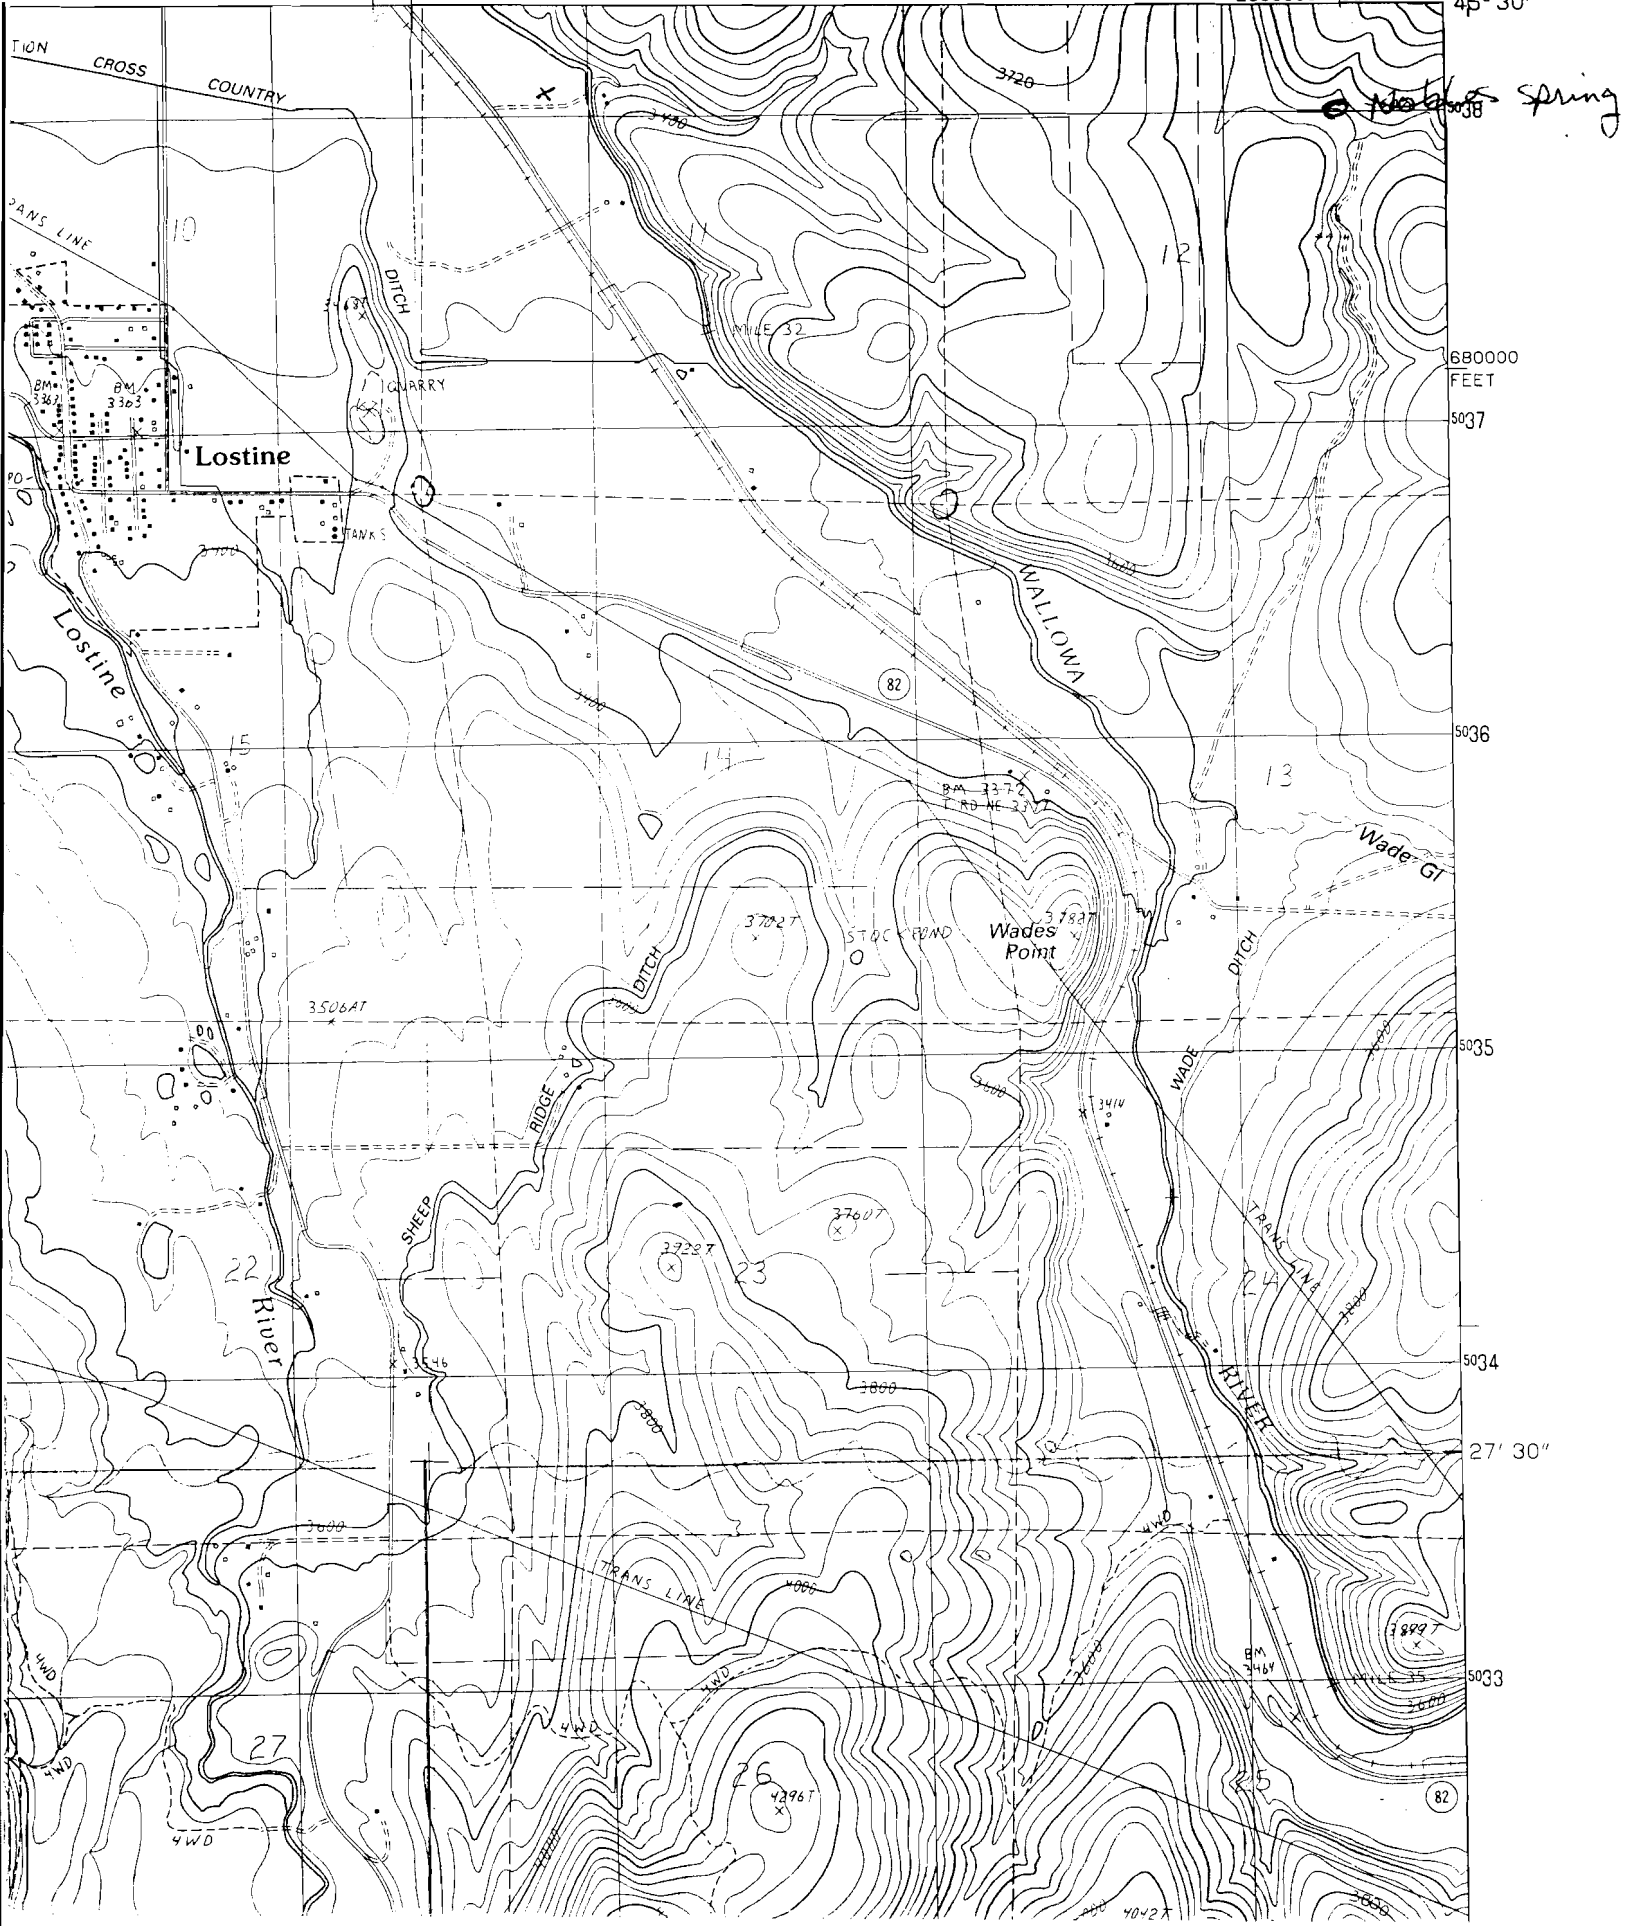

R75292

IS 43
& INDEX

69464

CERTIFICATE NO.

