


IN FIRM WITH PROVISIONS OF
RELEVANT STATUTES ONLY.

CERTIFICATE NO. 69474

21-5


T.11
WALLO
1" = 200'

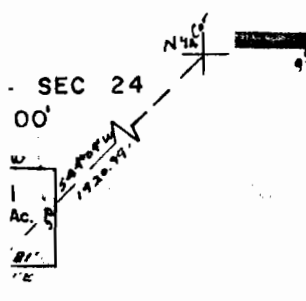


SERT - Sec. 11
1" = 200'




SERT
Sec. 35
1" = 400'

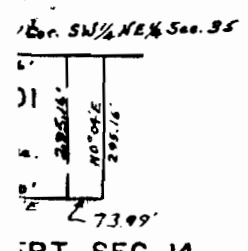


SERT SEC. 14
1" = 400'

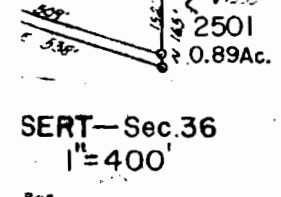

SERT - Sec. 36
1" = 400'

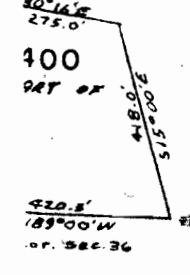

SEE MAP IS 43

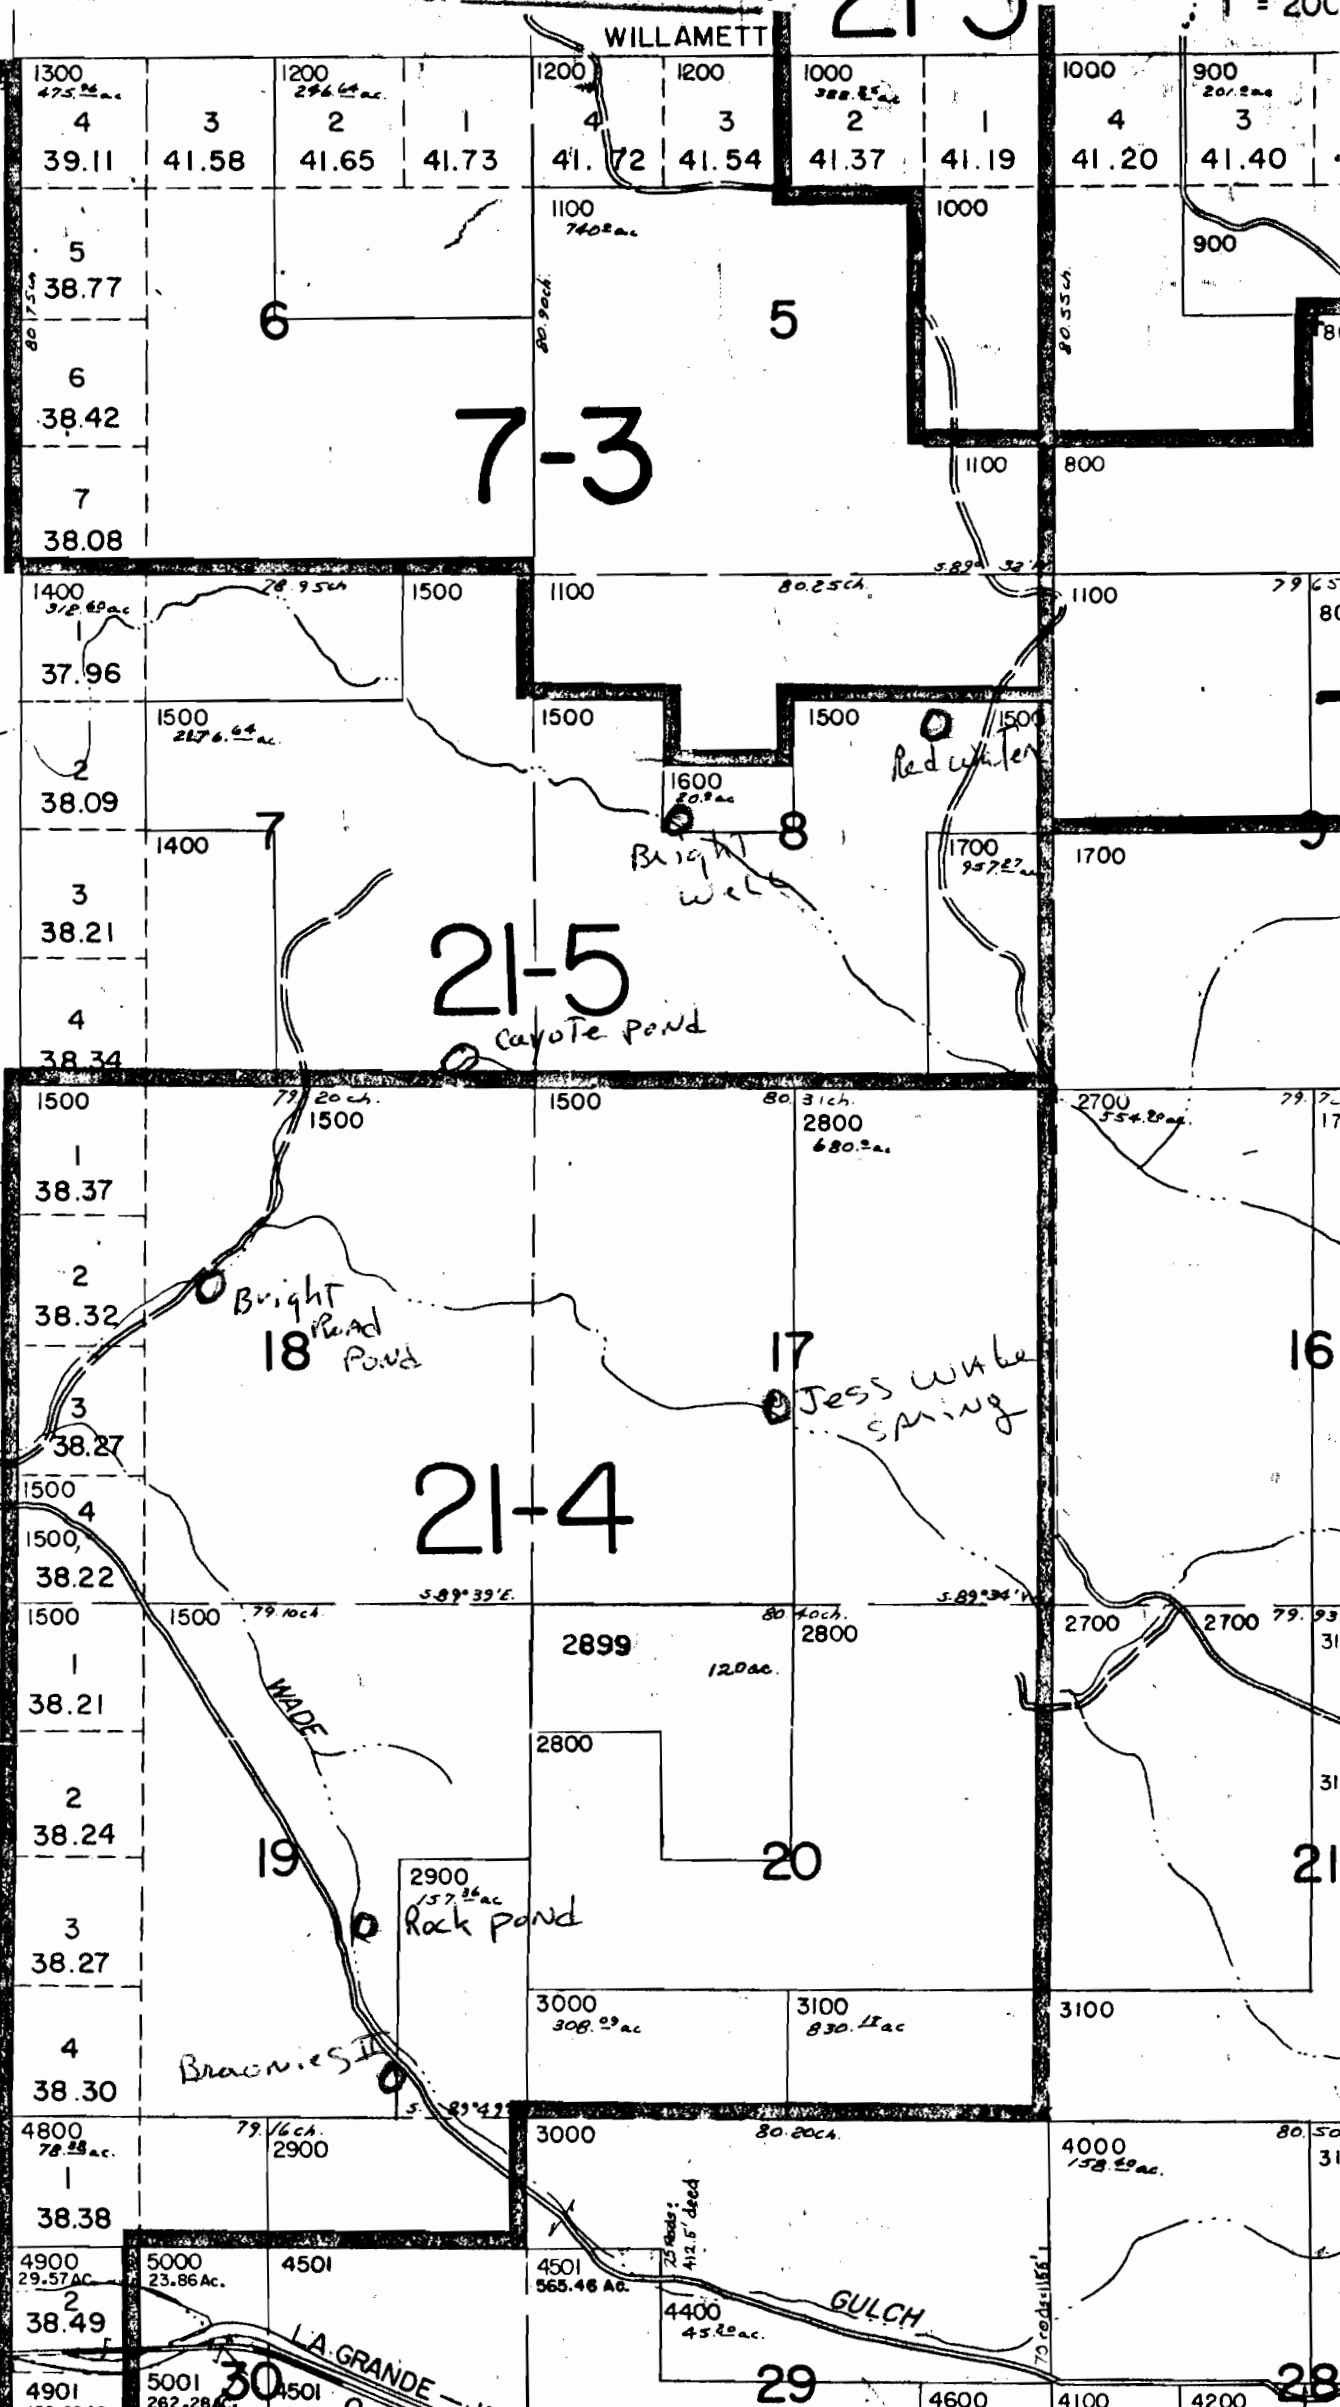

7-3

21-5
Coyote pond

21-4

18
Bright Road Pond

17
Jessie's Spring

2900
157.86 ac
Rock pond

L.A. GRANDE - I.W.A.

CERTIFICATE NO. 69474

