


2575' 1"
1:62,500
ISLED SPRING

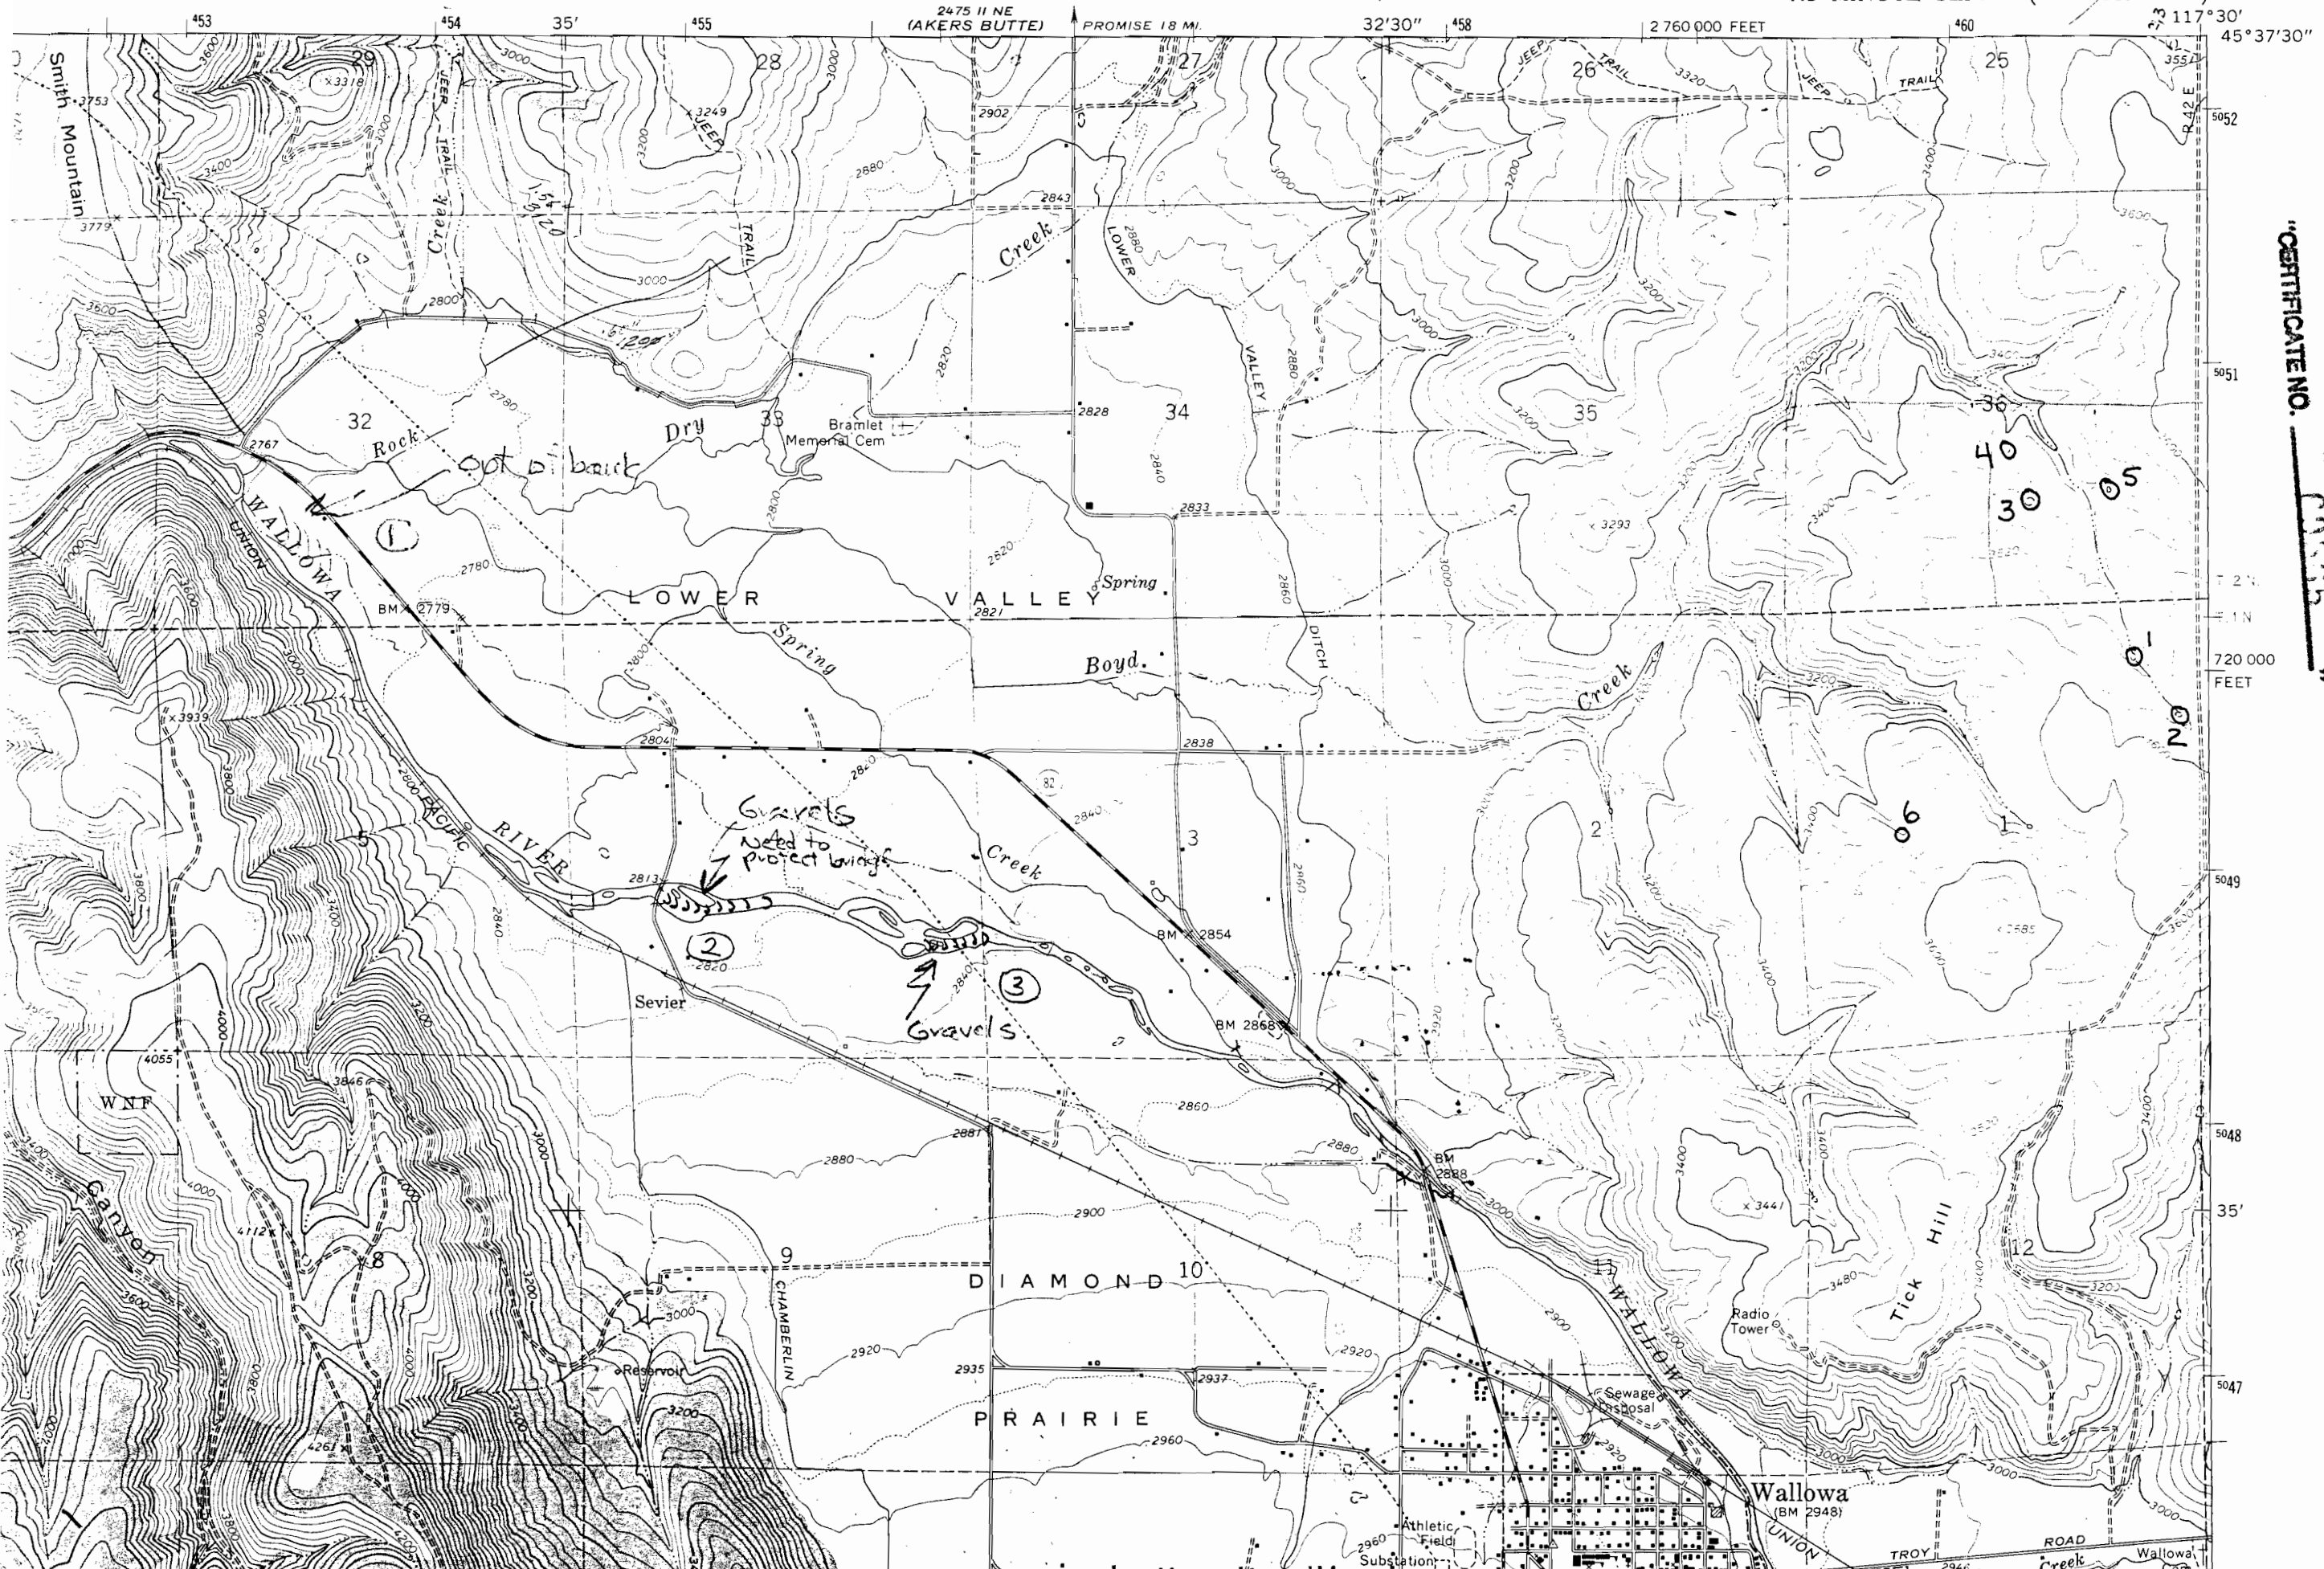

APPROX. No. R-15434
"CERTIFICATE NO. 1055"