

This map is furnished as a convenience in locating property, and the company assumes no liability for any variations as may be disclosed by actual survey.



Eastern Oregon Title, Inc.

ORDER NO.

P.O. Box 446 - 1110 Spring Street - La Grande, Oregon 97850-0446 - Phone 963-0514


89-3967

SEE MAP 3N


Application No. 12-75480

1"=2000'

Permit No.

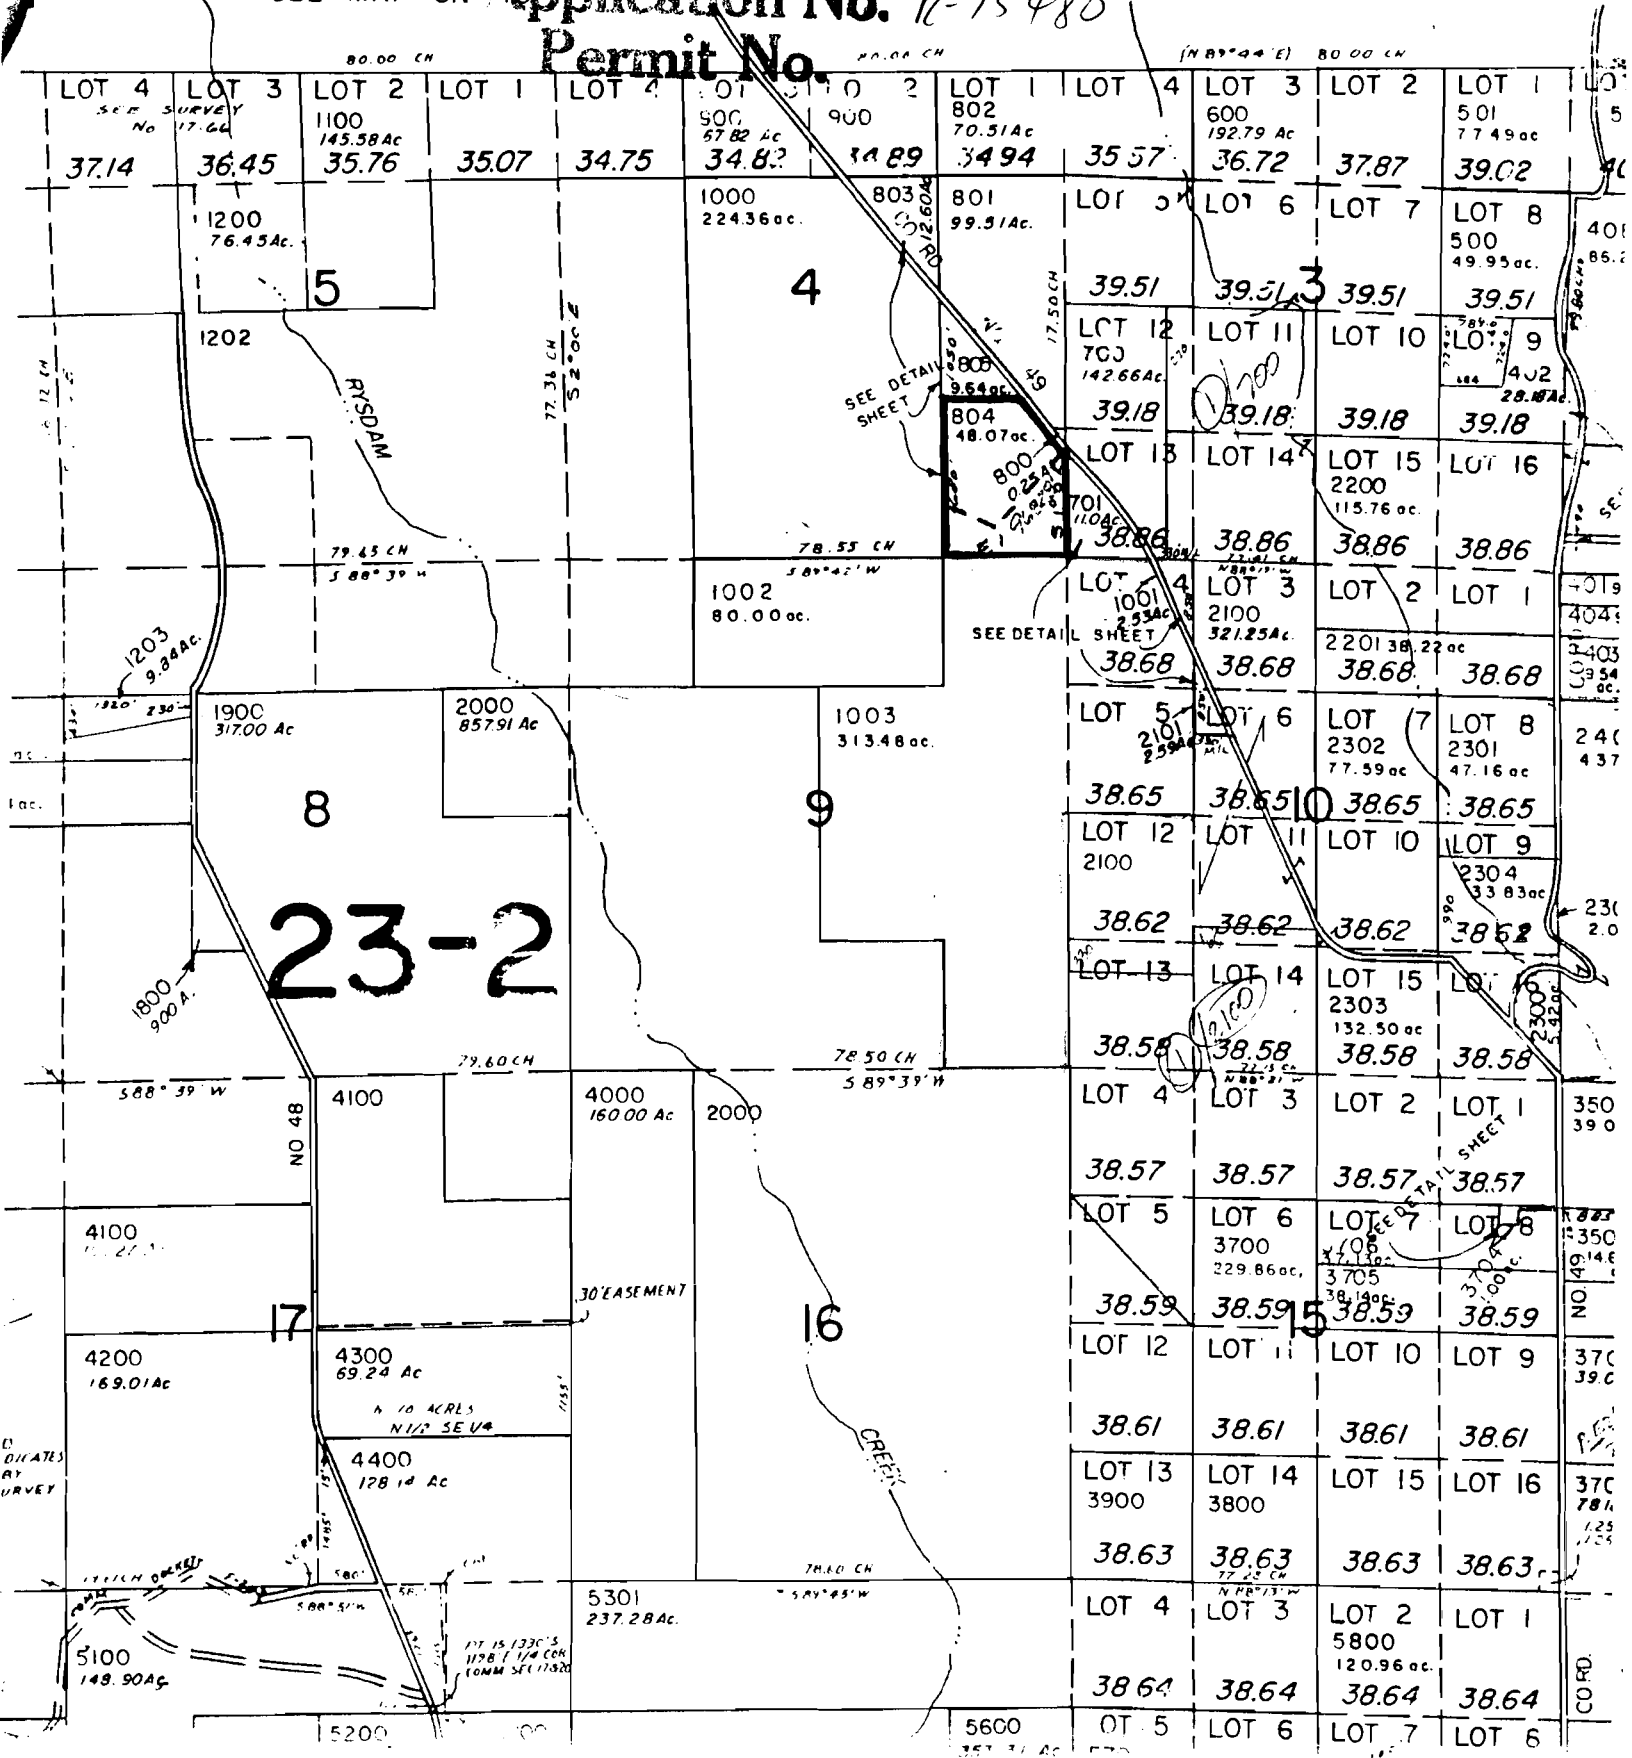

2N-40E
Sec. 9-10
T. 100 B

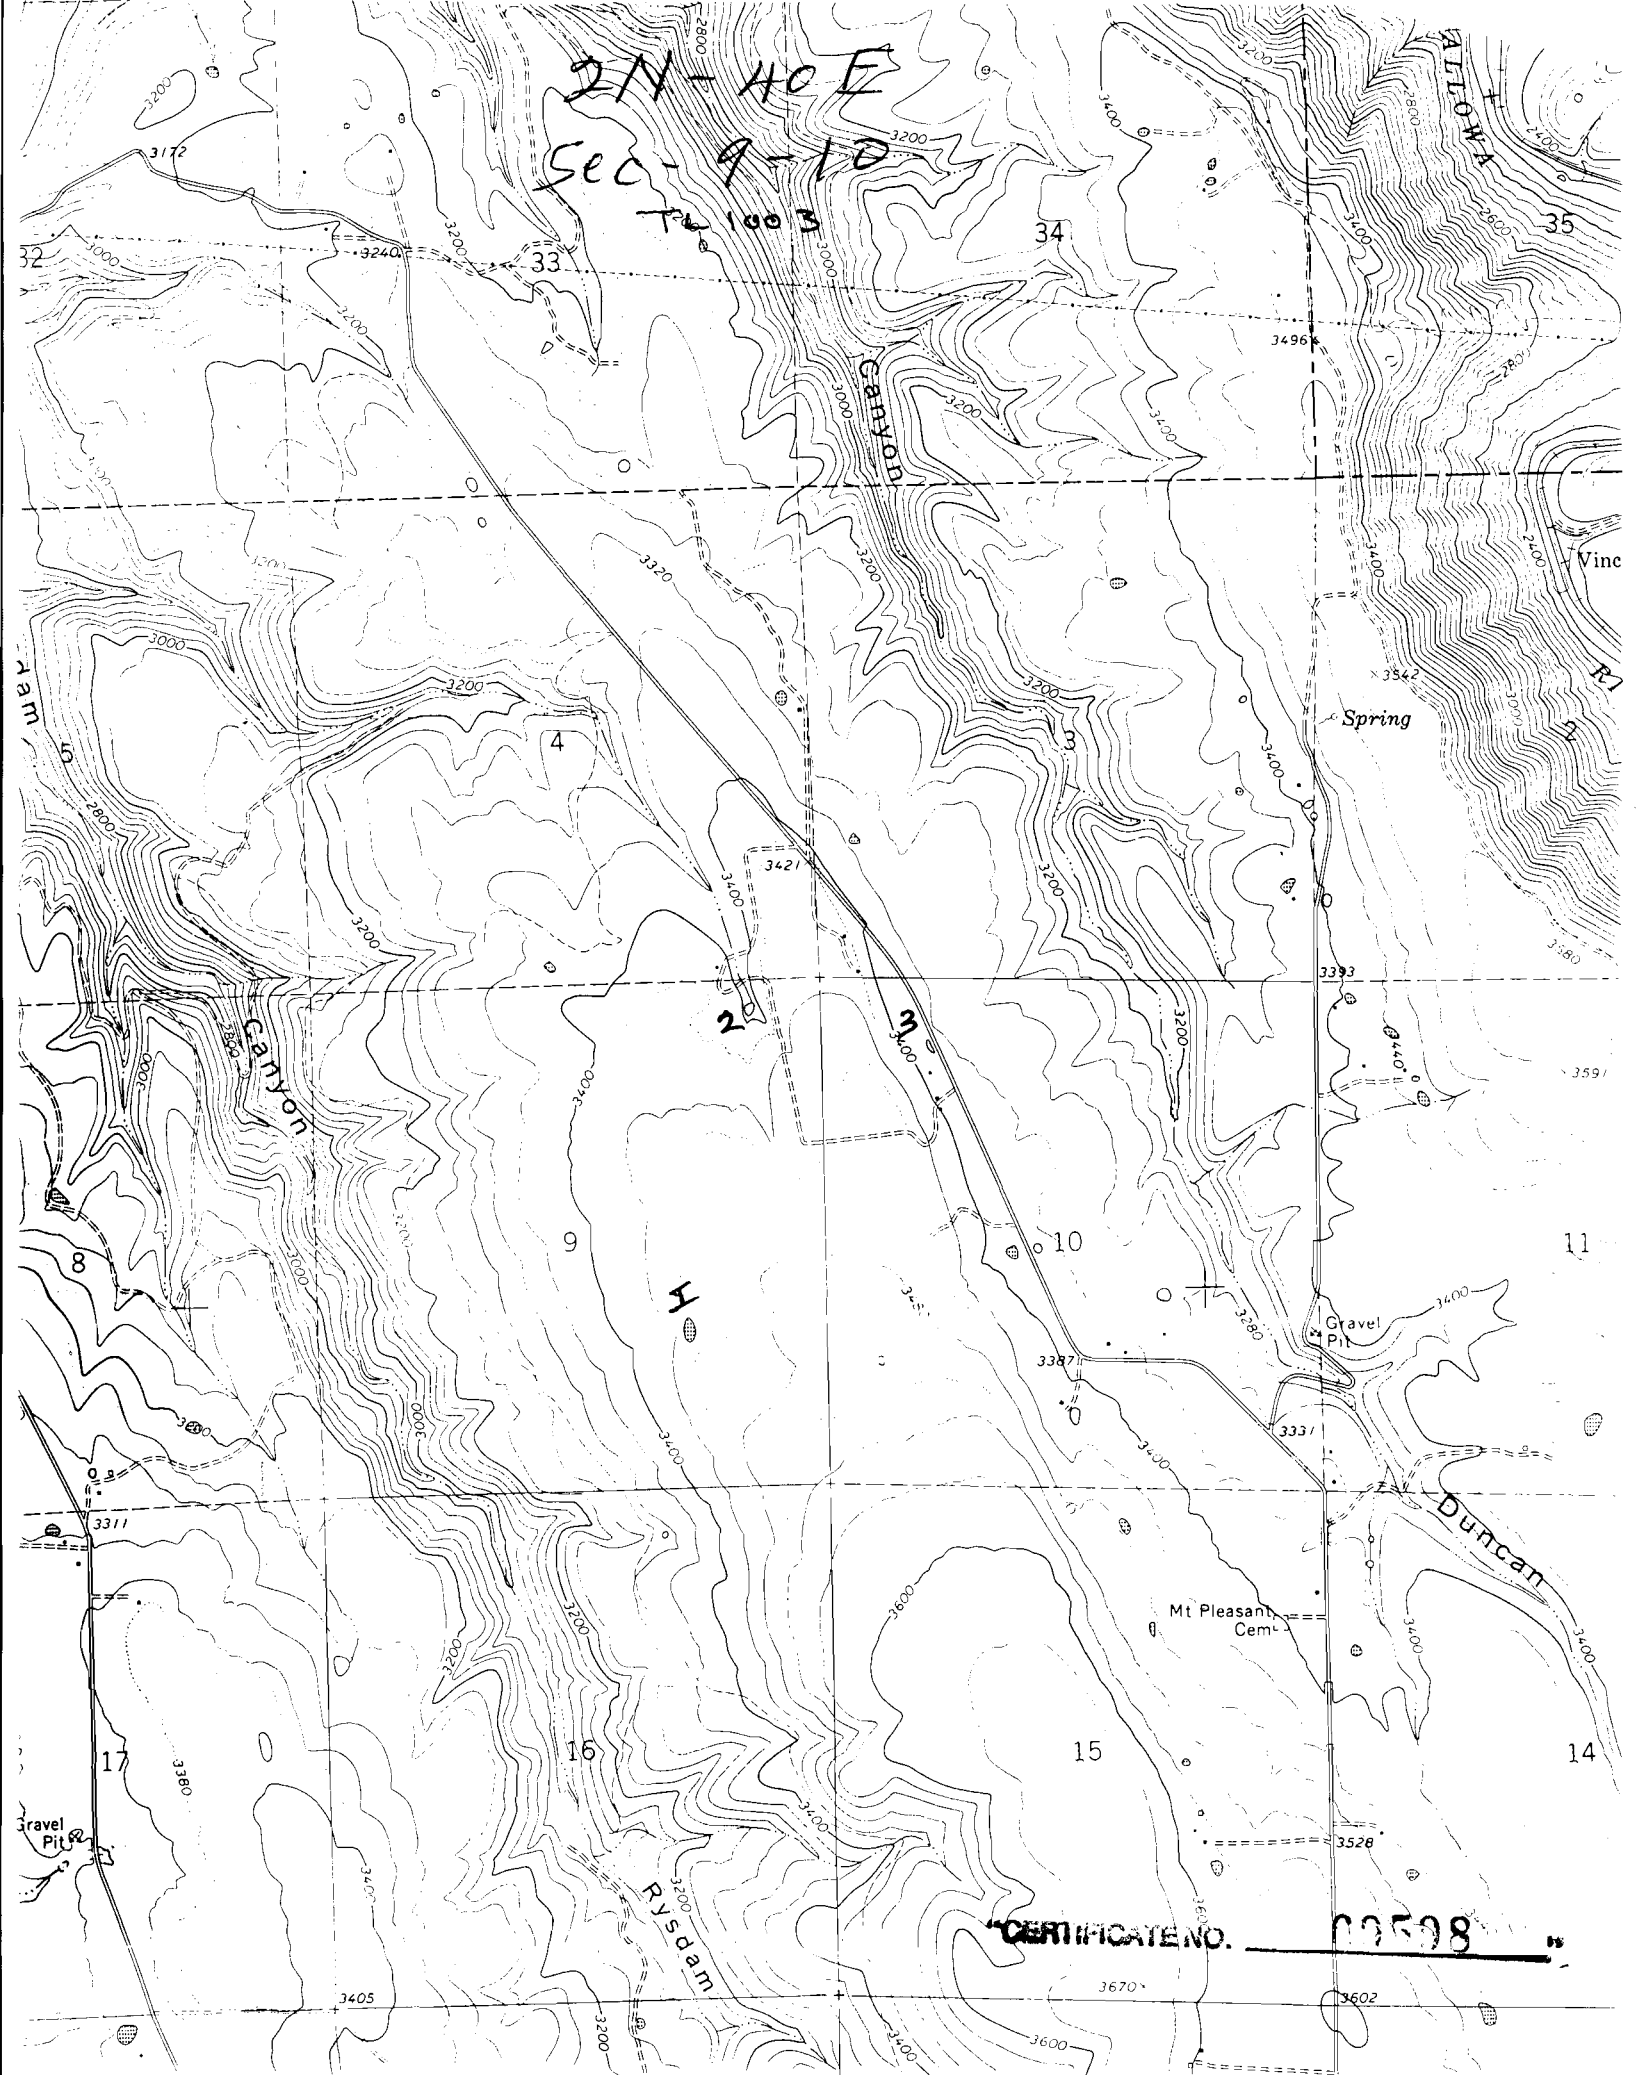

CERTIFICATE NO. 00508