

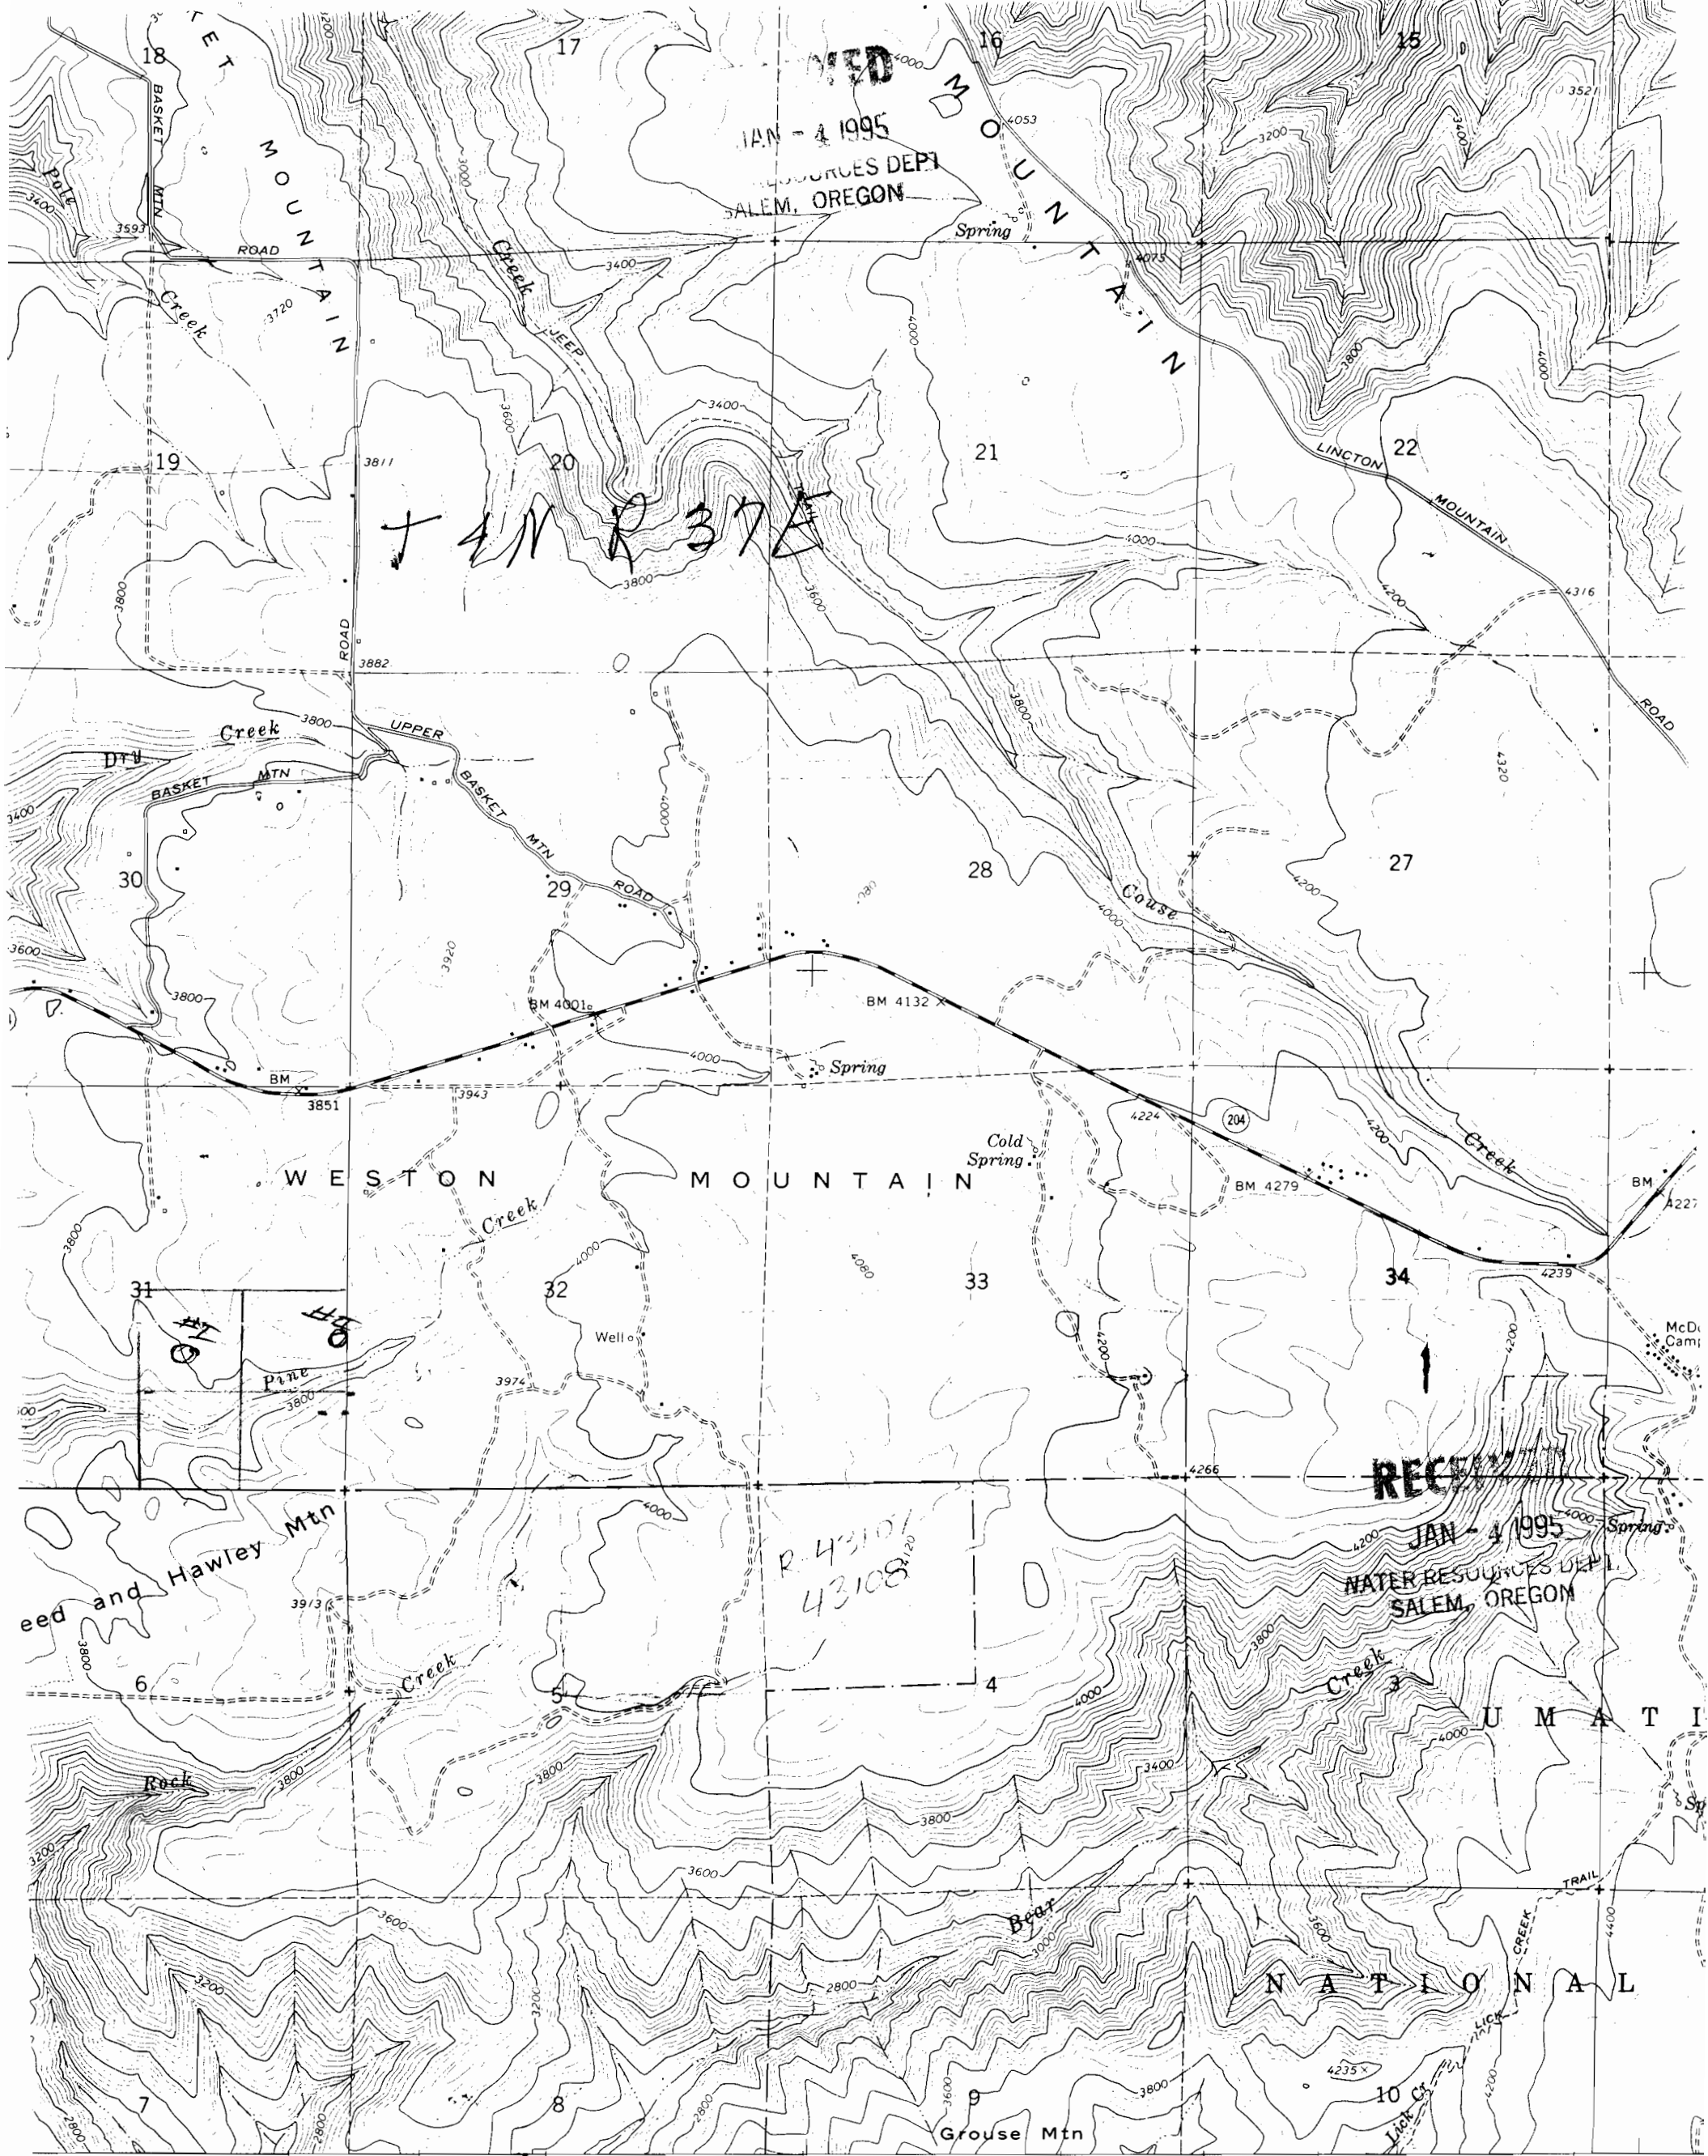


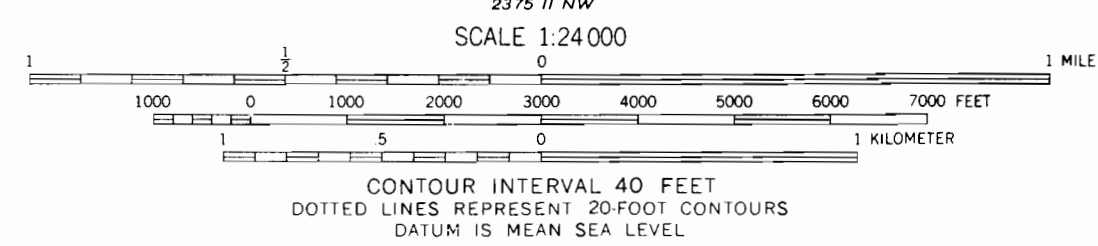

Map compiled, edited, and published by the Geological Survey
by USGS and USC&GS
Photography by photogrammetric methods from aerial
aerial photos taken 1957. Field checked 1963
Map projection. 1927 North American datum
Foot grid based on Oregon coordinate system, north zone
meter Universal Transverse Mercator grid ticks,
shown in blue
Dashed lines indicate selected fence lines
Land lines are omitted because of insufficient data

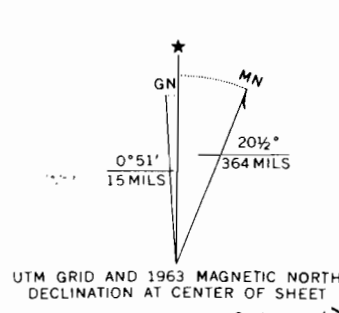

Application No. **R-75601**
Permit No. _____
"CERTIFICATE NO. **69646**"
THIS MAP COMPLIES WITH NATIONAL MAP ACCURACY STANDARDS
FOR SALE BY U. S. GEOLOGICAL SURVEY, DENVER 25, COLORADO OR WASHINGTON 25, D. C.
A FOLDER DESCRIBING TOPOGRAPHIC MAPS AND SYMBOLS IS AVAILABLE ON REQUEST