




DRY POND #1
WEST POND #2
SUMP #3 POND
BANK #4 POND

CERTIFICATE NO. 69723
Application No. R-7565
Permit No.

RECEIVED
DEC 20 1994

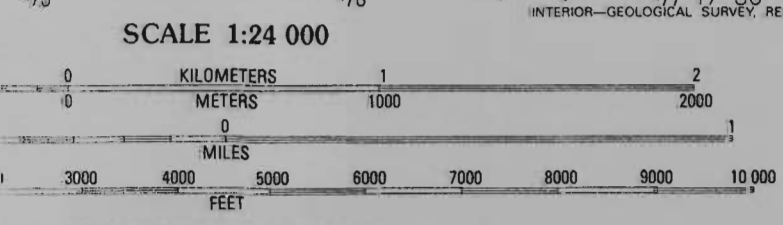

CONTOUR INTERVAL 40 FEET

To convert meters to feet multiply by 3.2808
To convert feet to meters multiply by .3048



QUADRANGLE LOCATION

ROAD LEGEND
Improved Road
Unimproved Road
Trail
Interstate Route U. S. Route State Route

1	2	3	1 Sherod Meadows
			2 Sled Springs
			3 Roberts Butte
4		5	4 Evans
			5 Elk Mountain
			6 Lostine
6	7	8	7 Enterprise
			8 Joseph NW

HICKS SPRING, OREGON
PROVISIONAL EDITION 1990

COMPLIES WITH NATIONAL MAP ACCURACY STANDARDS
L SURVEY, DENVER, COLORADO 80225, OR RESTON, VIRGINIA 22092

ADJOINING 7.5' QUADRANGLE NAMES

45117-E3-TF-024