


Application No R-75700

Permit No. _____

Weyerhaeuser Company
Willamette Timberlands

"CERTIFICATE NO. 69736"

Water Storage Site Map

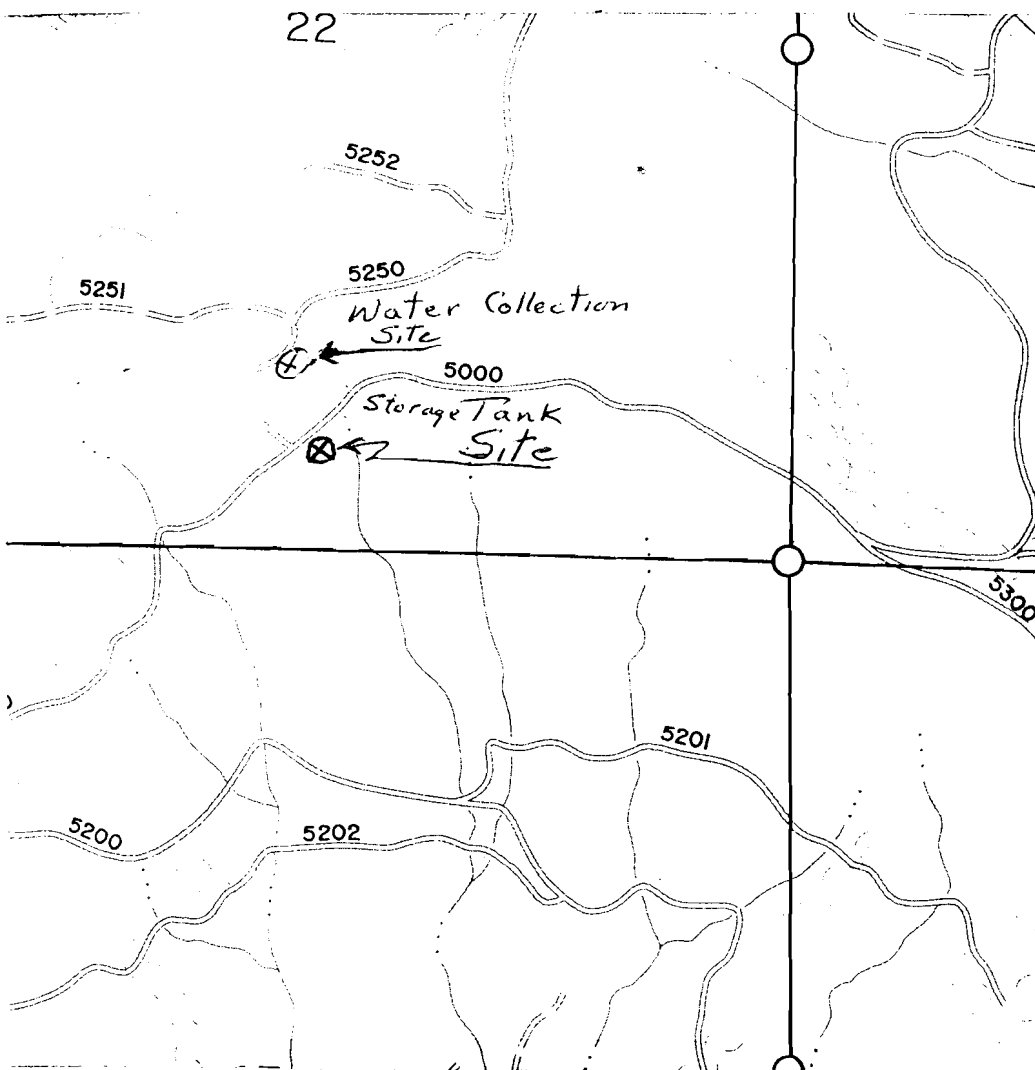

Map Scale: 1" = 1000 feet

Section 22

Township 21 South

Range 1 West

Forty SW 1/4 SE 1/4

River Basin Row River
(Coast Fork Willamette)

RECEIVED

DEC 20 1994

WATER RESOURCES DEPT.
SALEM, OREGON

Gallons of Water Stored: 5,000

Purpose of Impounded Water:

1. Emergency Fire Suppression


2. _____

Application No. R-75710
Permit No.

Weyerhaeuser Company
Willamette Timberlands

CERTIFICATE NO. 69736

Water Storage Site Map

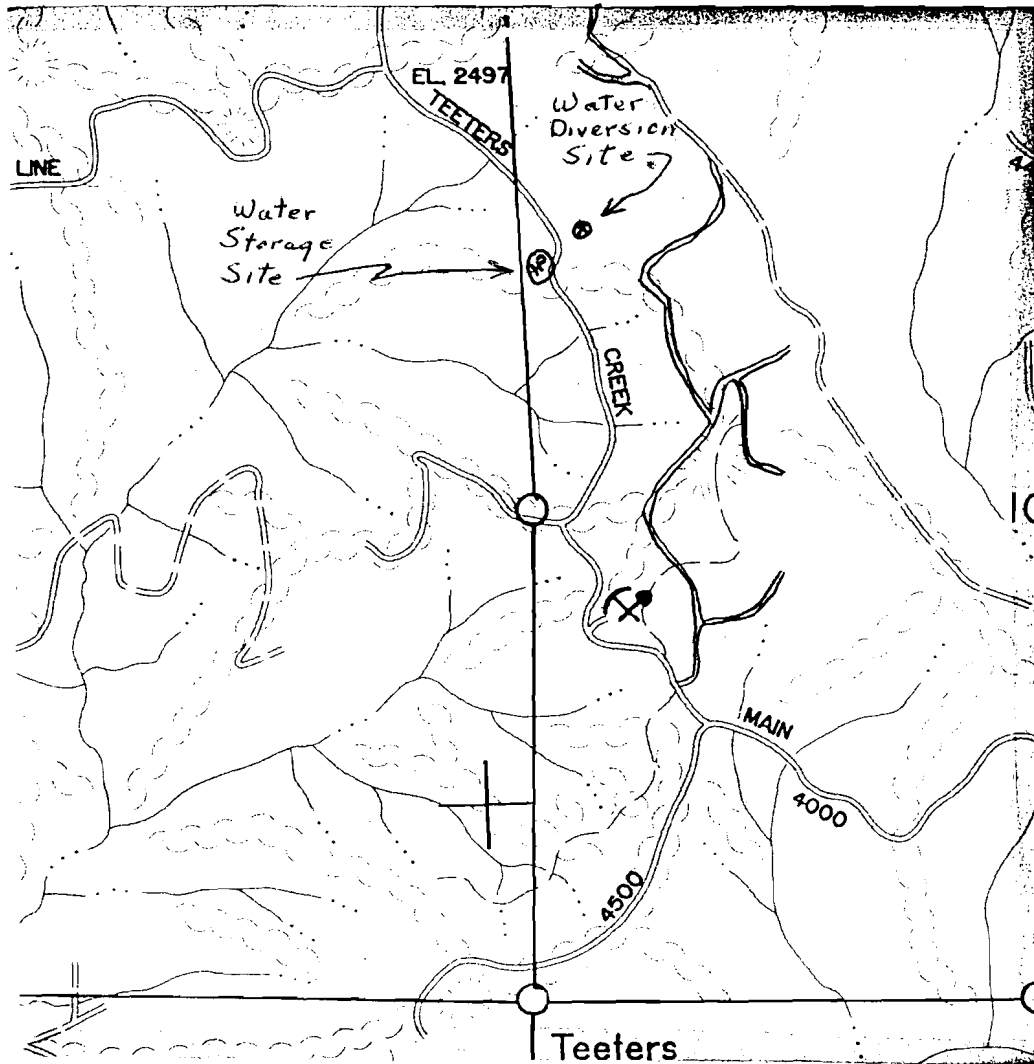

N↑

Map Scale: 1" = 1000 feet

Section 10

Township 21 South

Range 1 West

Fortys - West $\frac{1}{2}$ NW $\frac{1}{4}$

River Basin Roa River
(Coast Fk. Willamette Riv.)

RECEIVED

DEC 20 1994

WATER RESOURCES DEPT.
SALEM, OREGON

Gallons of Water Stored: 10,000

Purpose of Impounded Water:


1. Emergency Fire Suppression
2. _____

Application No R-75710
Permit No.

"CERTIFICATE NO. 69736"

Weyerhaeuser Company
Willamette Timberlands

Water Storage Site Map

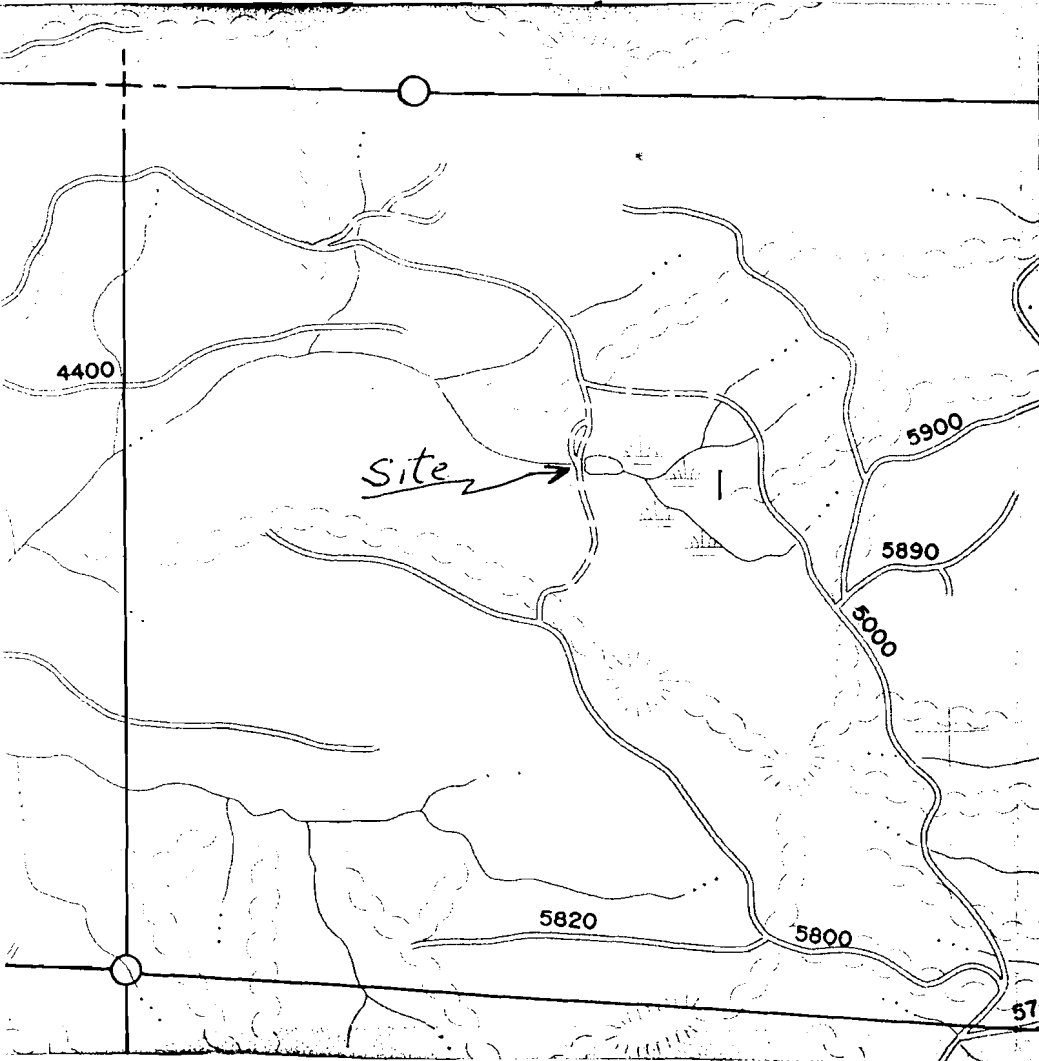

N↑

Map Scale: 1" = 1000 feet

Section 1

Township 21 South

Range 1 West

Forty SE 1/4 NW 1/4

River Basin Row River

(Coast Fork Willamette)

RECEIVED

DEC 20 1994

WATER RESOURCES DEPT.
SALEM, OREGON

Gallons of Water Stored: 500,000

Purpose of Impounded Water:

1. Emergency Fire Suppression
2. _____