


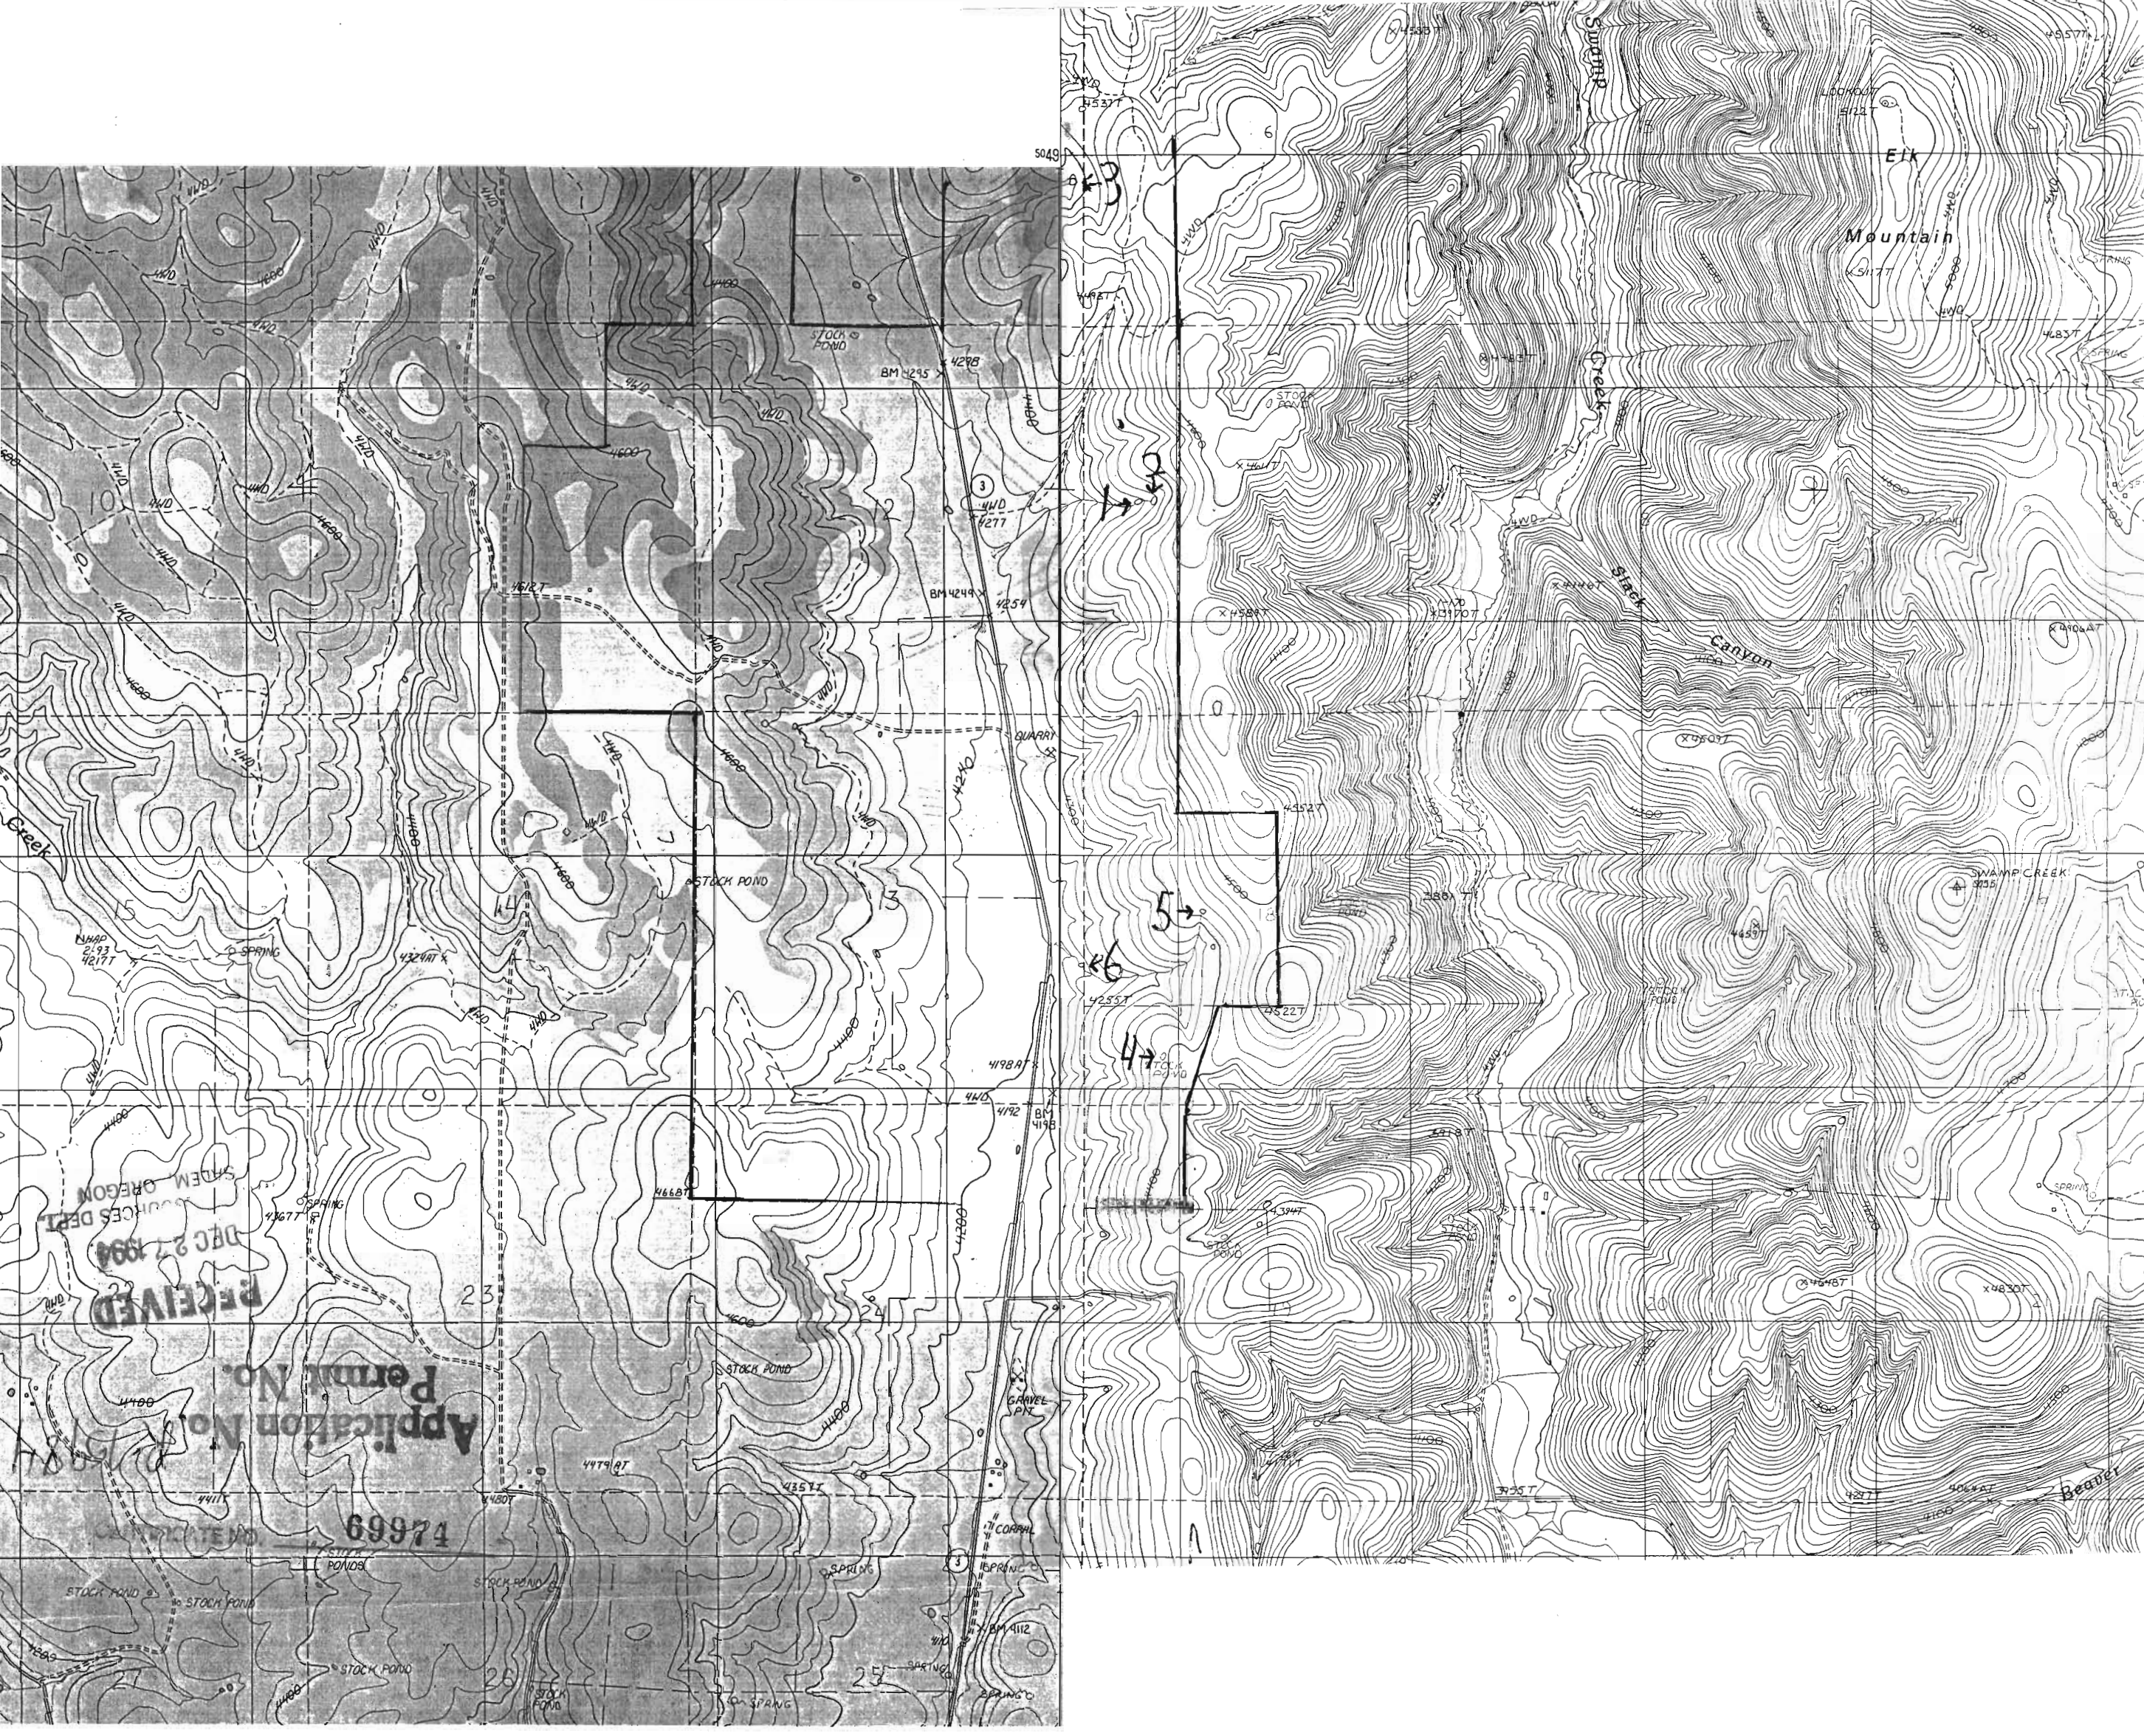

RECEIVED
DEC 27 1994
SADEN OREGON
SOURCES DEPT.