


Application No. *R-26075*
Permit No.

CERTIFICATE NO.

70062

DEC 27 1991

WATER
SALM. OREGON

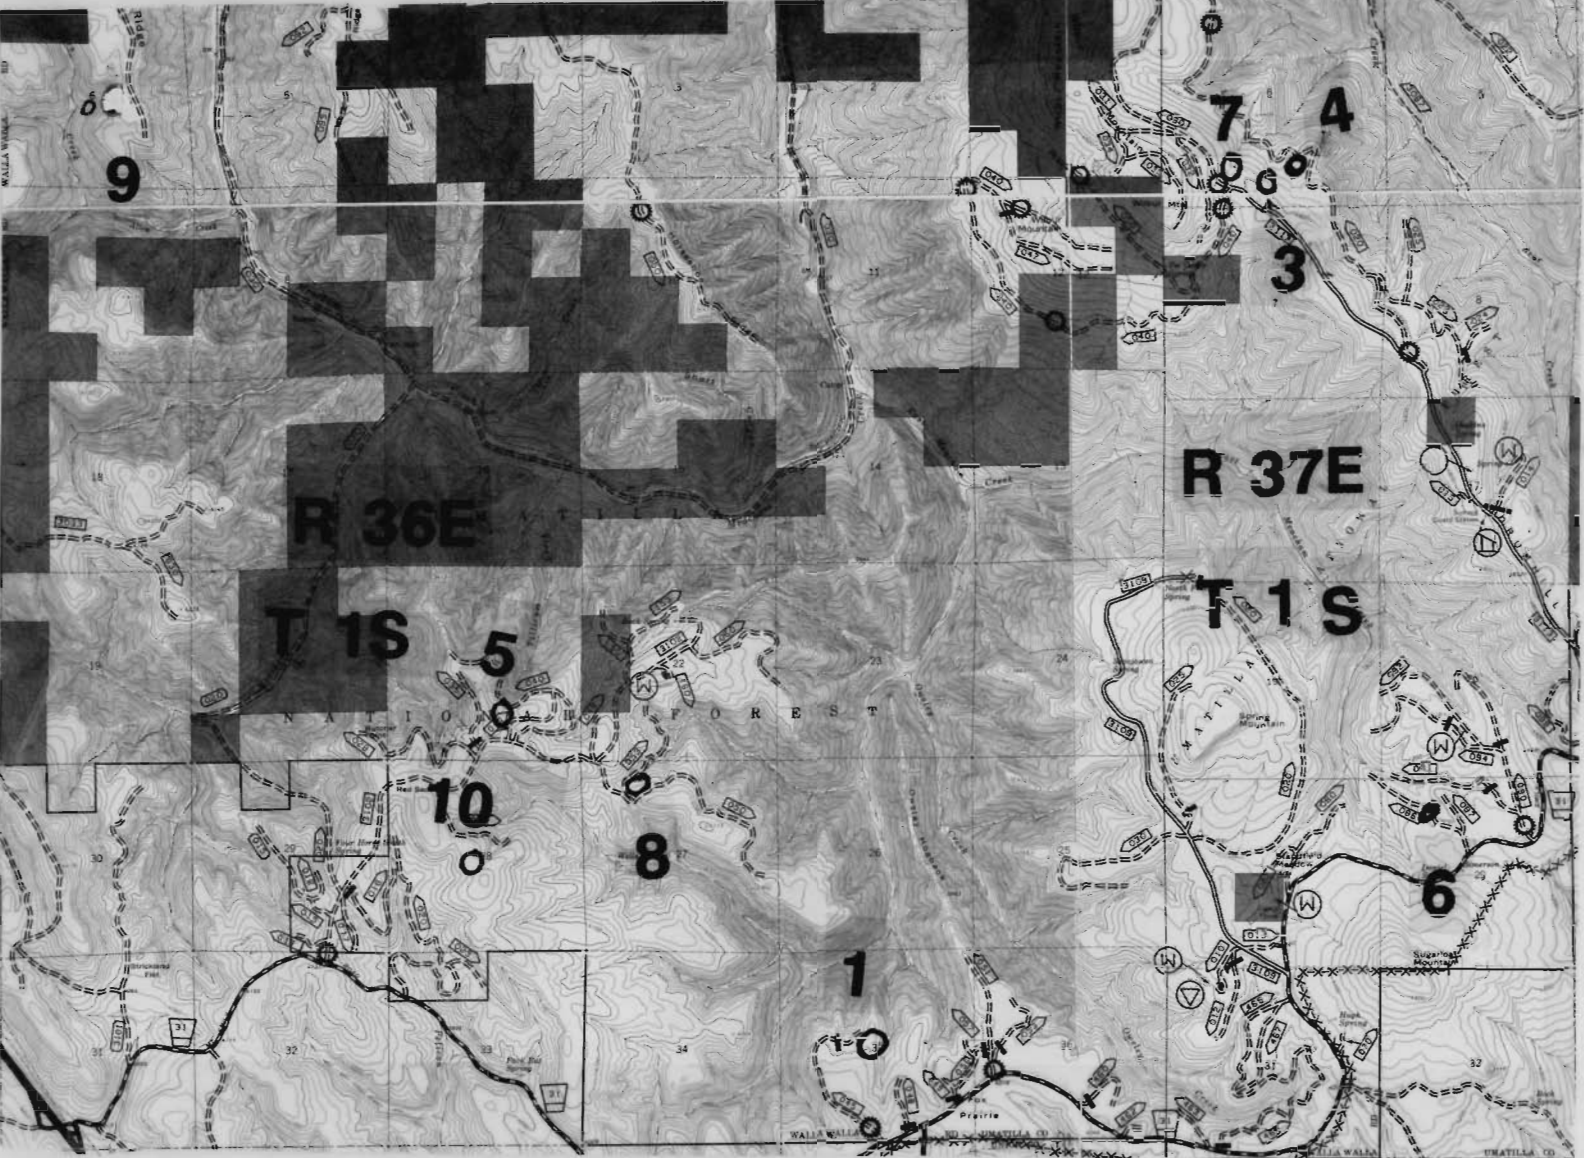

Application No. R-76675
Permit No.

"CERTIFICATE NO. 70062"

