



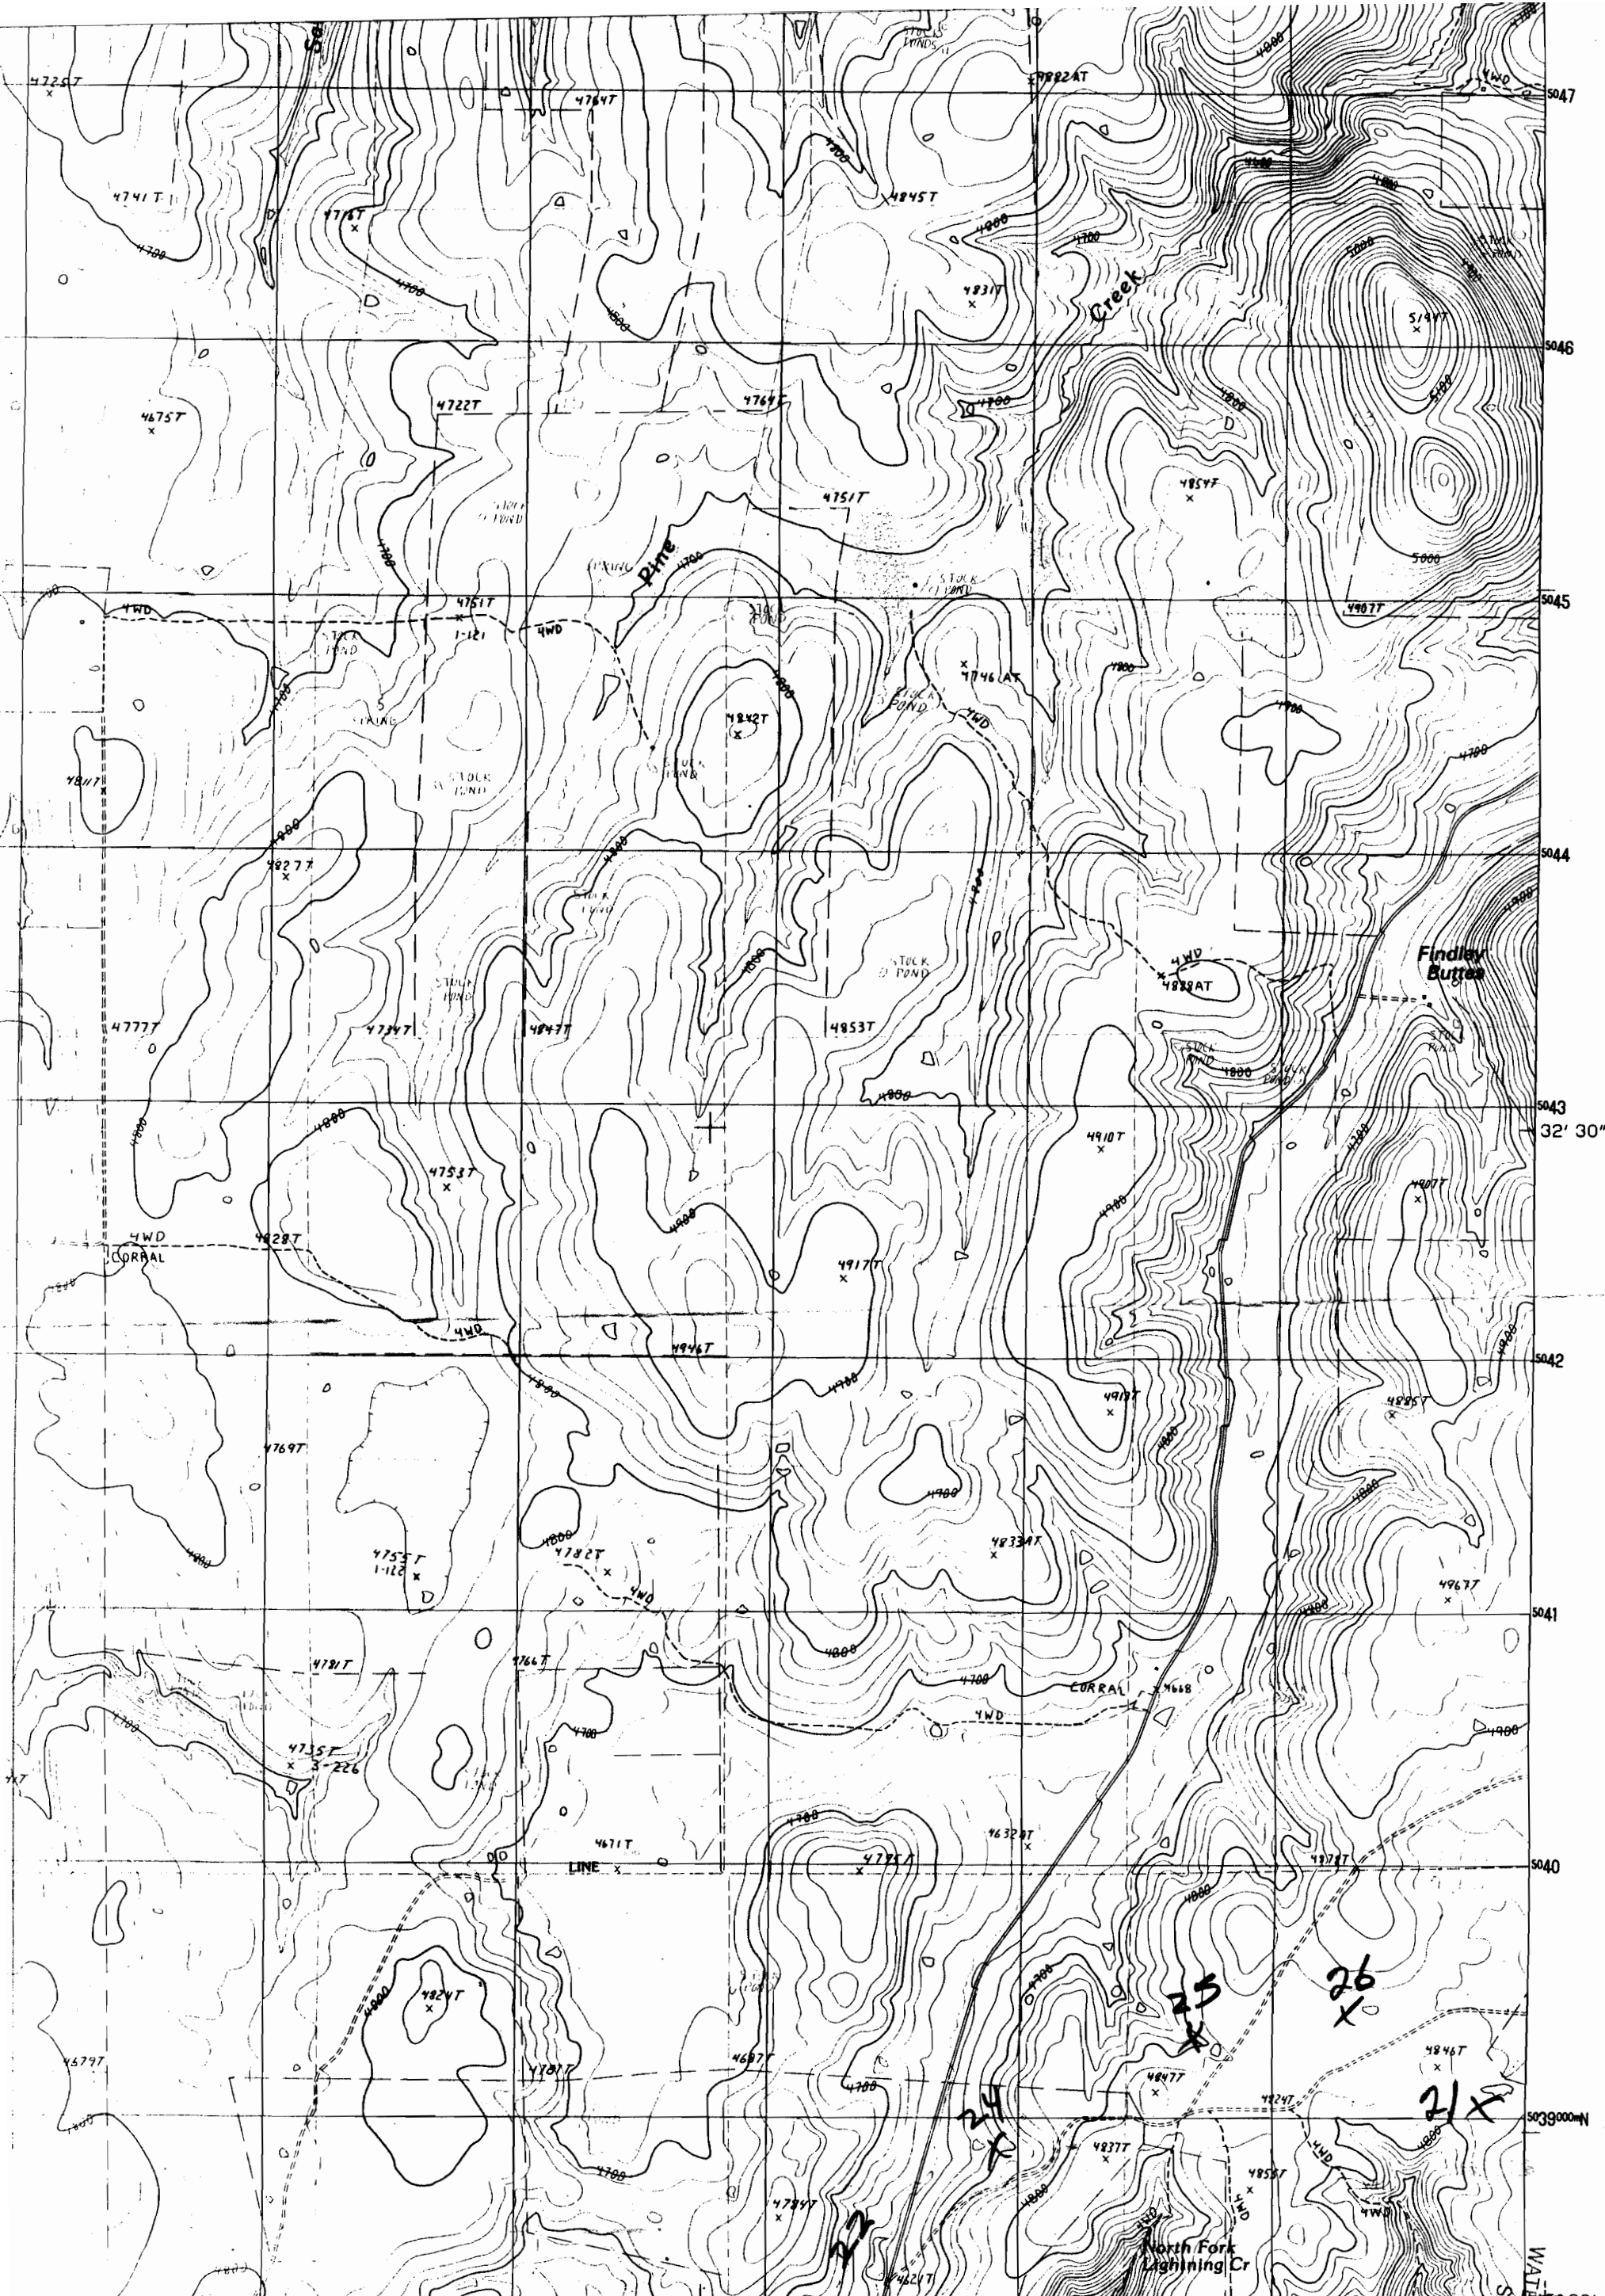

SCALE 1:24 000

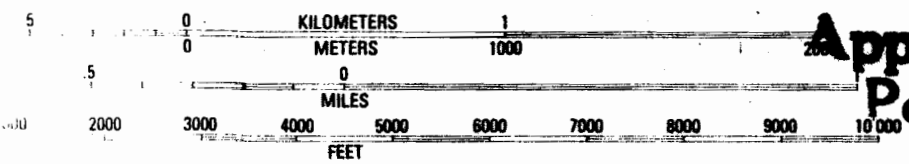

CONTOUR INTERVAL 20 FEET

To convert meters to feet multiply by 3.2808

INTERIOR GEOLOGICAL SURVEY CERTIFICATE NO. 70083

Application No. R-76096
Permit No.

QUADRANGLE LOCATION

ROAD LEGEND

- Improved Road
- Unimproved Road
- Trail
- Interstate Route
- U. S. Route
- State Route

1	2	3
1 Roberts Butte		
2 Greenwood Butte		
3 Zumwalt		
4 Elk Mountain		

RECEIVED
DEC 27 1994
WATER RESOURCES DIVISION
SALEM, OREGON

