



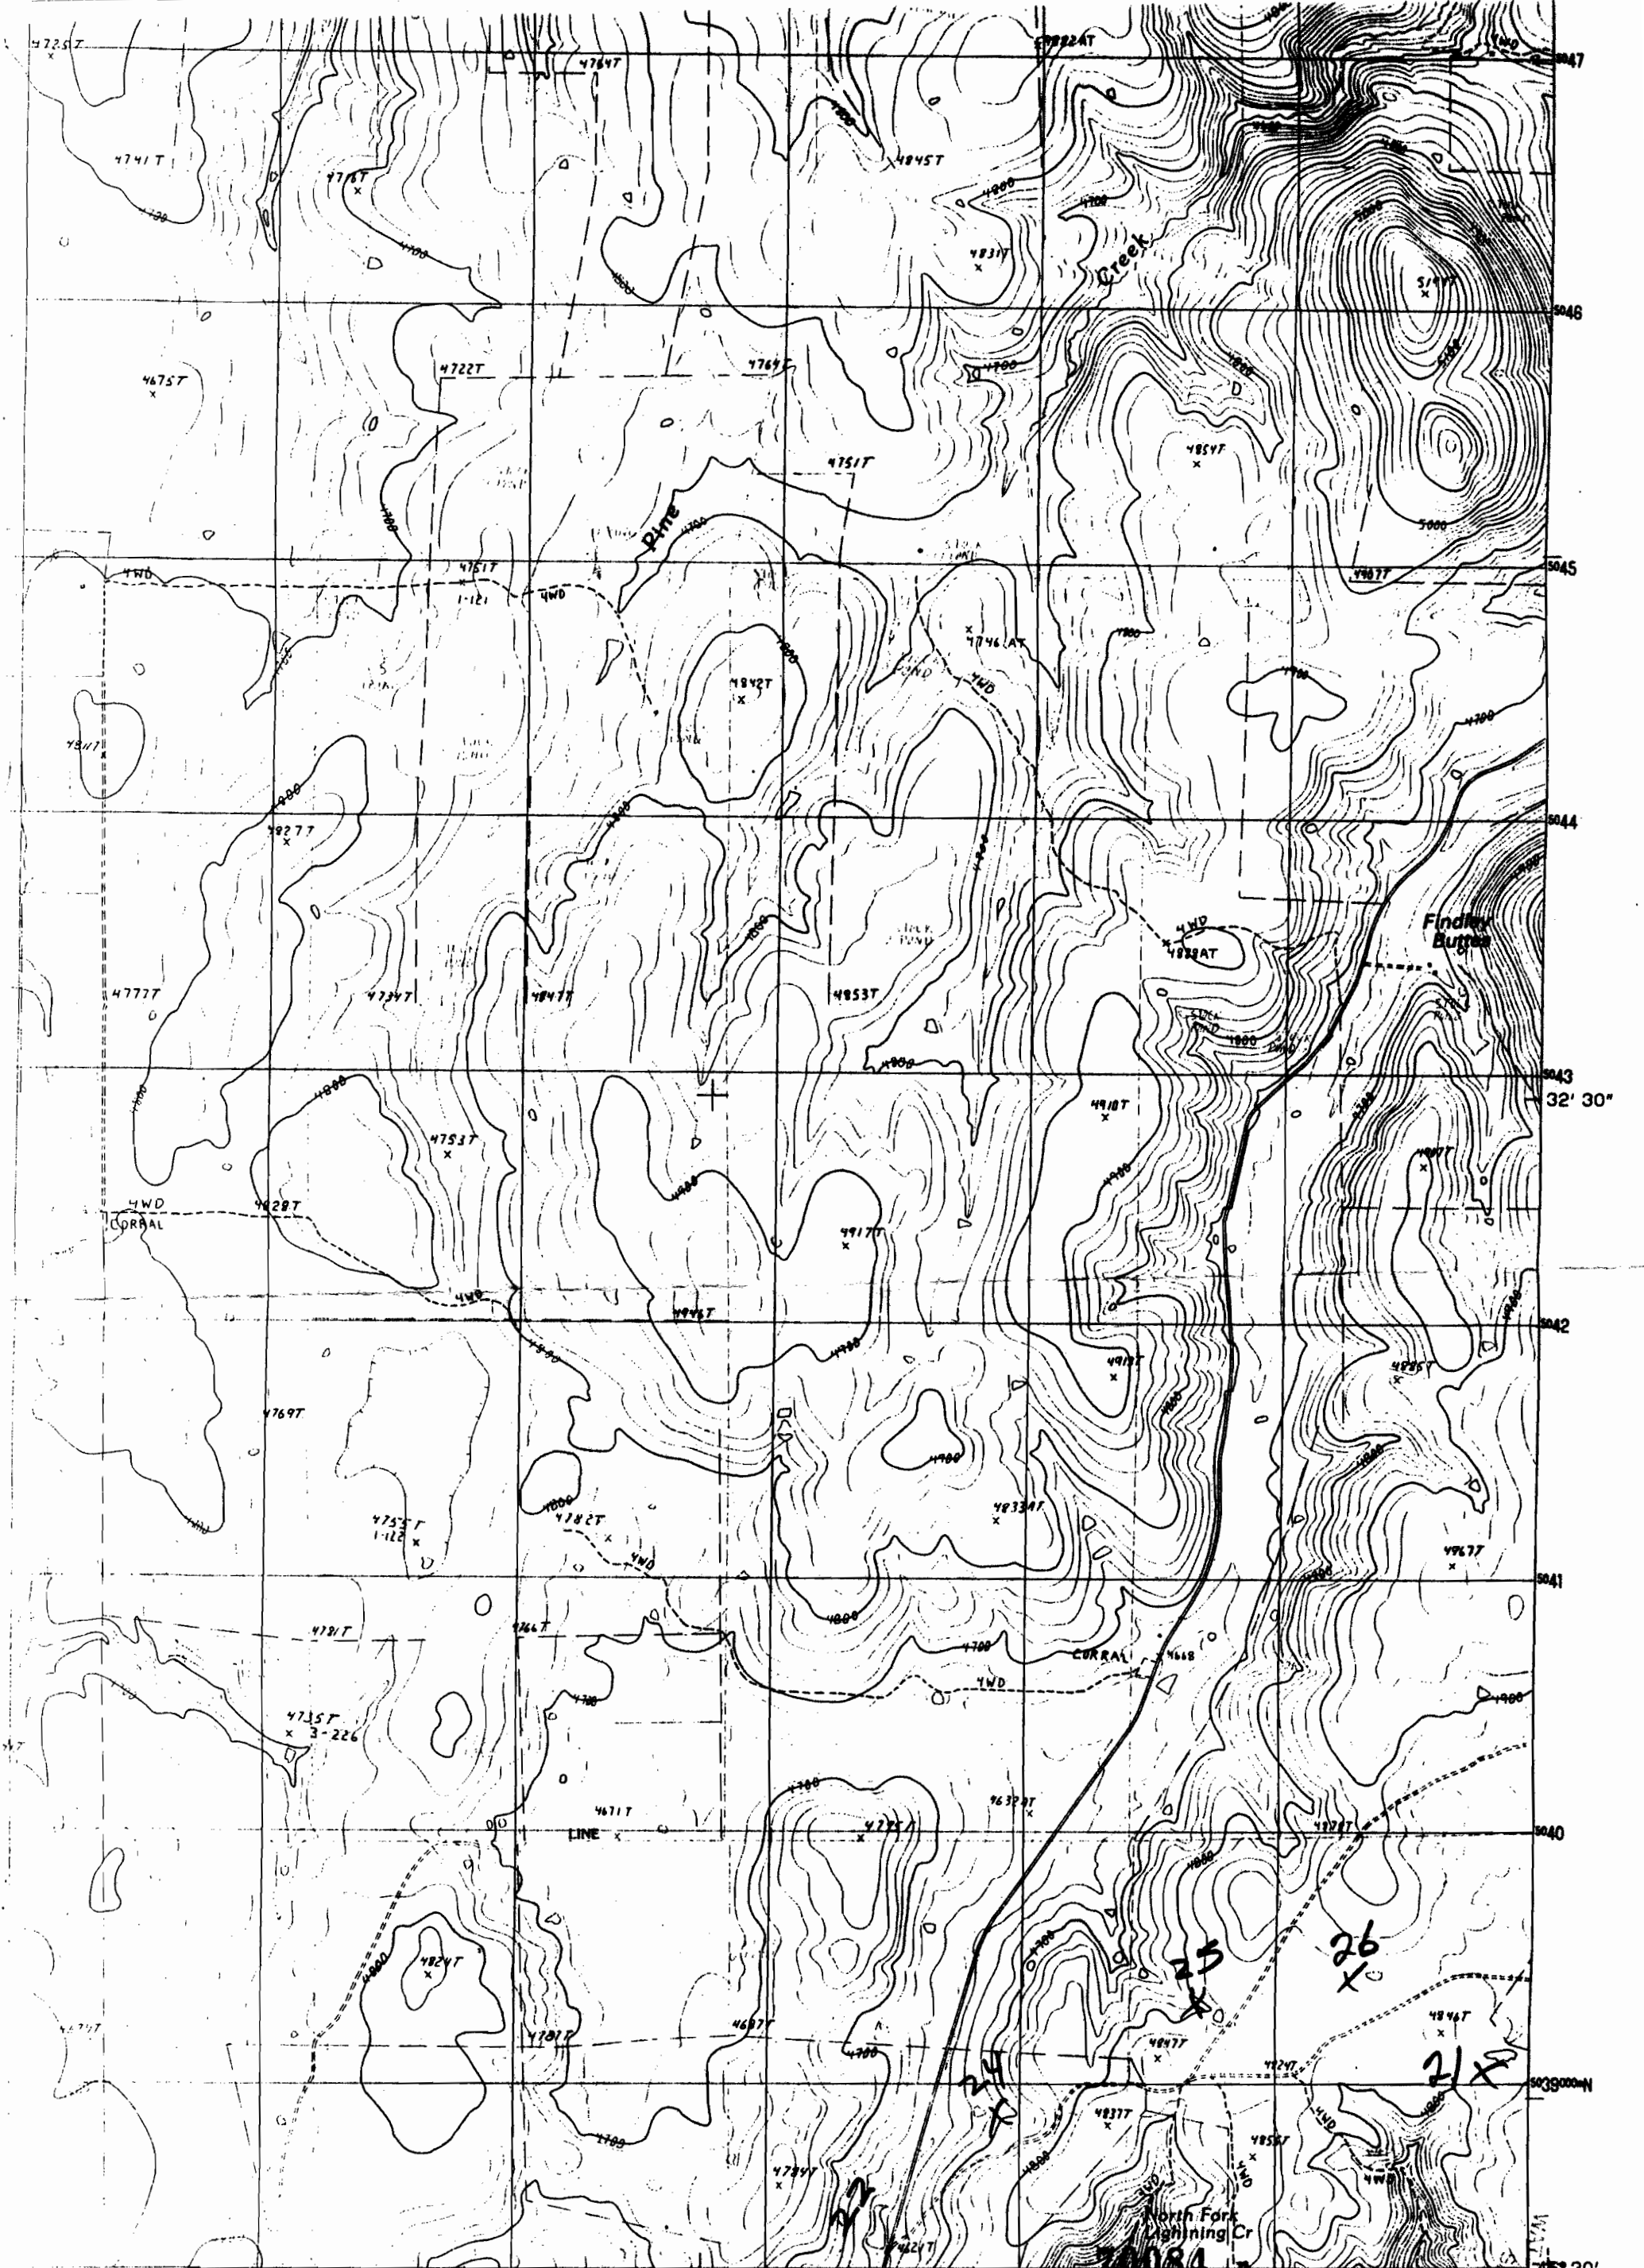

SCALE 1:24 000

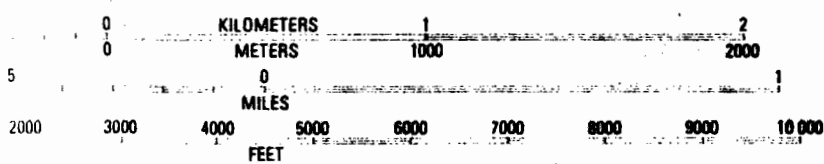

CONTOUR INTERVAL 20 FEET

To convert meters to feet multiply by 3.2808
To convert feet to meters multiply by .3048

INTERIOR - GEOLOGICAL SURVEY, RESTON, VIRGINIA - 1980

CERTIFICATE NO. 408
Application No. R-76097
Permit No.

QUADRANGLE LOCATION


1	2	3	1 Roberts Butte
			2 Greenwood Butte
			3 Zumwalt
4		5	4 Elk Mountain
			5 Findley Butte

ROAD LEGEND

- Improved Road
- Unimproved Road
- Trail
- Interstate Route ○ U. S. Route ○ State Route

ELK MOUNTAIN SE OREGON

DEC 27 1994

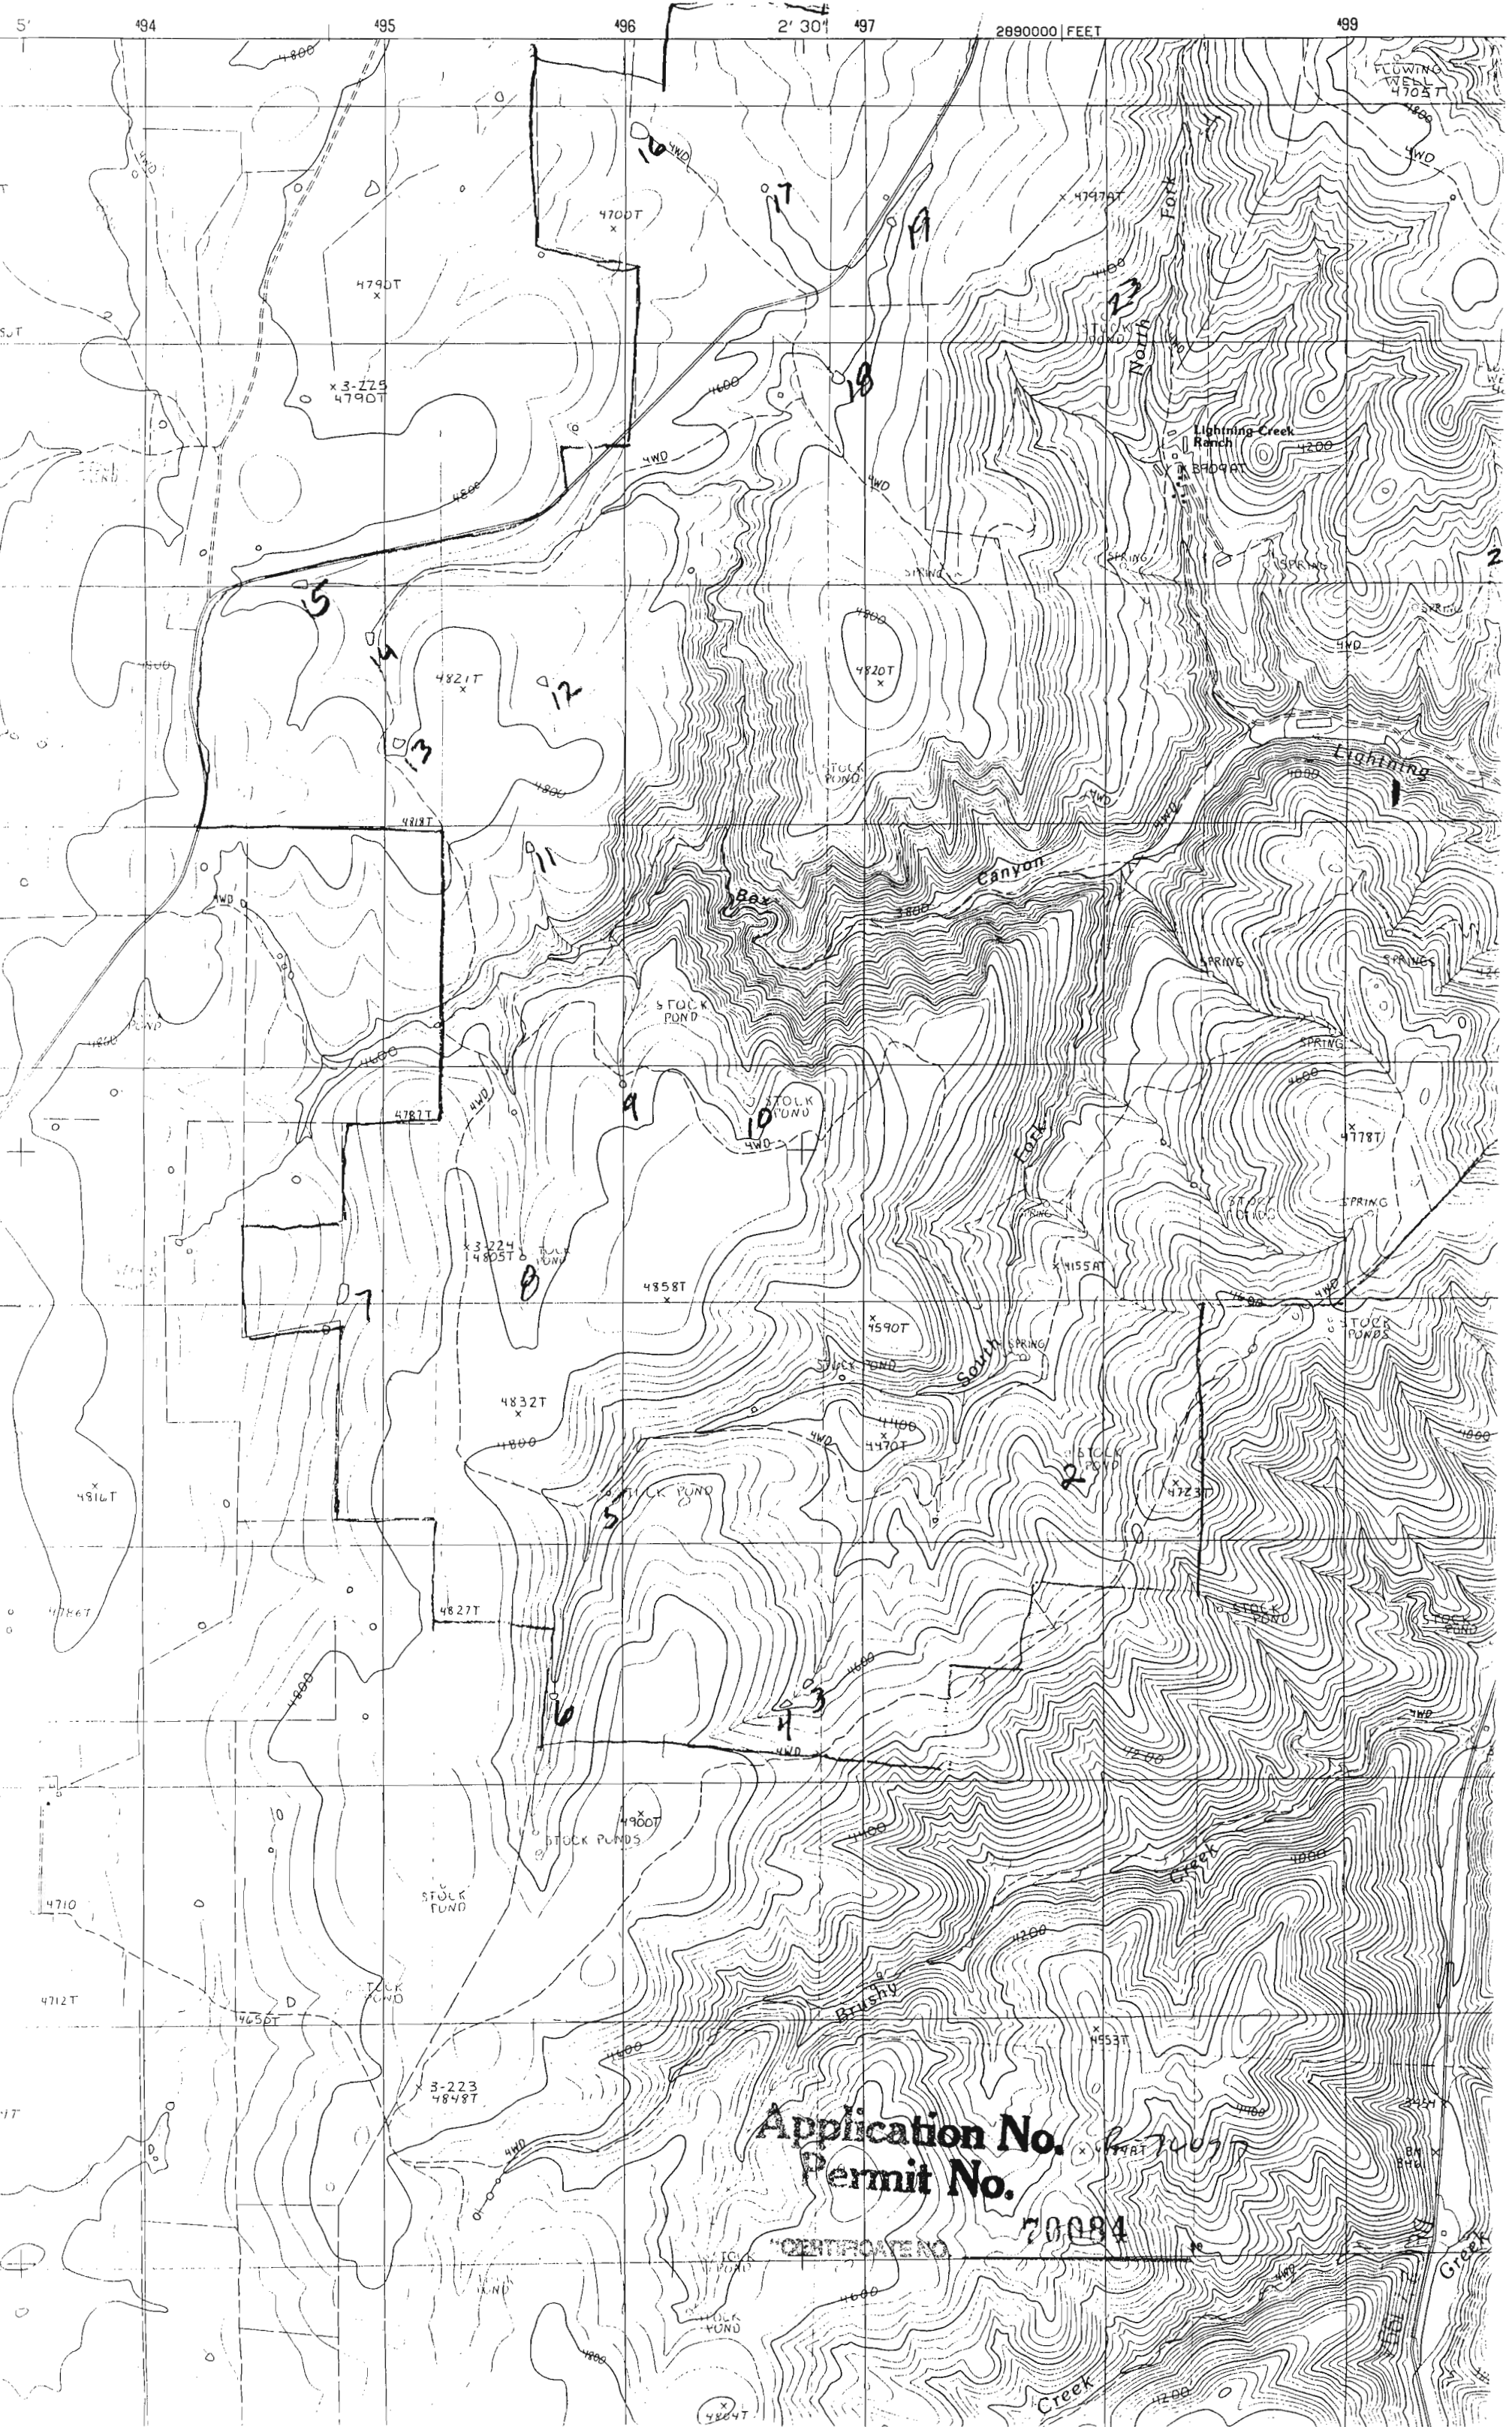

Application No.
Permit No.

70084

CENTROVENS