


Application No. R-7031 T.1S. R.34E.W.M.
Permit No. UMATILLA COUNTY

LOUISIANA PACIFIC LP RANCH 503-443-3108 IS 34
PO BOX J
PILOT ROCK OR 97868
Aerial Photo No. NZ-7P-12-16
7P-98
8P-96-98

1"=2000' See Map IN 34

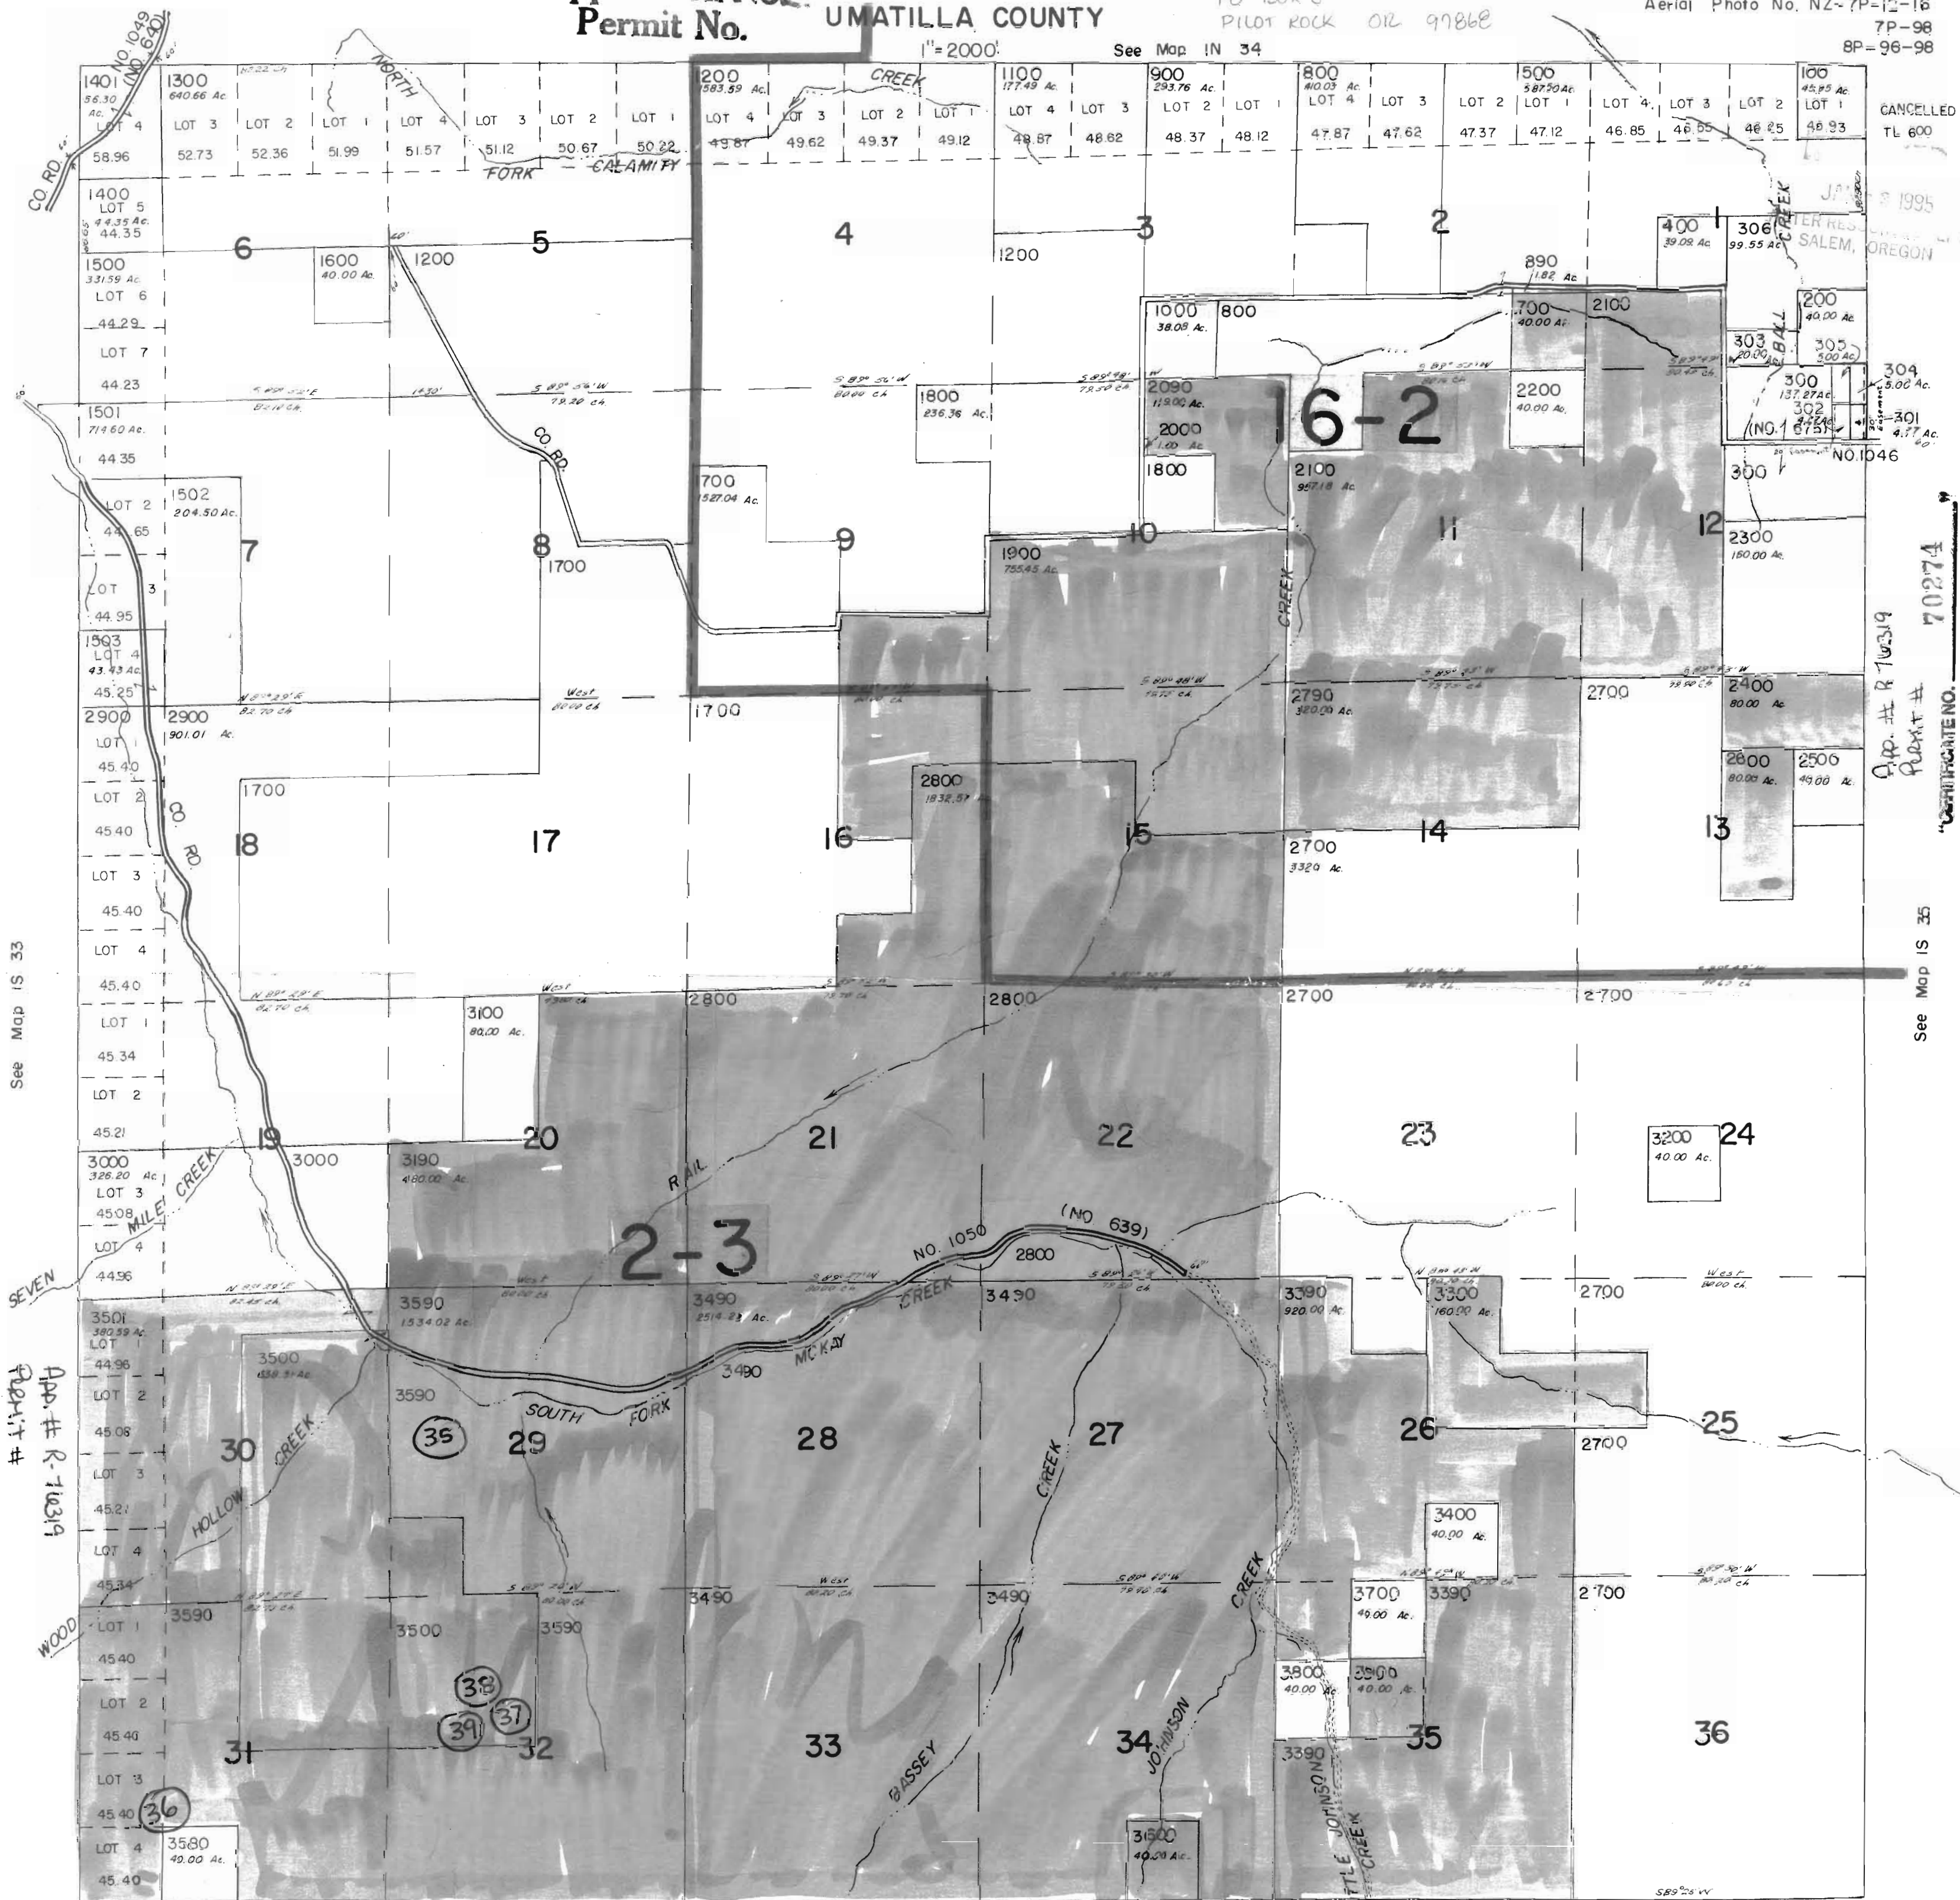

CANCELLED
TL 600

JAN 1995
TER RES
SALEM, OREGON

App. # R-70319
Permit # 70274
"CERTIFICATE NO."

See Map IS 35

CERTIFICATE NO. 70274

App. # R-70319
Permit #

See Map 2S 34

IS 34

TWP 2S R34E W.M.
UMATILLA COUNTY

1" = 2000'

LOUISIANA PACIFIC - LP RANCH
PO BOX J
PILOT ROCK, OR 97862


2S 34

Aerial Photo No. 7P-163,164
8P-4 thru 10, 8P-77 thru 82

Application No. *R-76319*
Permit No.

SEE MAP IS 34

App. # *R76319*
"CERTIFICATE NO. *70274*"

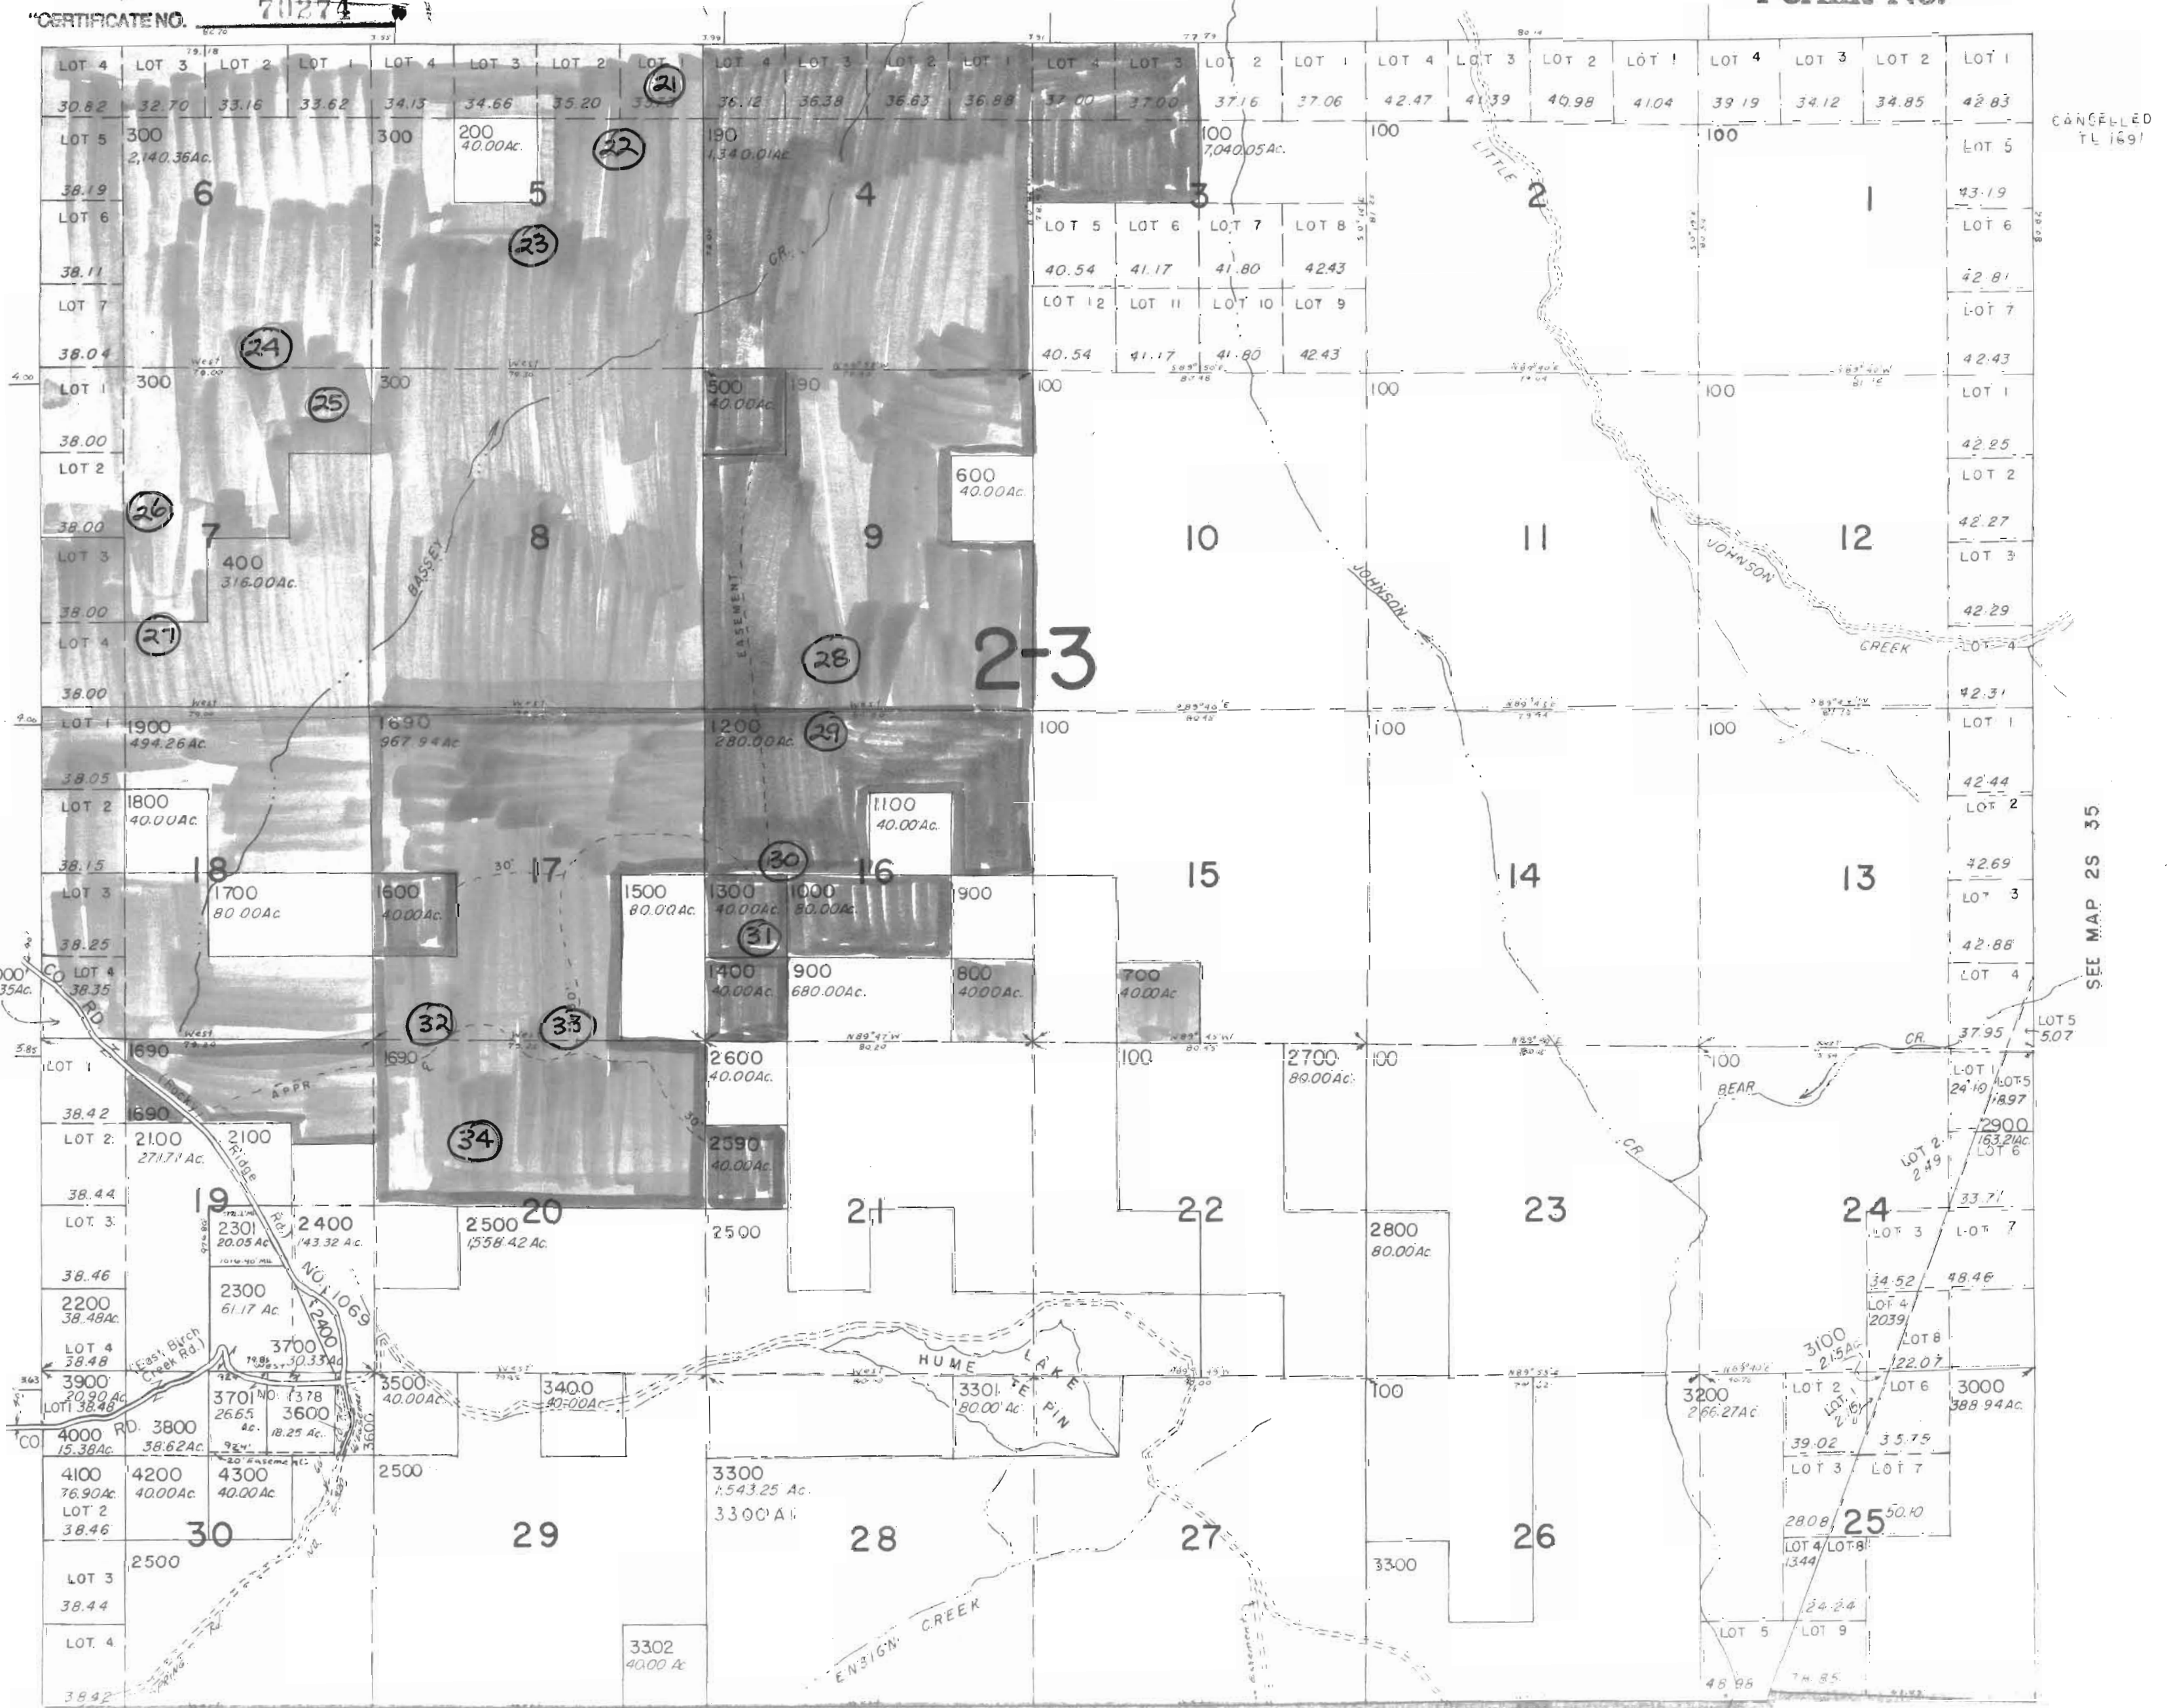


UNION

COUNTY

2S 34

SEE MAP IS 33 "CERTIFICATE NO. 70274

Application No. R-74319
Permit No.

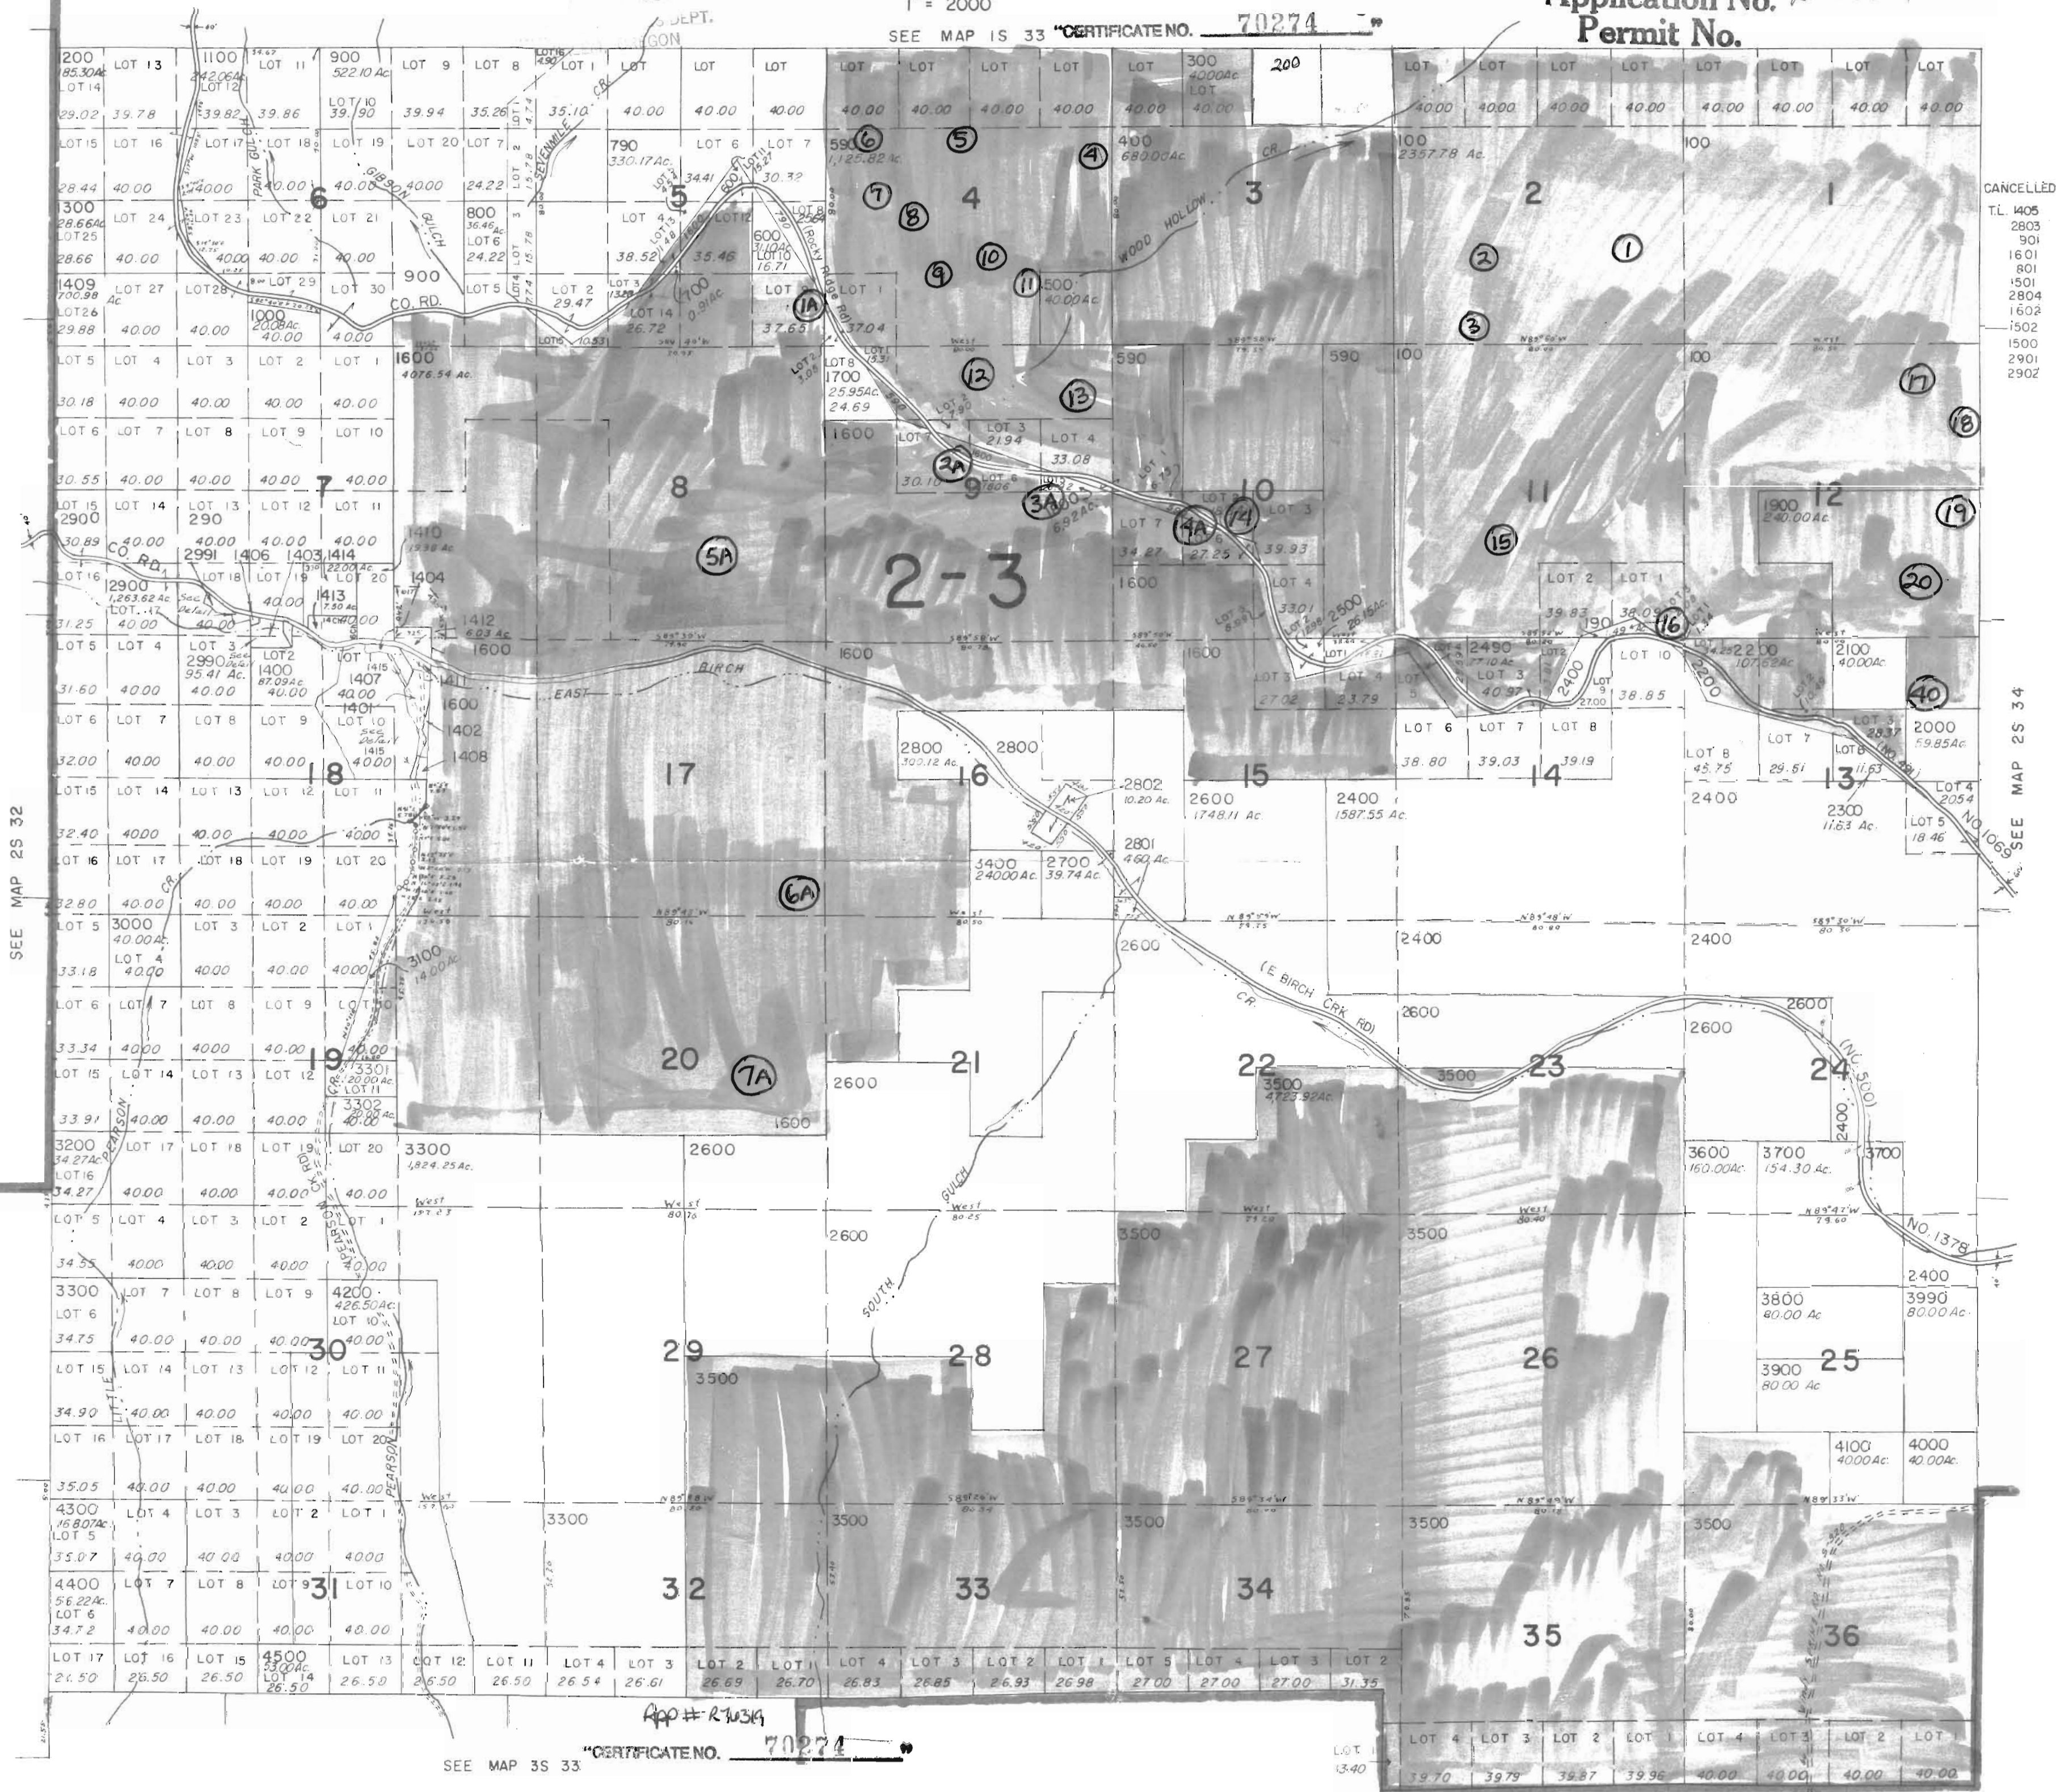

CANCELLED
T.L. 1405
2803
901
1601
801
1501
2804
1602
1502
1500
2901
2902

SEE MAP 2S 34

UNION

COUNTY 2S 33