



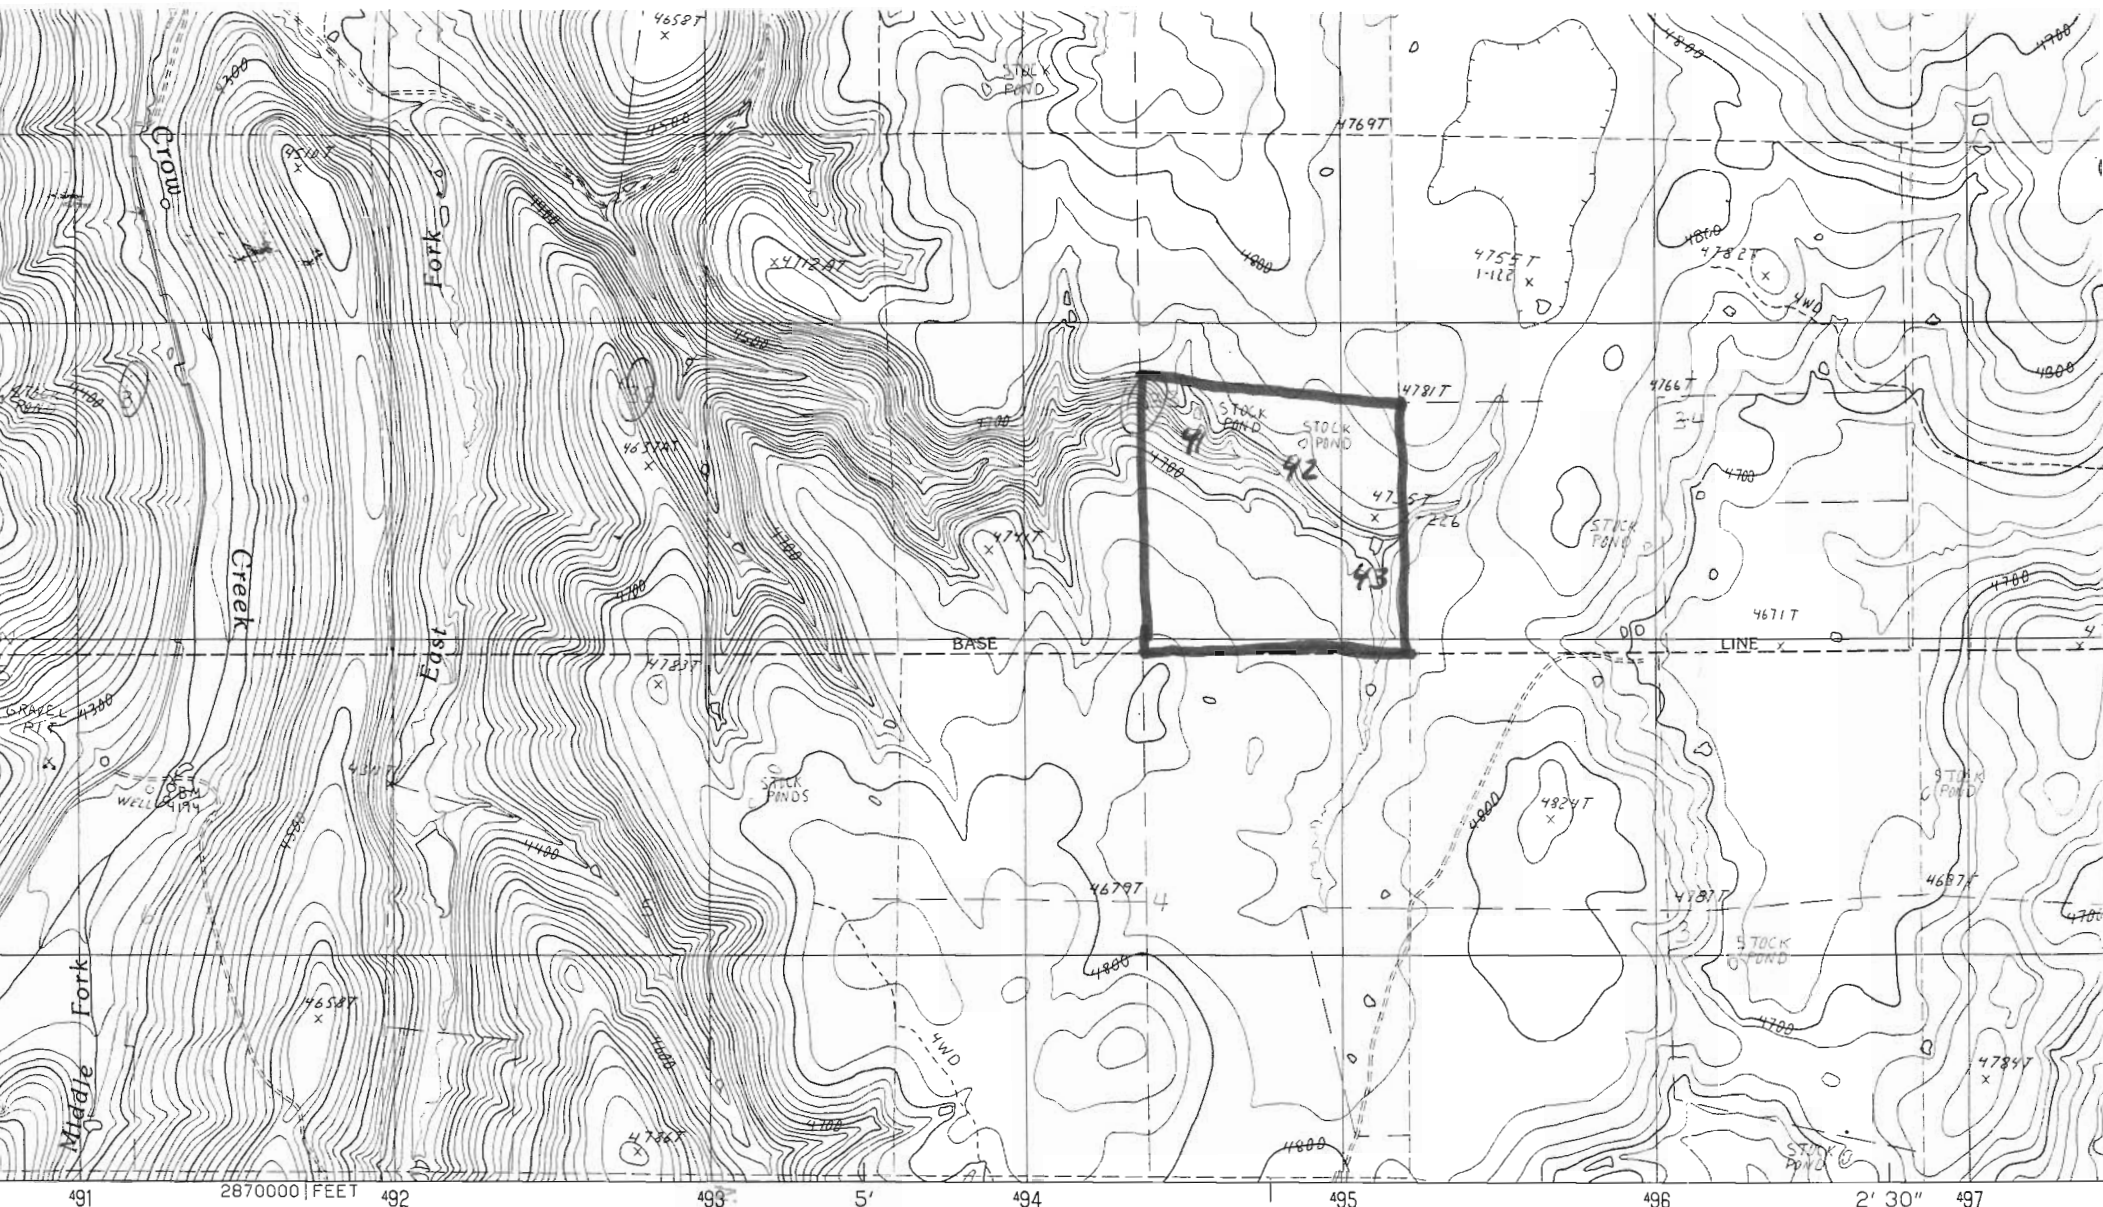

UNITED STATES GEOLOGICAL SURVEY
USGS AND NOS/NOAA
PHOTOGRAPHS TAKEN.....1984
1987. MAP EDITED.....1990
.....LAMBERT CONFORMAL CONIC
AL TRANSVERSE MERCATOR.....ZONE 11
GRID TICKS.....OREGON, NORTH ZONE
.....0°03' WEST
.....17°30' EAST
ONAL GEODETIC VERTICAL DATUM OF 1929
.....1927 NORTH AMERICAN DATUM
ed North American Datum of 1983,
es as shown by dashed corner ticks
meters east)
holdings within the boundaries of any
ons shown on this map

PROVISIONAL MAP
Produced from original
manuscript drawings. Infor-
mation shown as of date of
field check.

DEC 30 1994
WATER RESOURCES
SALEM, OREGON

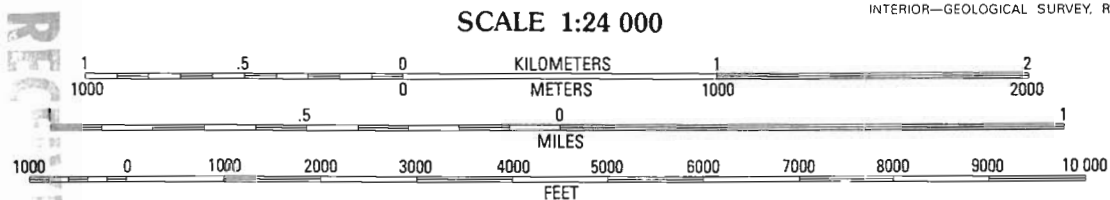

CONTOUR INTERVAL 20 FEET

To convert meters to feet multiply by 3.2808
To convert feet to meters multiply by .3048

THIS MAP COMPLIES WITH NATIONAL MAP ACCURACY STANDARDS
FOR SALE BY U.S. GEOLOGICAL SURVEY, DENVER, COLORADO 80225 OR RESTON, VIRGINIA 22092

1	2
4	
6	7