


ERIOR

T 55

R 31 E

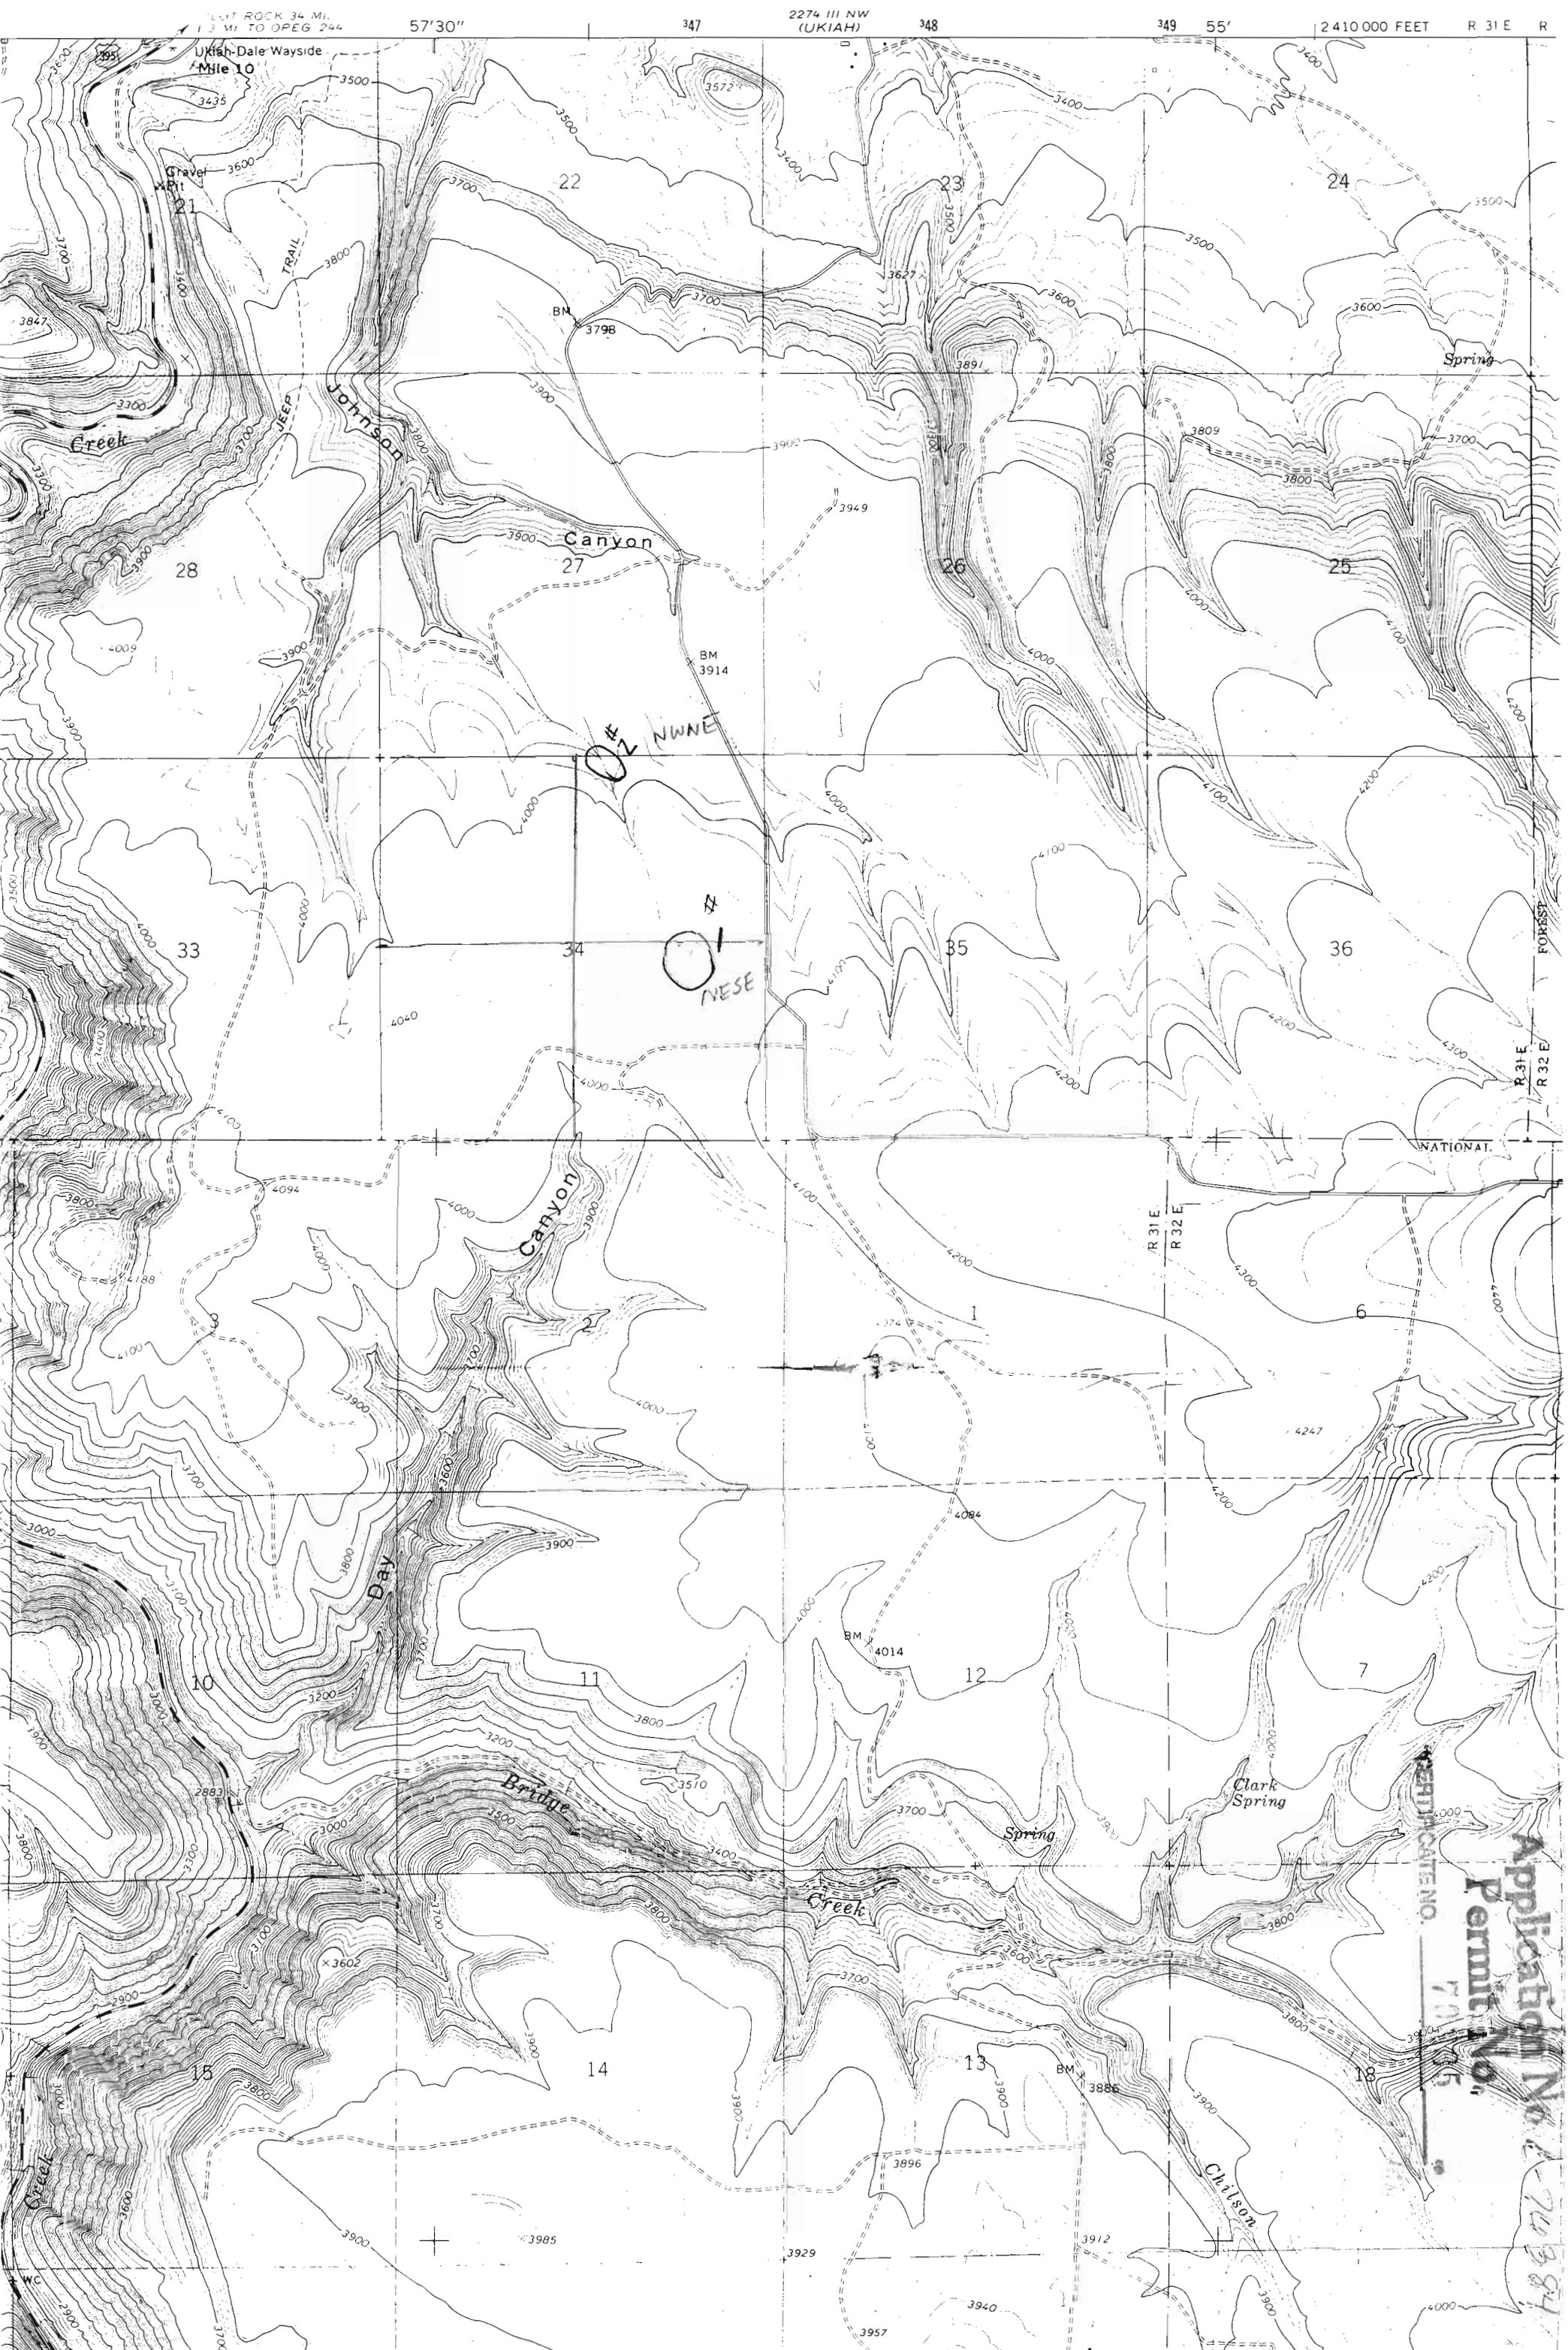

CERTIFICATE NO.

Application No. 4-740384
Permit No. 740384