




RECEIVED

DEC 30 1994

WAL. 13 JUN 1994 DEPT.
SALEM, OREGON

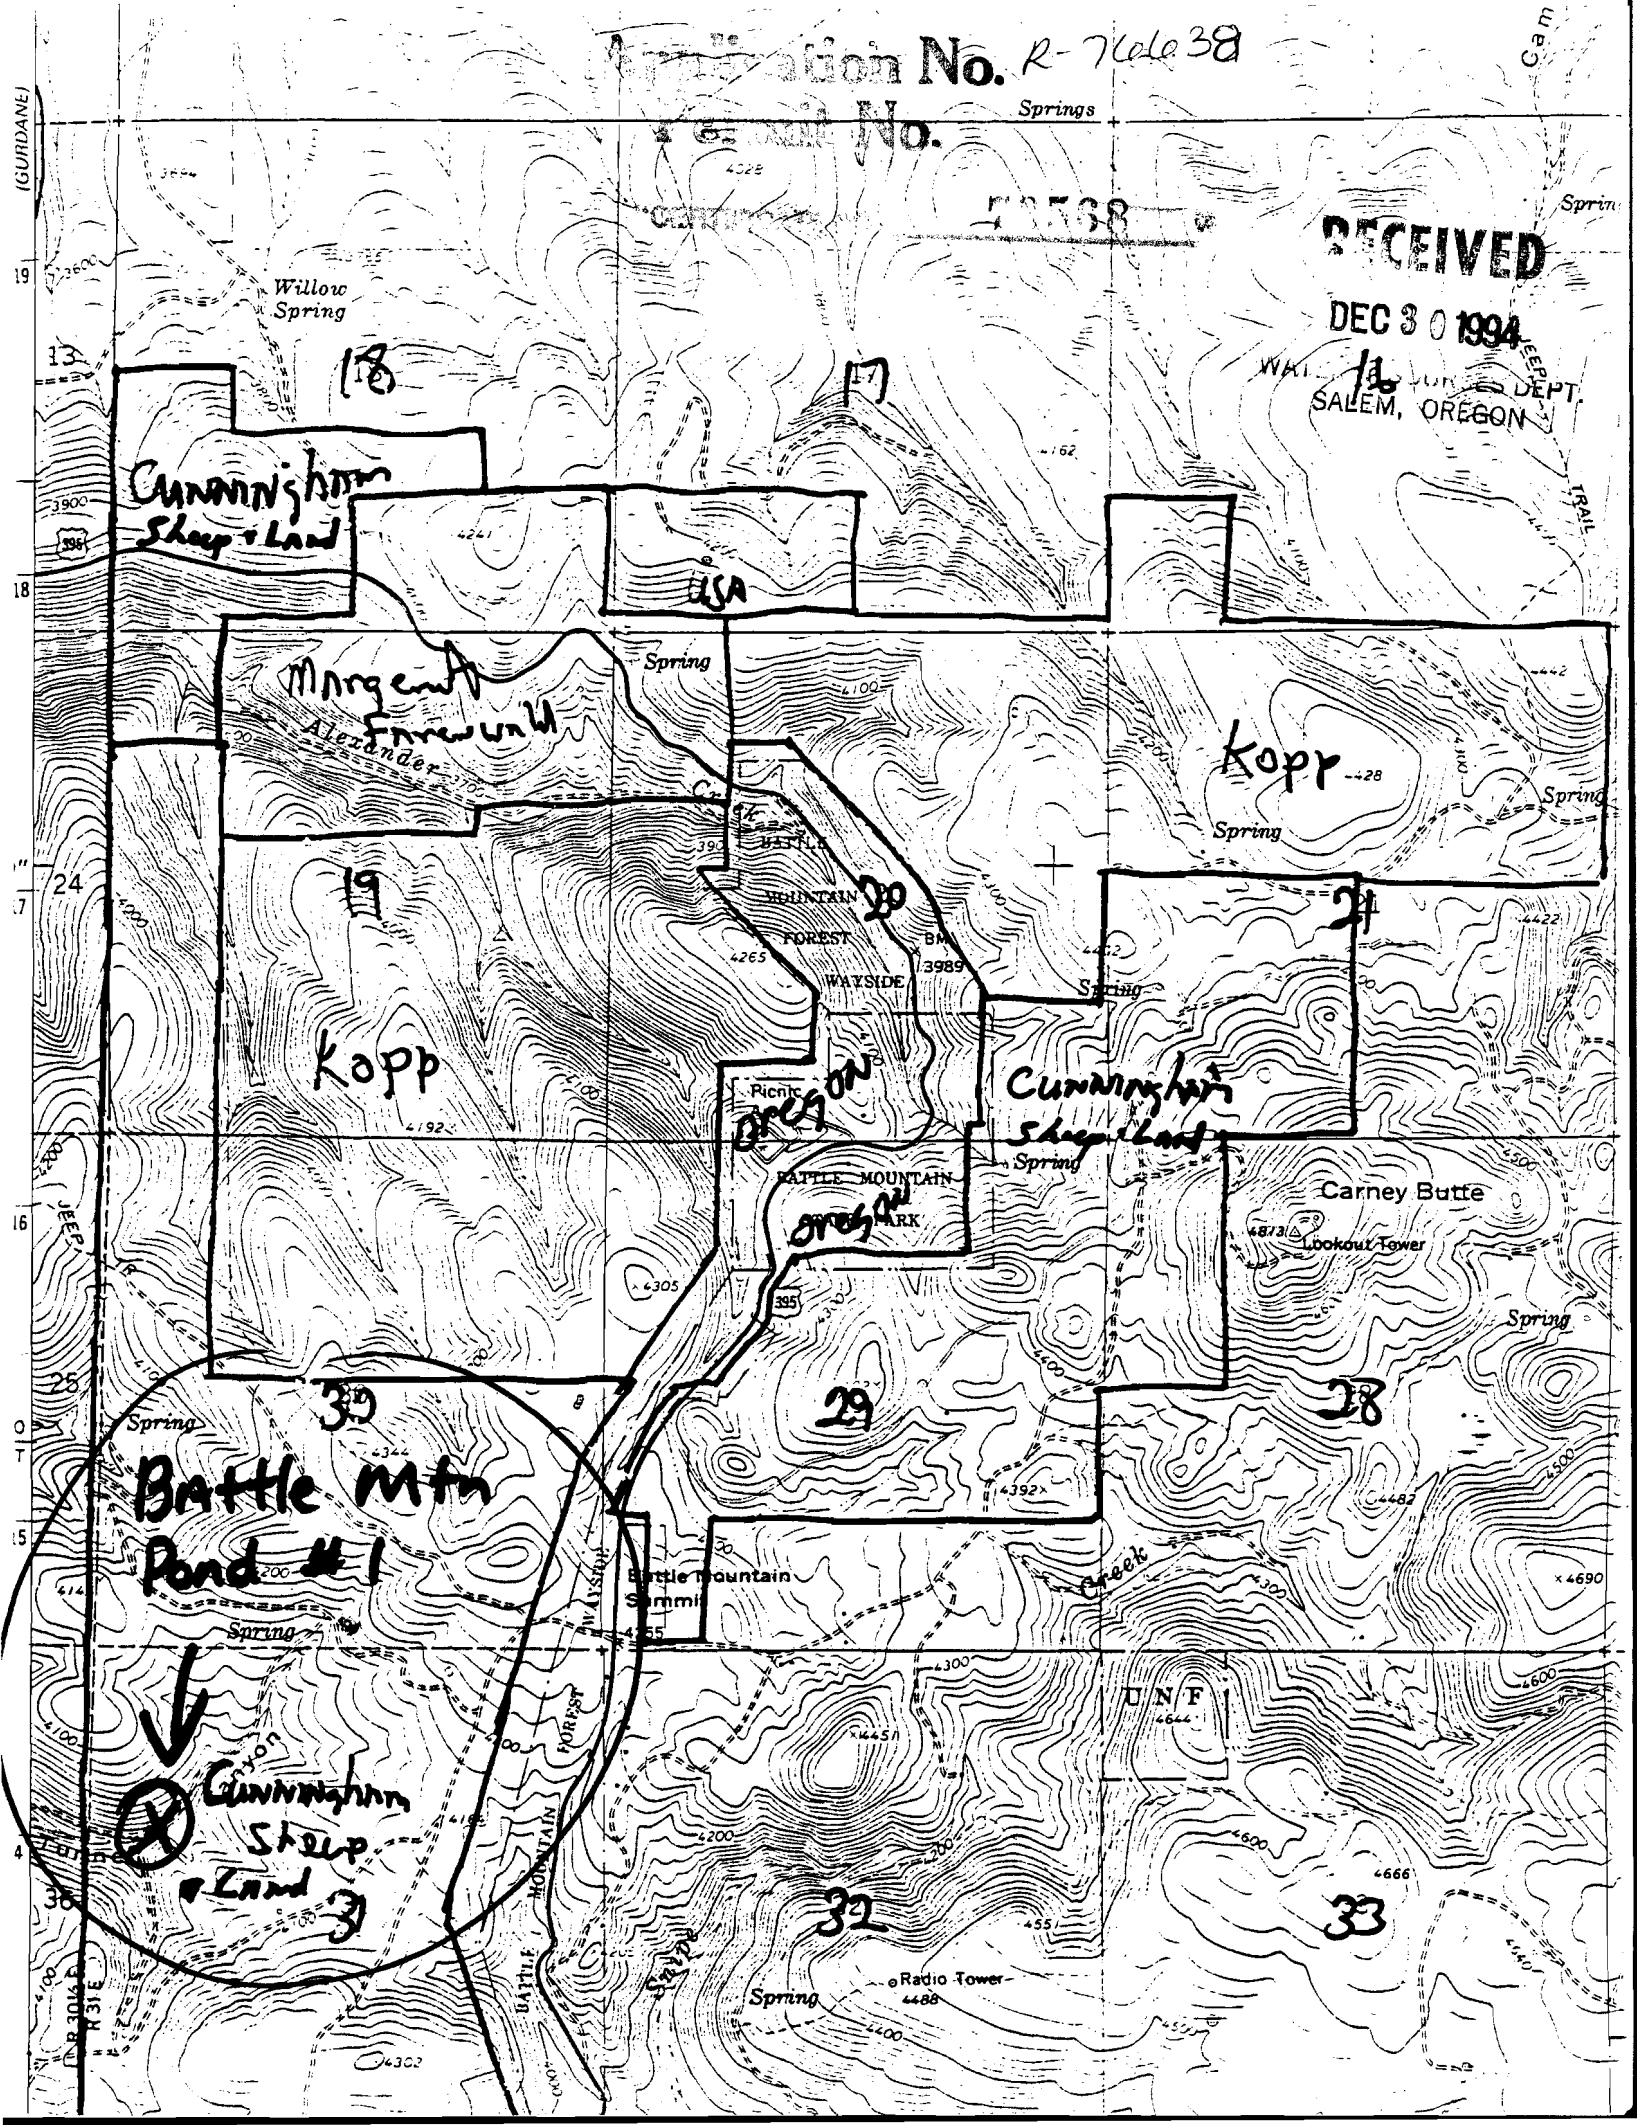

Application No.

R-76438

Permit No.


70568


RECEIVED

DEC 30 1994

RESOURCES DEPT.
SALEM, OREGON

16

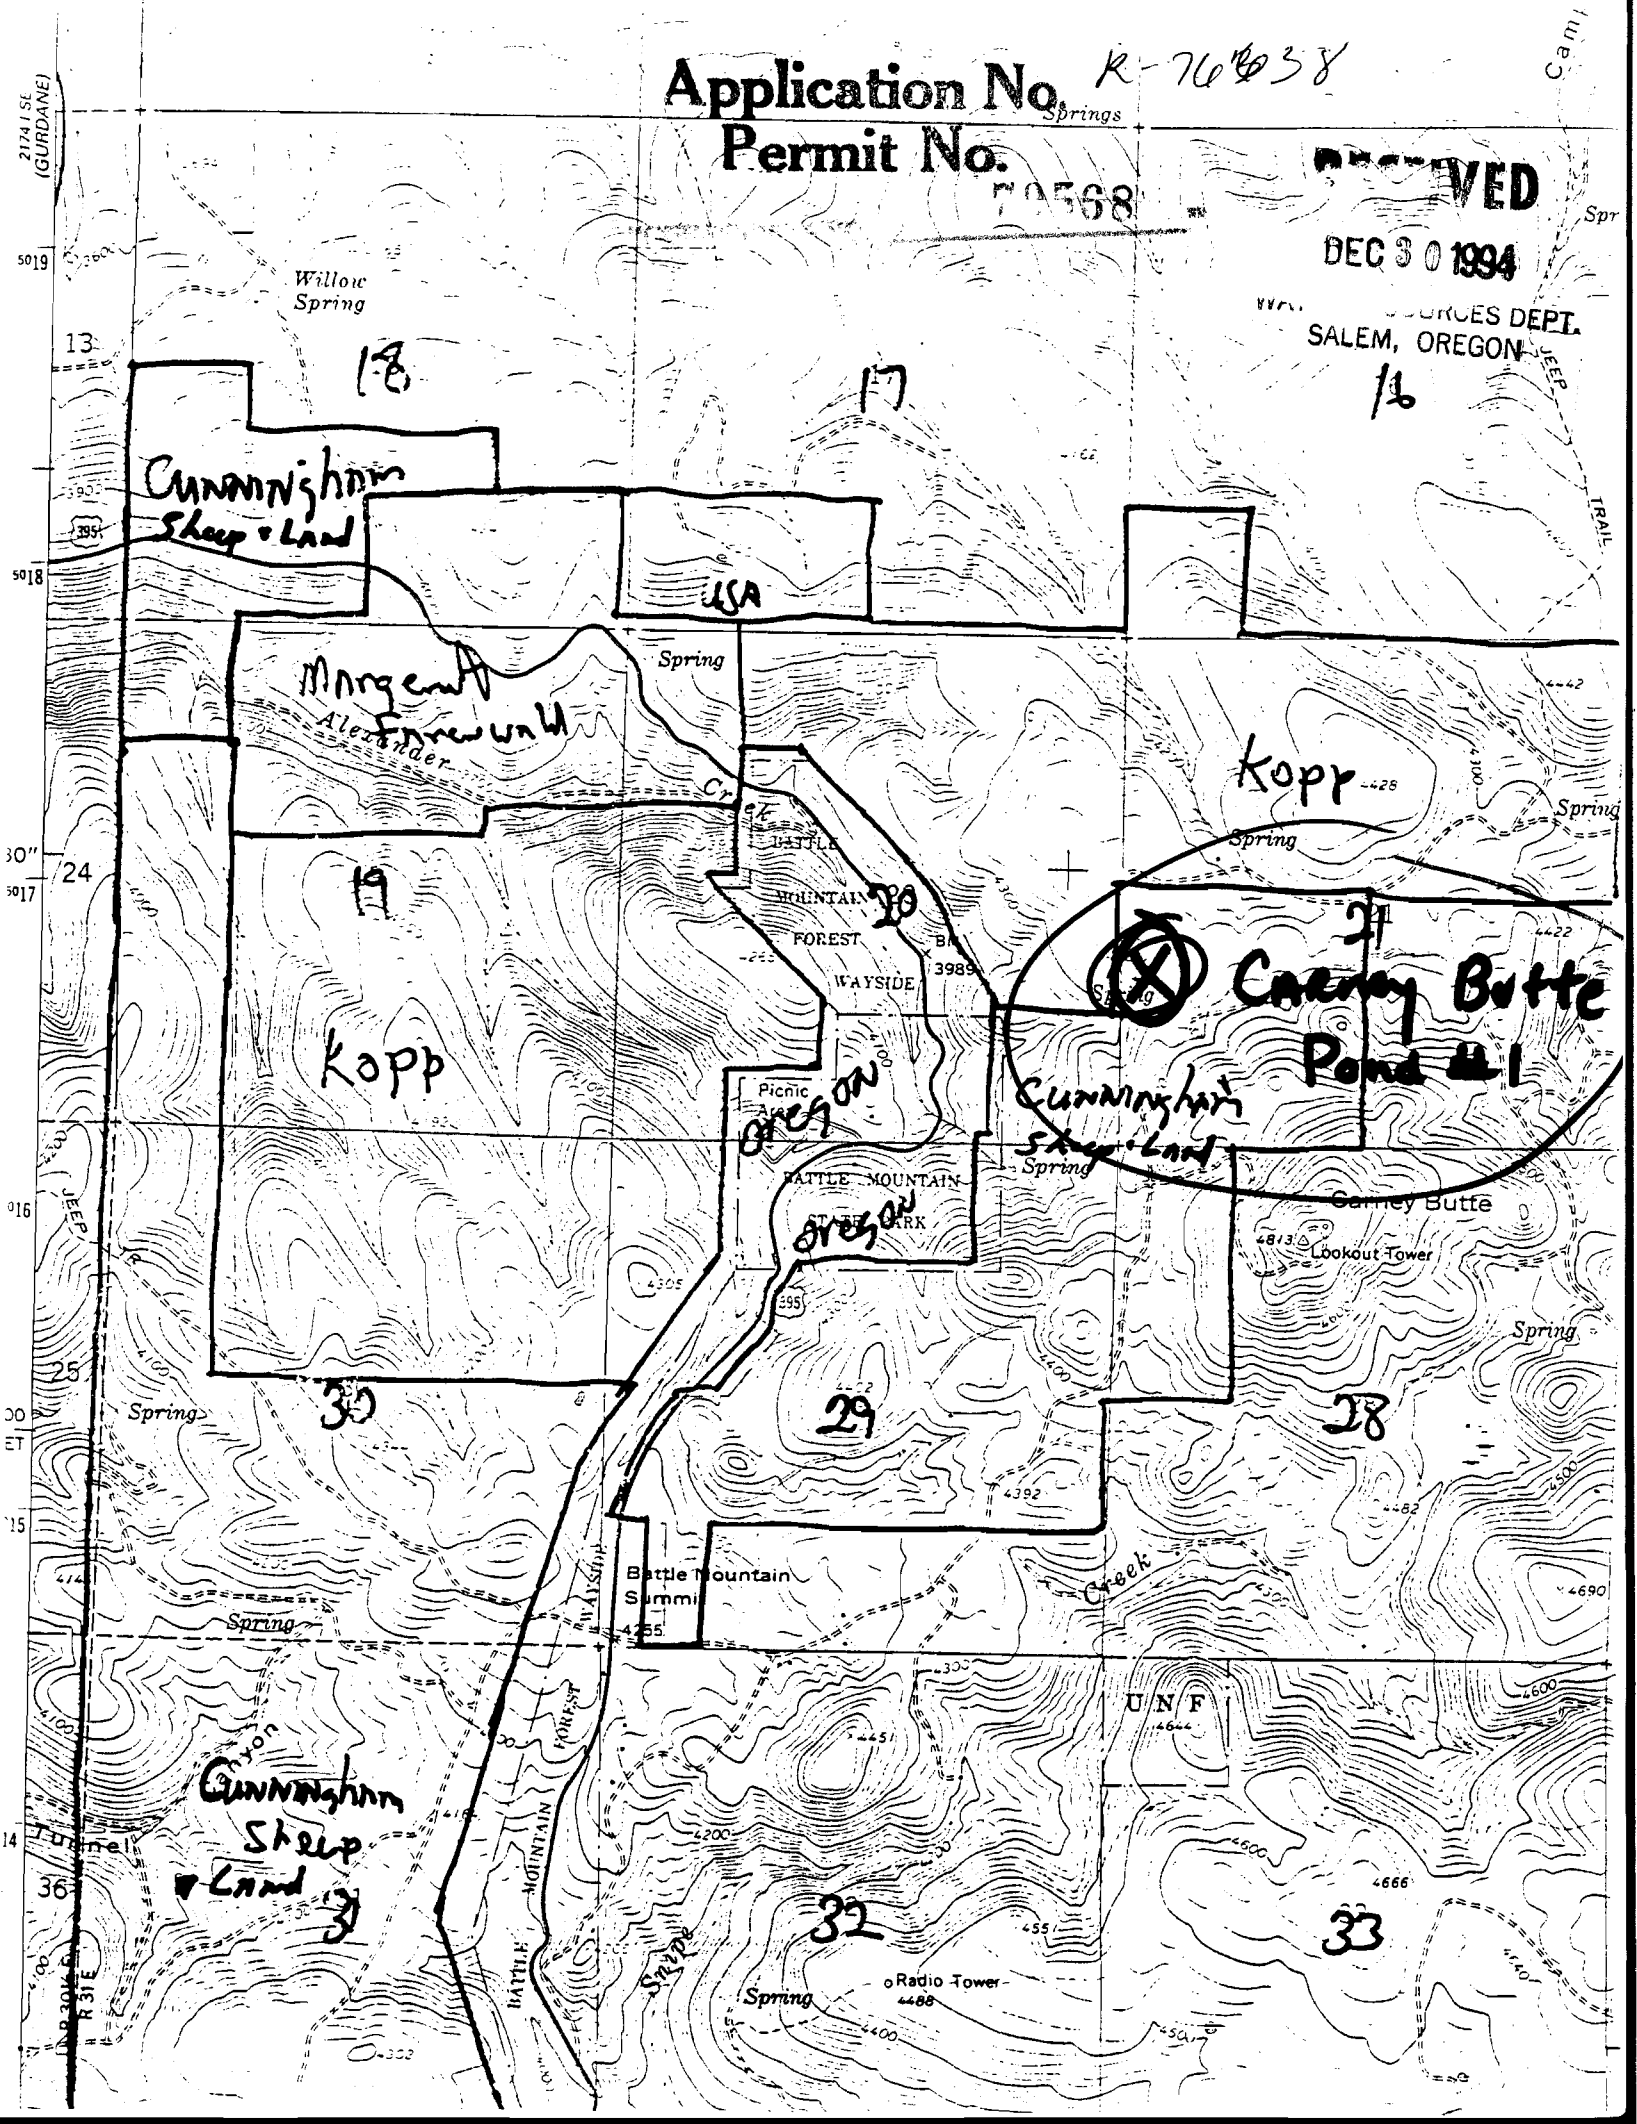

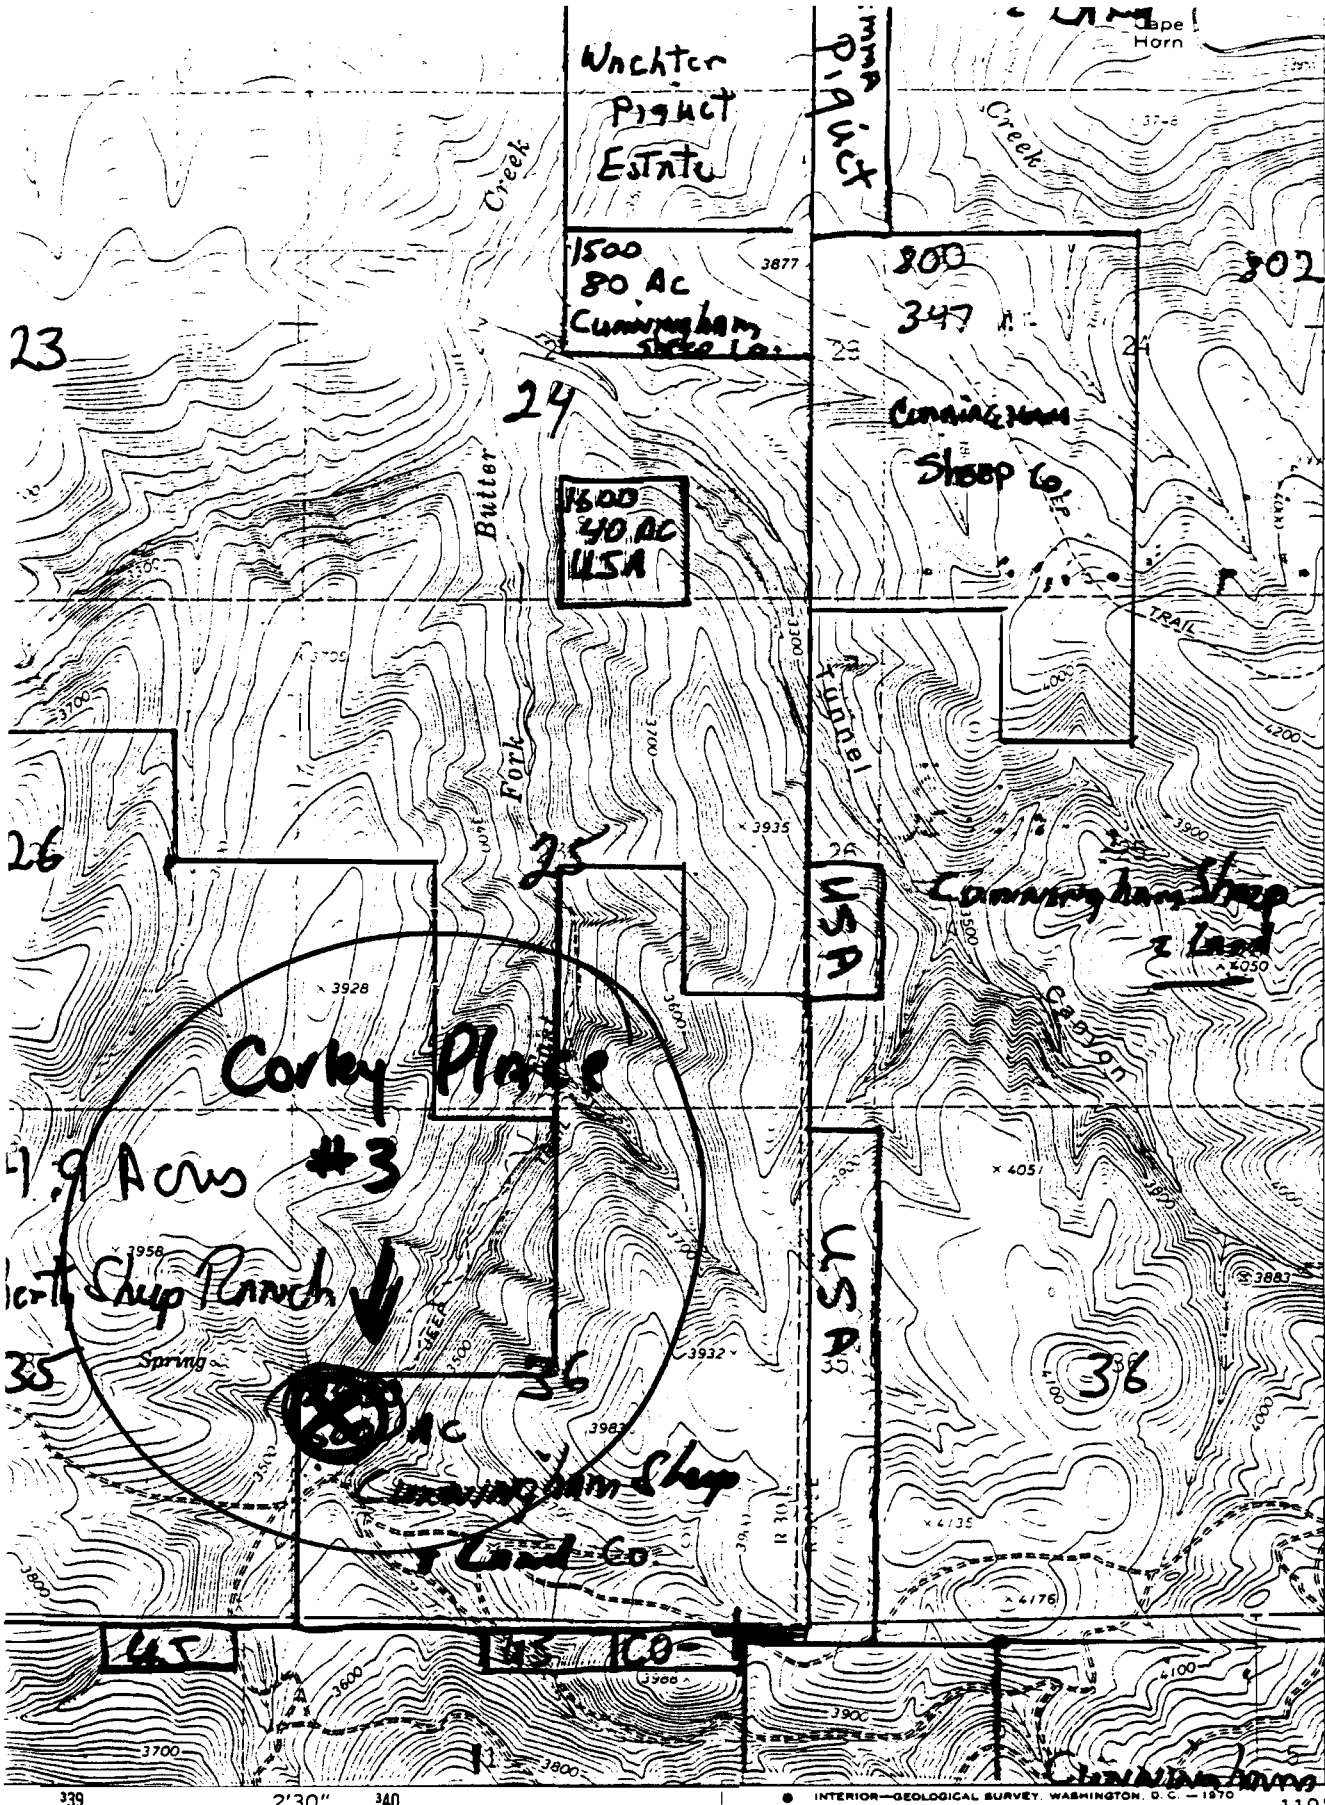

RECEIVED
DEC 30 1994
SALEM, OREGON



Application No. R-76638
Permit No.

70768

LUKIAN
2274 III NW

RECEIVED
DEC 30 1994
DES DEPT
OREGON

Application No. R-76638
Permit No.

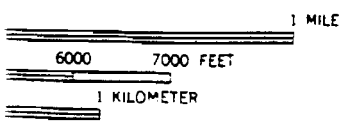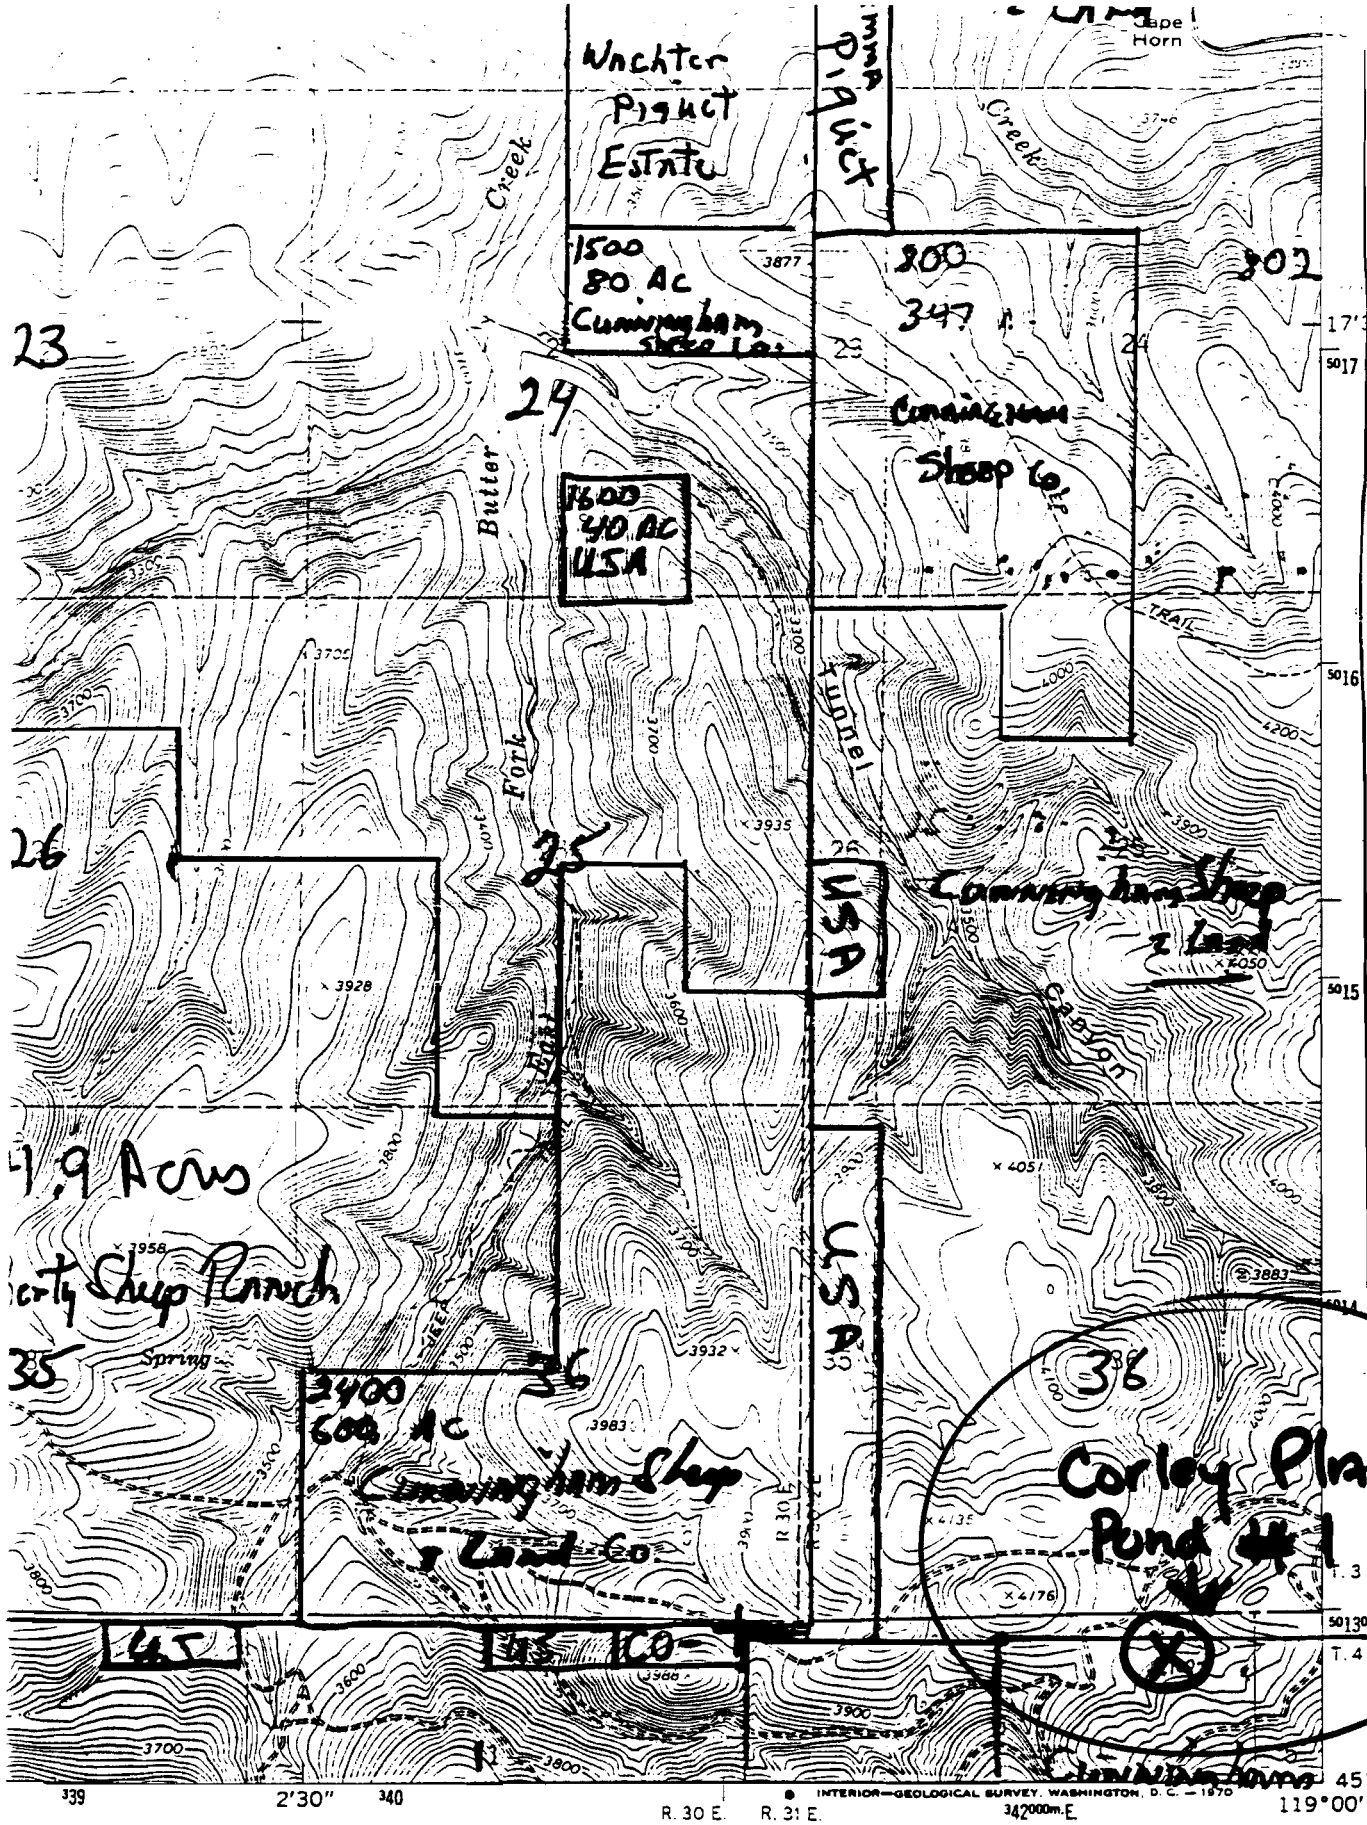


ROAD CLASSIFICATION
Medium-duty _____ Light-duty _____
Unimproved dirt -----
U. S. Route




LUKIAN
2274 III NW

17'30"
RESOURCES DEPT.
SALEM, OREGON

Application No. K-76638
Permit No.

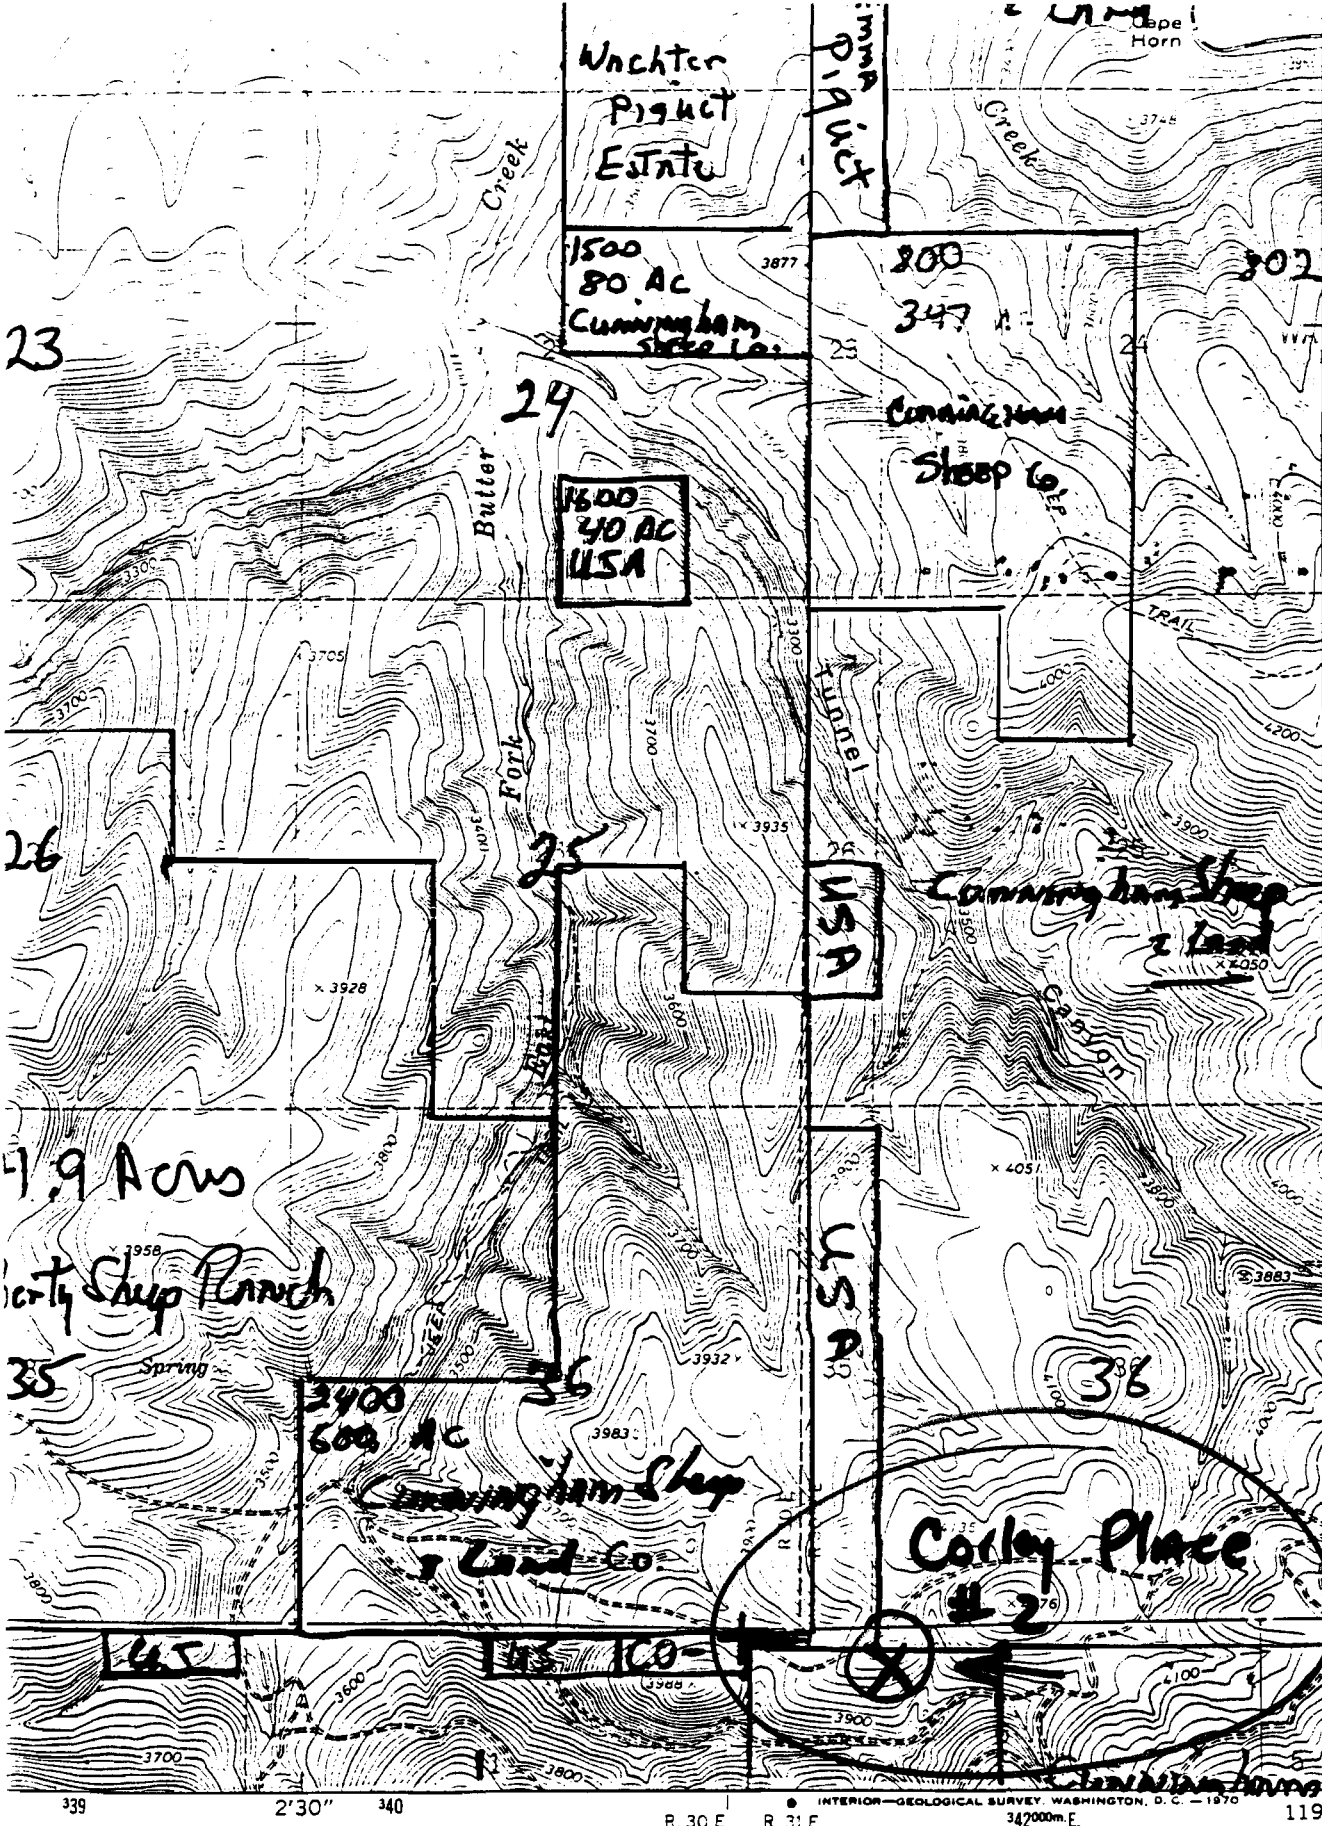

1.4
45
00'
(AKIAH)
2274-11P NW

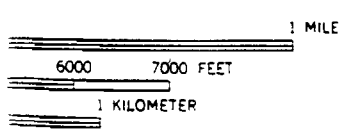

ROAD CLASSIFICATION

Medium-duty _____ Light-duty _____
Unimproved dirt _____

U. S. Route

