


UNITED STATES
DEPARTMENT OF THE INTERIOR
GEOLOGICAL SURVEY

JOSEPH QUADRANGLE
OREGON-WALLOWA CO.
15 MINUTE SERIES (TOPOGRAPHIC)

70626

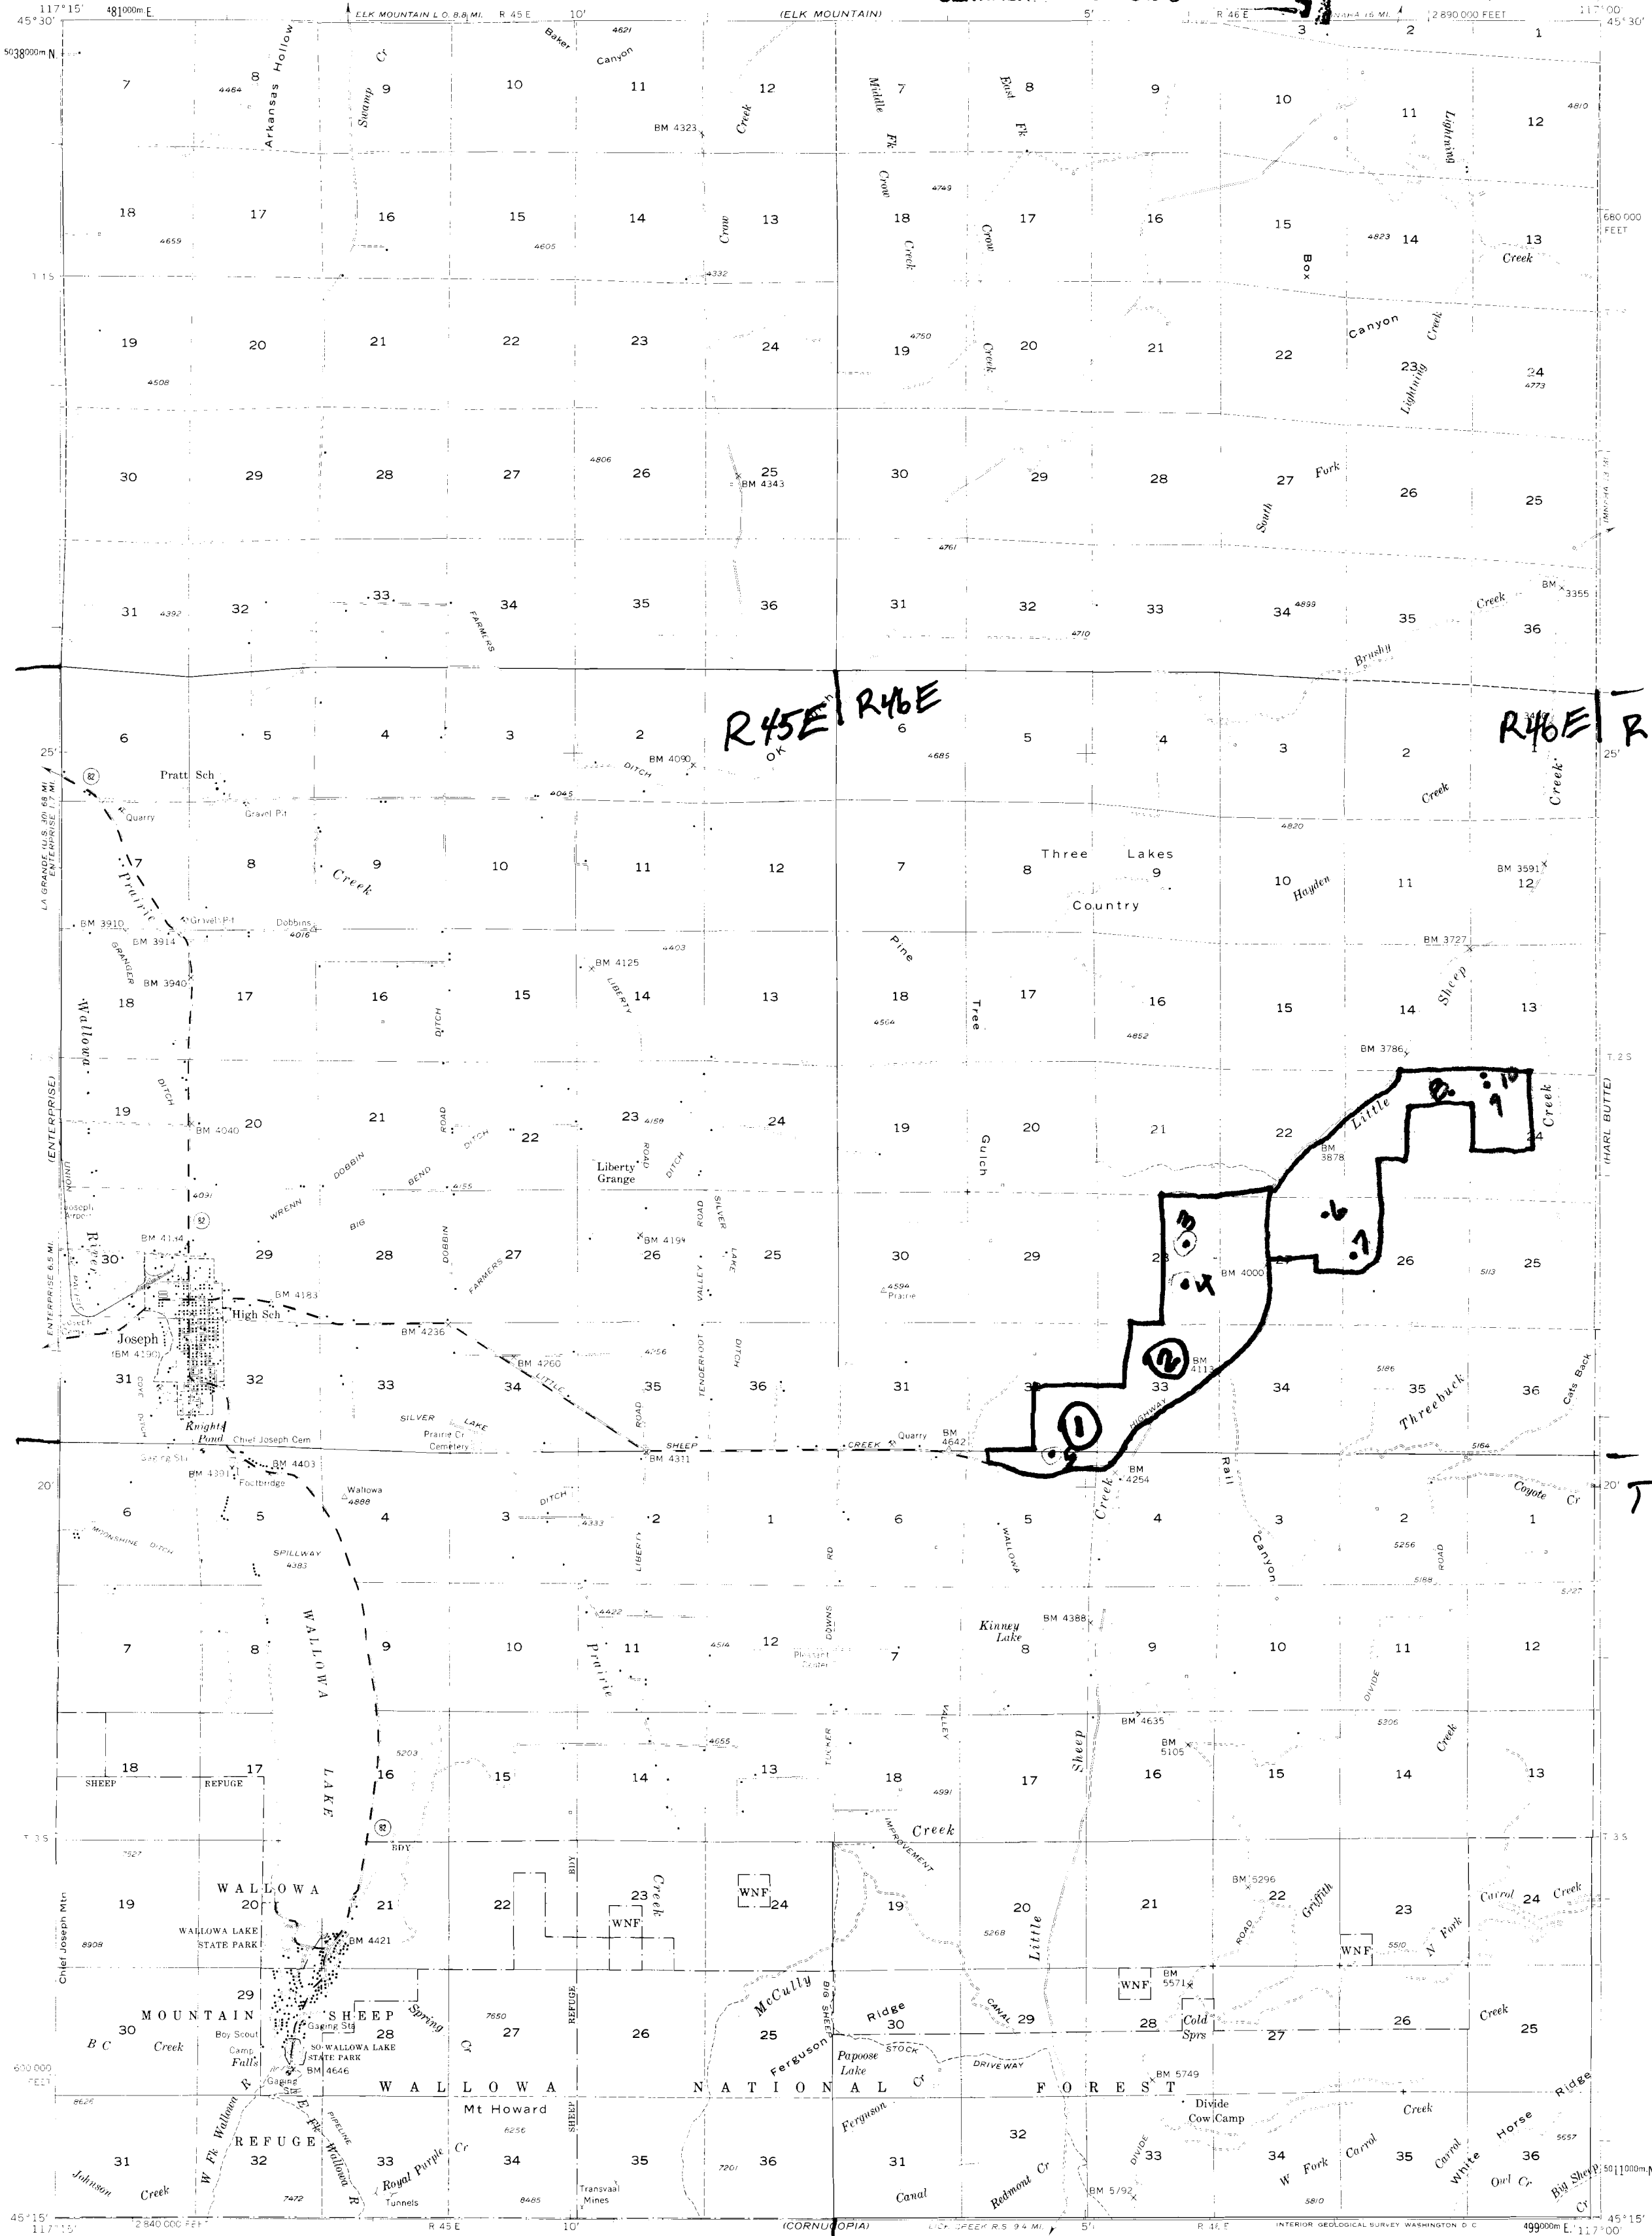

Mapped, edited, and published by the Geological Survey
Control by USGS, USC&GS, and Pacific Power and Light Company
Topography from aerial photographs by multiple methods
Aerial photographs taken 1953. Field check 1957
Polyconic projection. 1927 North American datum
10,000-foot grid based on Oregon coordinate system,
north zone
1000-meter Universal Transverse Mercator grid ticks,
zone 11, shown in blue
Dashed land lines indicate approximate locations
Unchecked elevations are shown in brown

APPROXIMATE MEAN
DECLINATION, 1957

THIS MAP COMPLIES WITH NATIONAL MAP ACCURACY STANDARDS
FOR SALE BY U. S. GEOLOGICAL SURVEY, DENVER 2, COLORADO OR WASHINGTON 25, D. C.
A FOLDER DESCRIBING TOPOGRAPHIC MAPS AND SYMBOLS IS AVAILABLE ON REQUEST

ROAD CLASSIFICATION
Medium-duty — Light-duty
Unimproved dirt
State Route

JOSEPH, OREG.
N4515-W11700/15
1957