

RECEIVED

DEC 21 1994

WATER RESOURCES
SALEM, OREGON

Downey Lake

T2S R47E

Application No. R-76760
Permit No.

70682

Application No. *K-76742*
Permit No.

70682

27' 30"


5032


5031

5030

T 13

T25

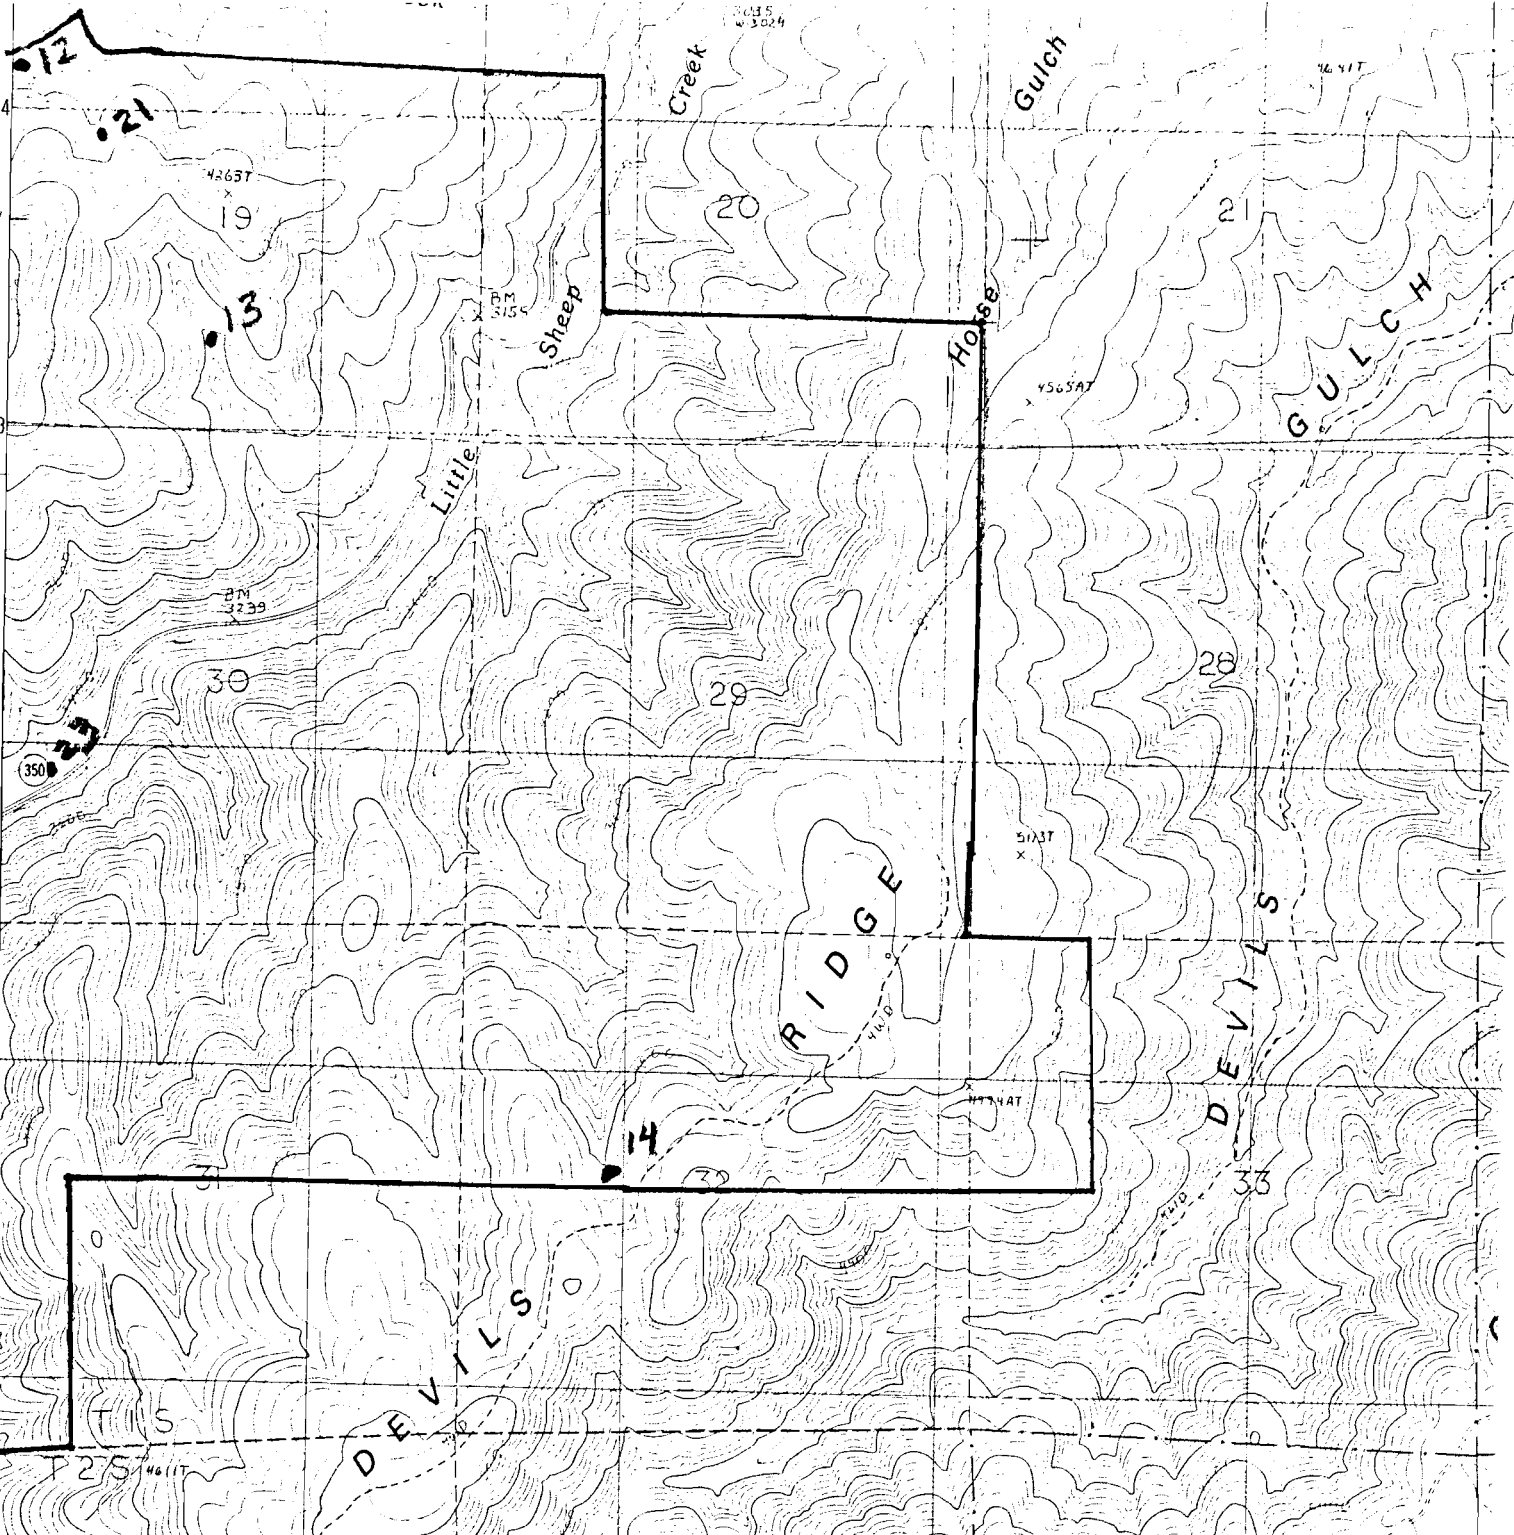

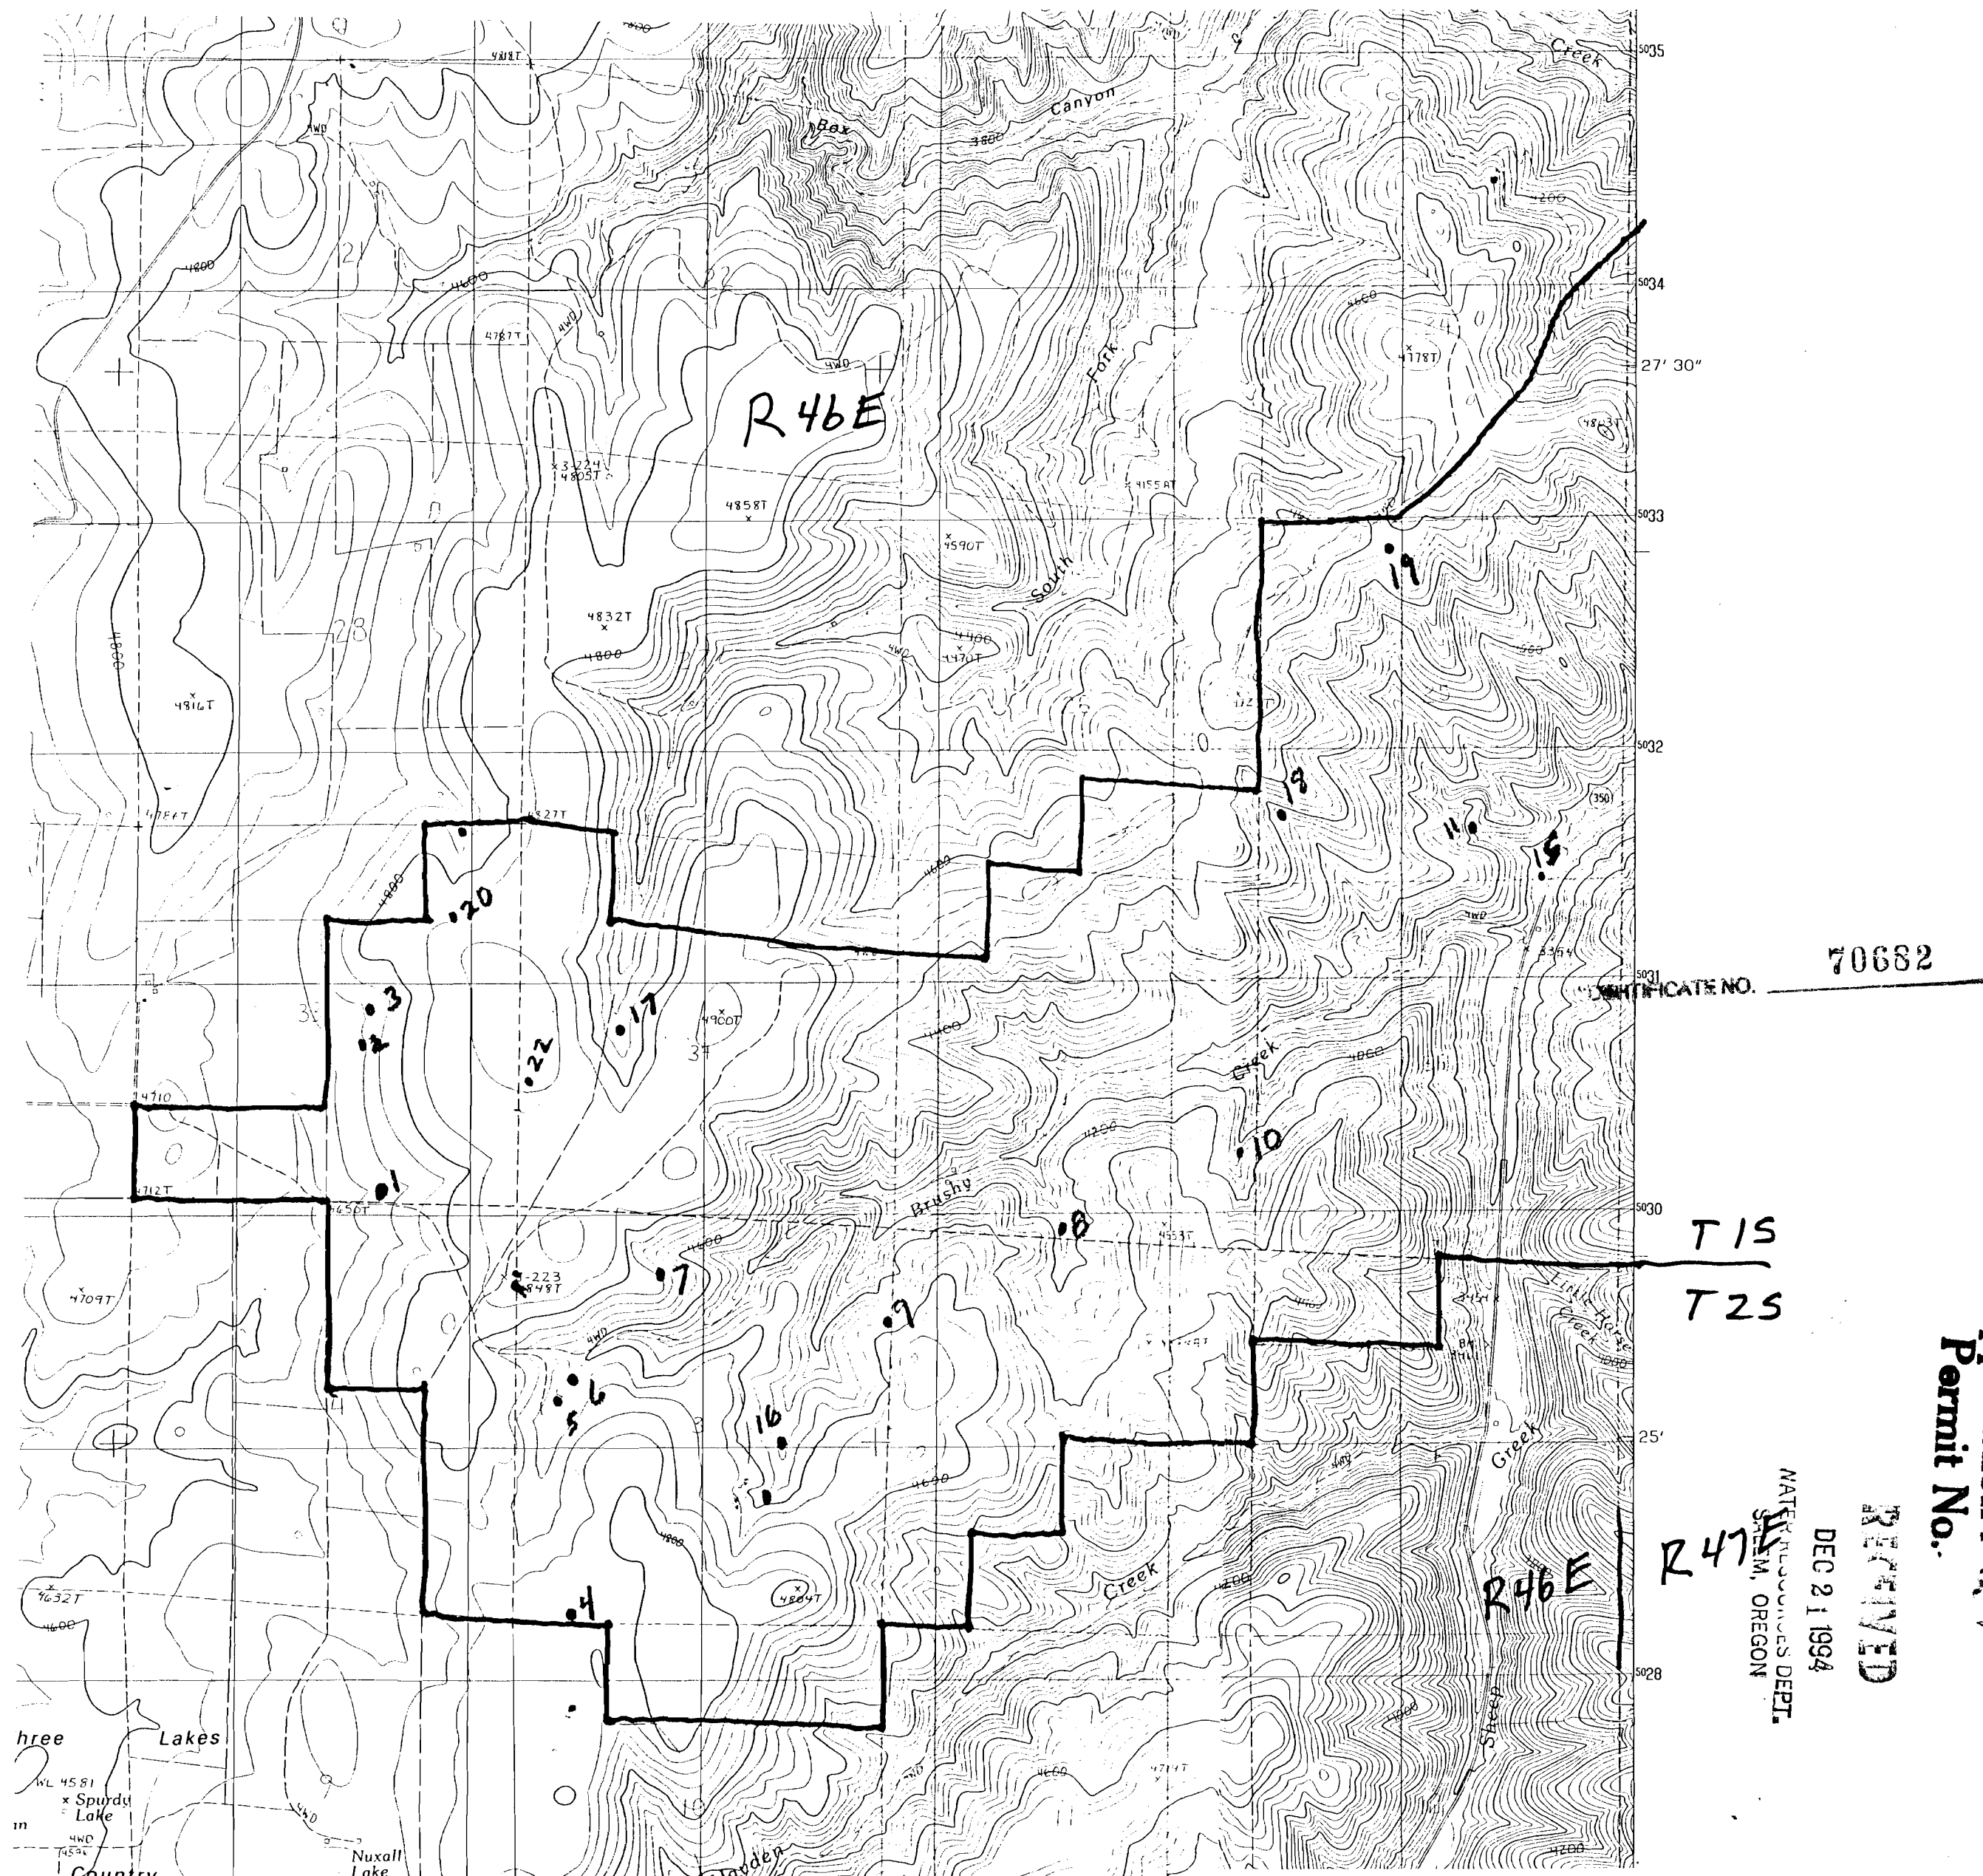

70682

CERTIFICATE NO.

T 1S

T 2S

Permit No.

RECEIVED

DEC 21 1994

NATURAL RESOURCES DEPT.
SALEM, OREGON

R 47E

R 46E