


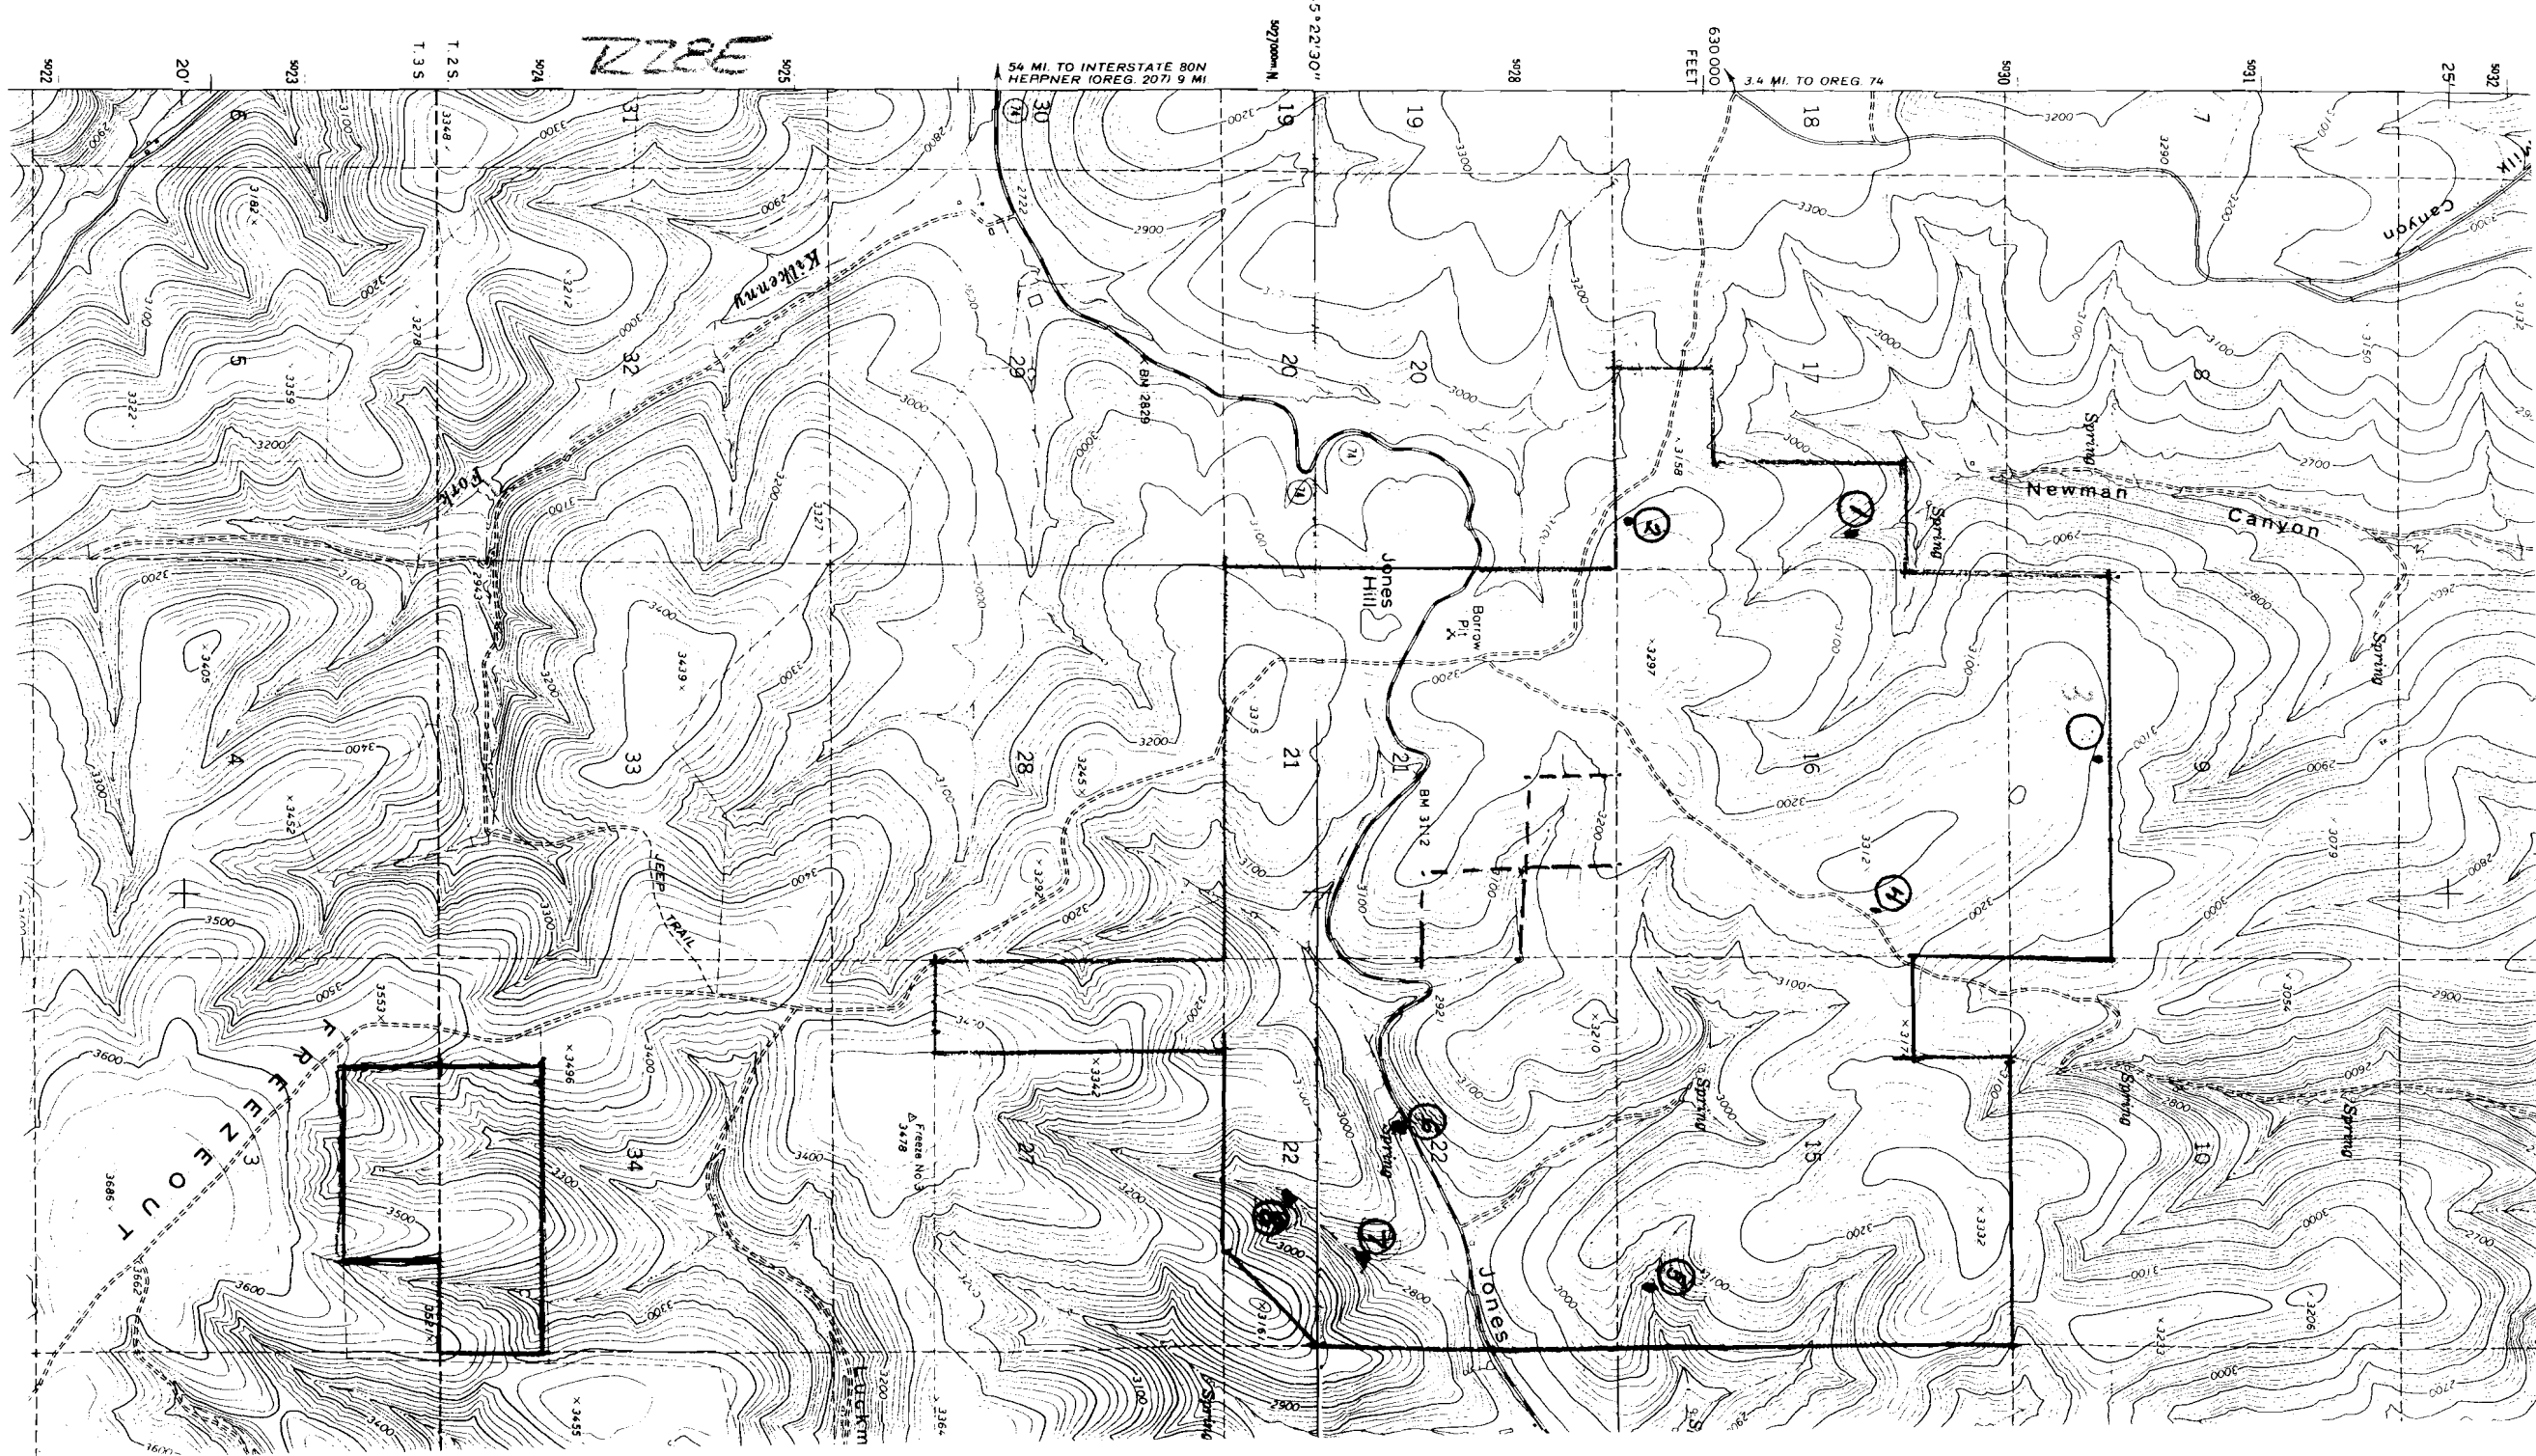

Application No. R-76859
Permit No.

70778

No Final Proof Map available

No Permit Map available