


T. IN. R. 31E. W.M.

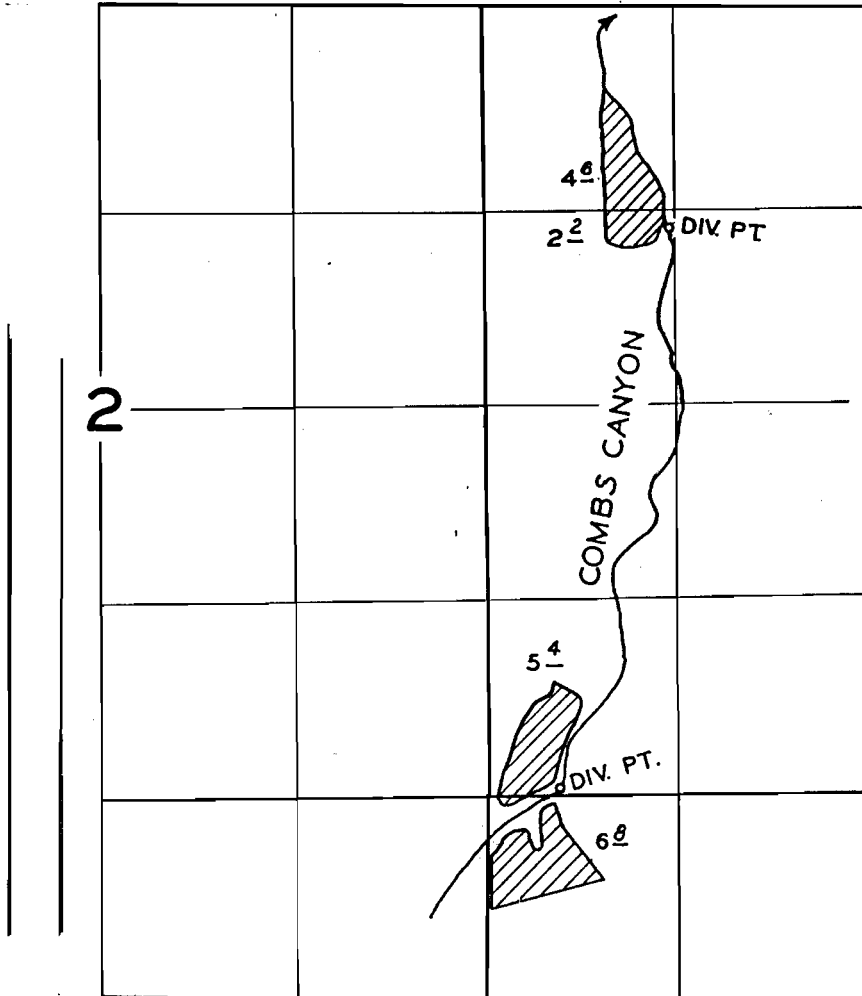

FINAL PROOF SURVEY

UNDER

Application No. 28345 Permit No. 24060
IN NAME OF

LERoy & E.A. BEILKE

Surveyed JULY 18 1960, by E. Jackson

CERTIFICATE NO. 50231