

OUR SOUL ★ OUR STRENGTH

Southern Umatilla


OPERATOR Leslie OWENS
Umatilla Oregon
COUNTY STATE

PHOTO No. NZ-10F-5647 + NZ-9F-198

WOODLAND: 1100

1. Woodland has
All cutting
2. Fire protect
3. Thinning of
- x4. Erosion cont

Application No. ⁵R-77098
Permit No. ³¹⁵

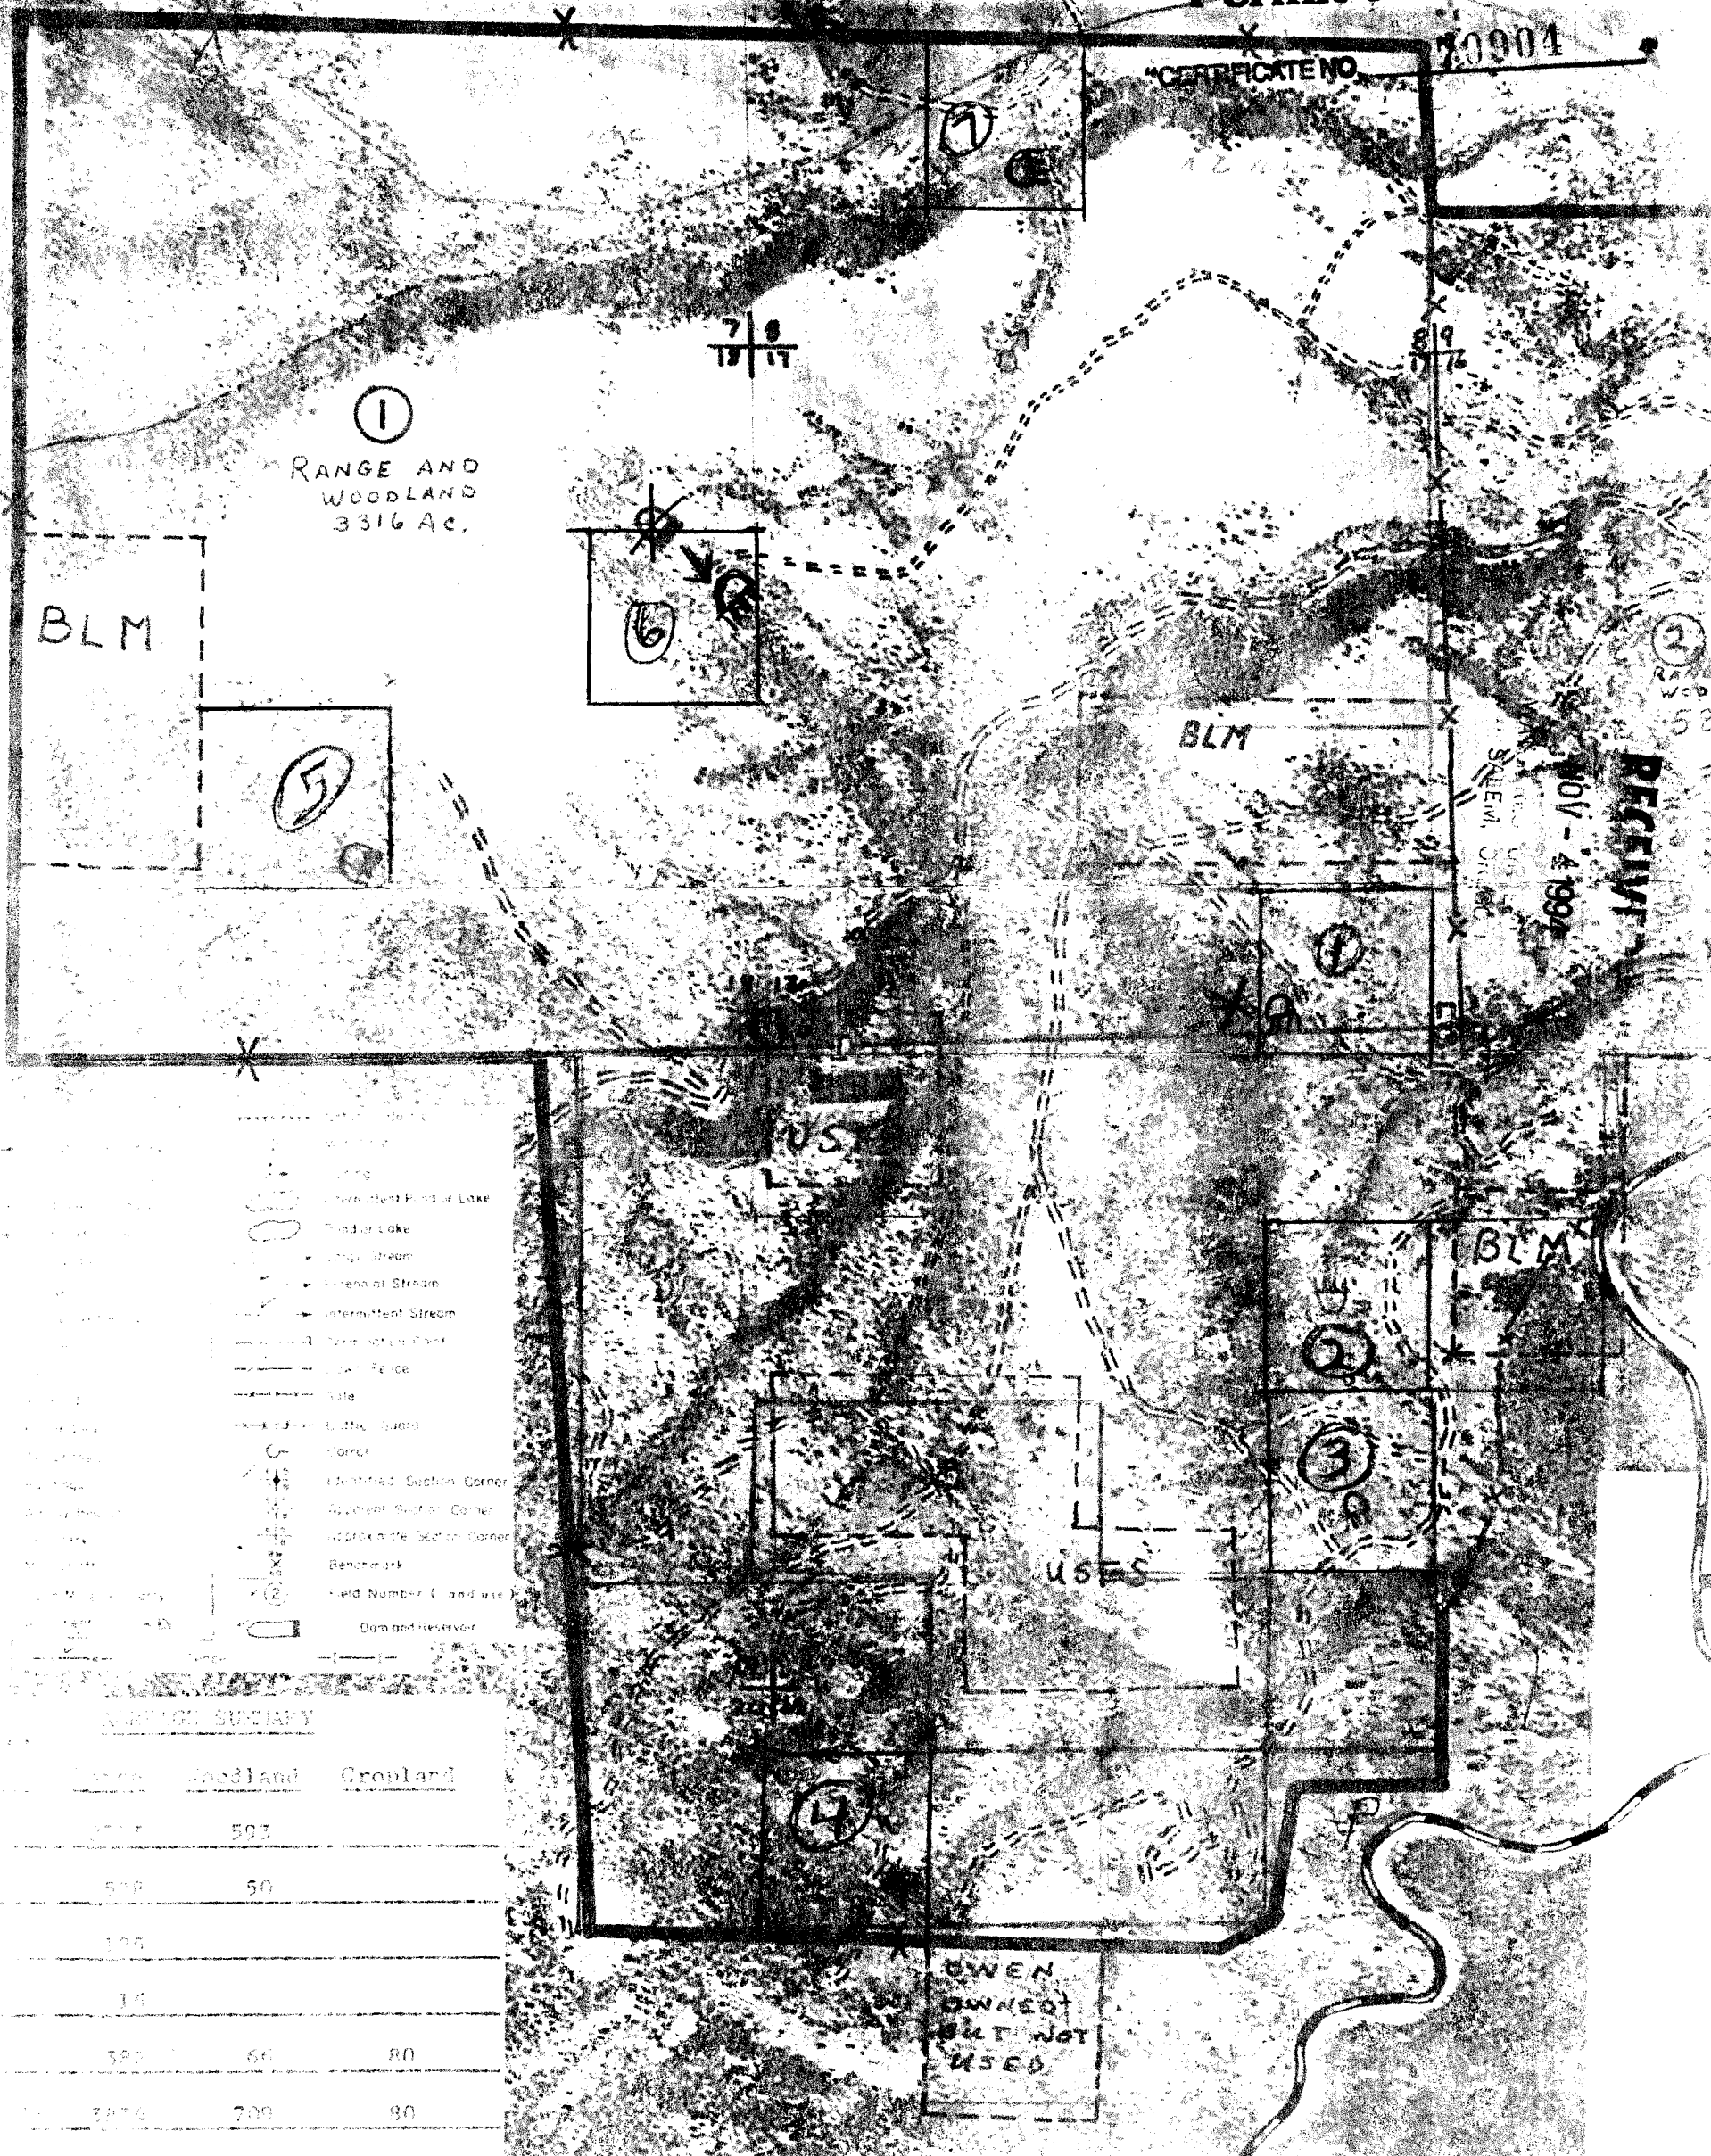

DATE 7/22/63
ACRES 4623
647 + NZ-9F-198

CONSERVATION PLAN

WOODLAND: Fields 1, 2 & 5 - 709 Acres

1. Woodland harvest cutting will be done at least once every ten years. All cutting will be done on a selective basis.
2. Fire protection will be practiced.
3. Thinning will be done to improve rate of growth.
- x4. Erosion control will be practiced by reseeding.
- x5. Slash will be disposed of as a fire protection measure.

RECEIVED


DEC 23 1994

WATER RESOURCES DEPT.
SALEM, OREGON

Application No. R-77098
Permit No.

70904

"CERTIFICATE NO."

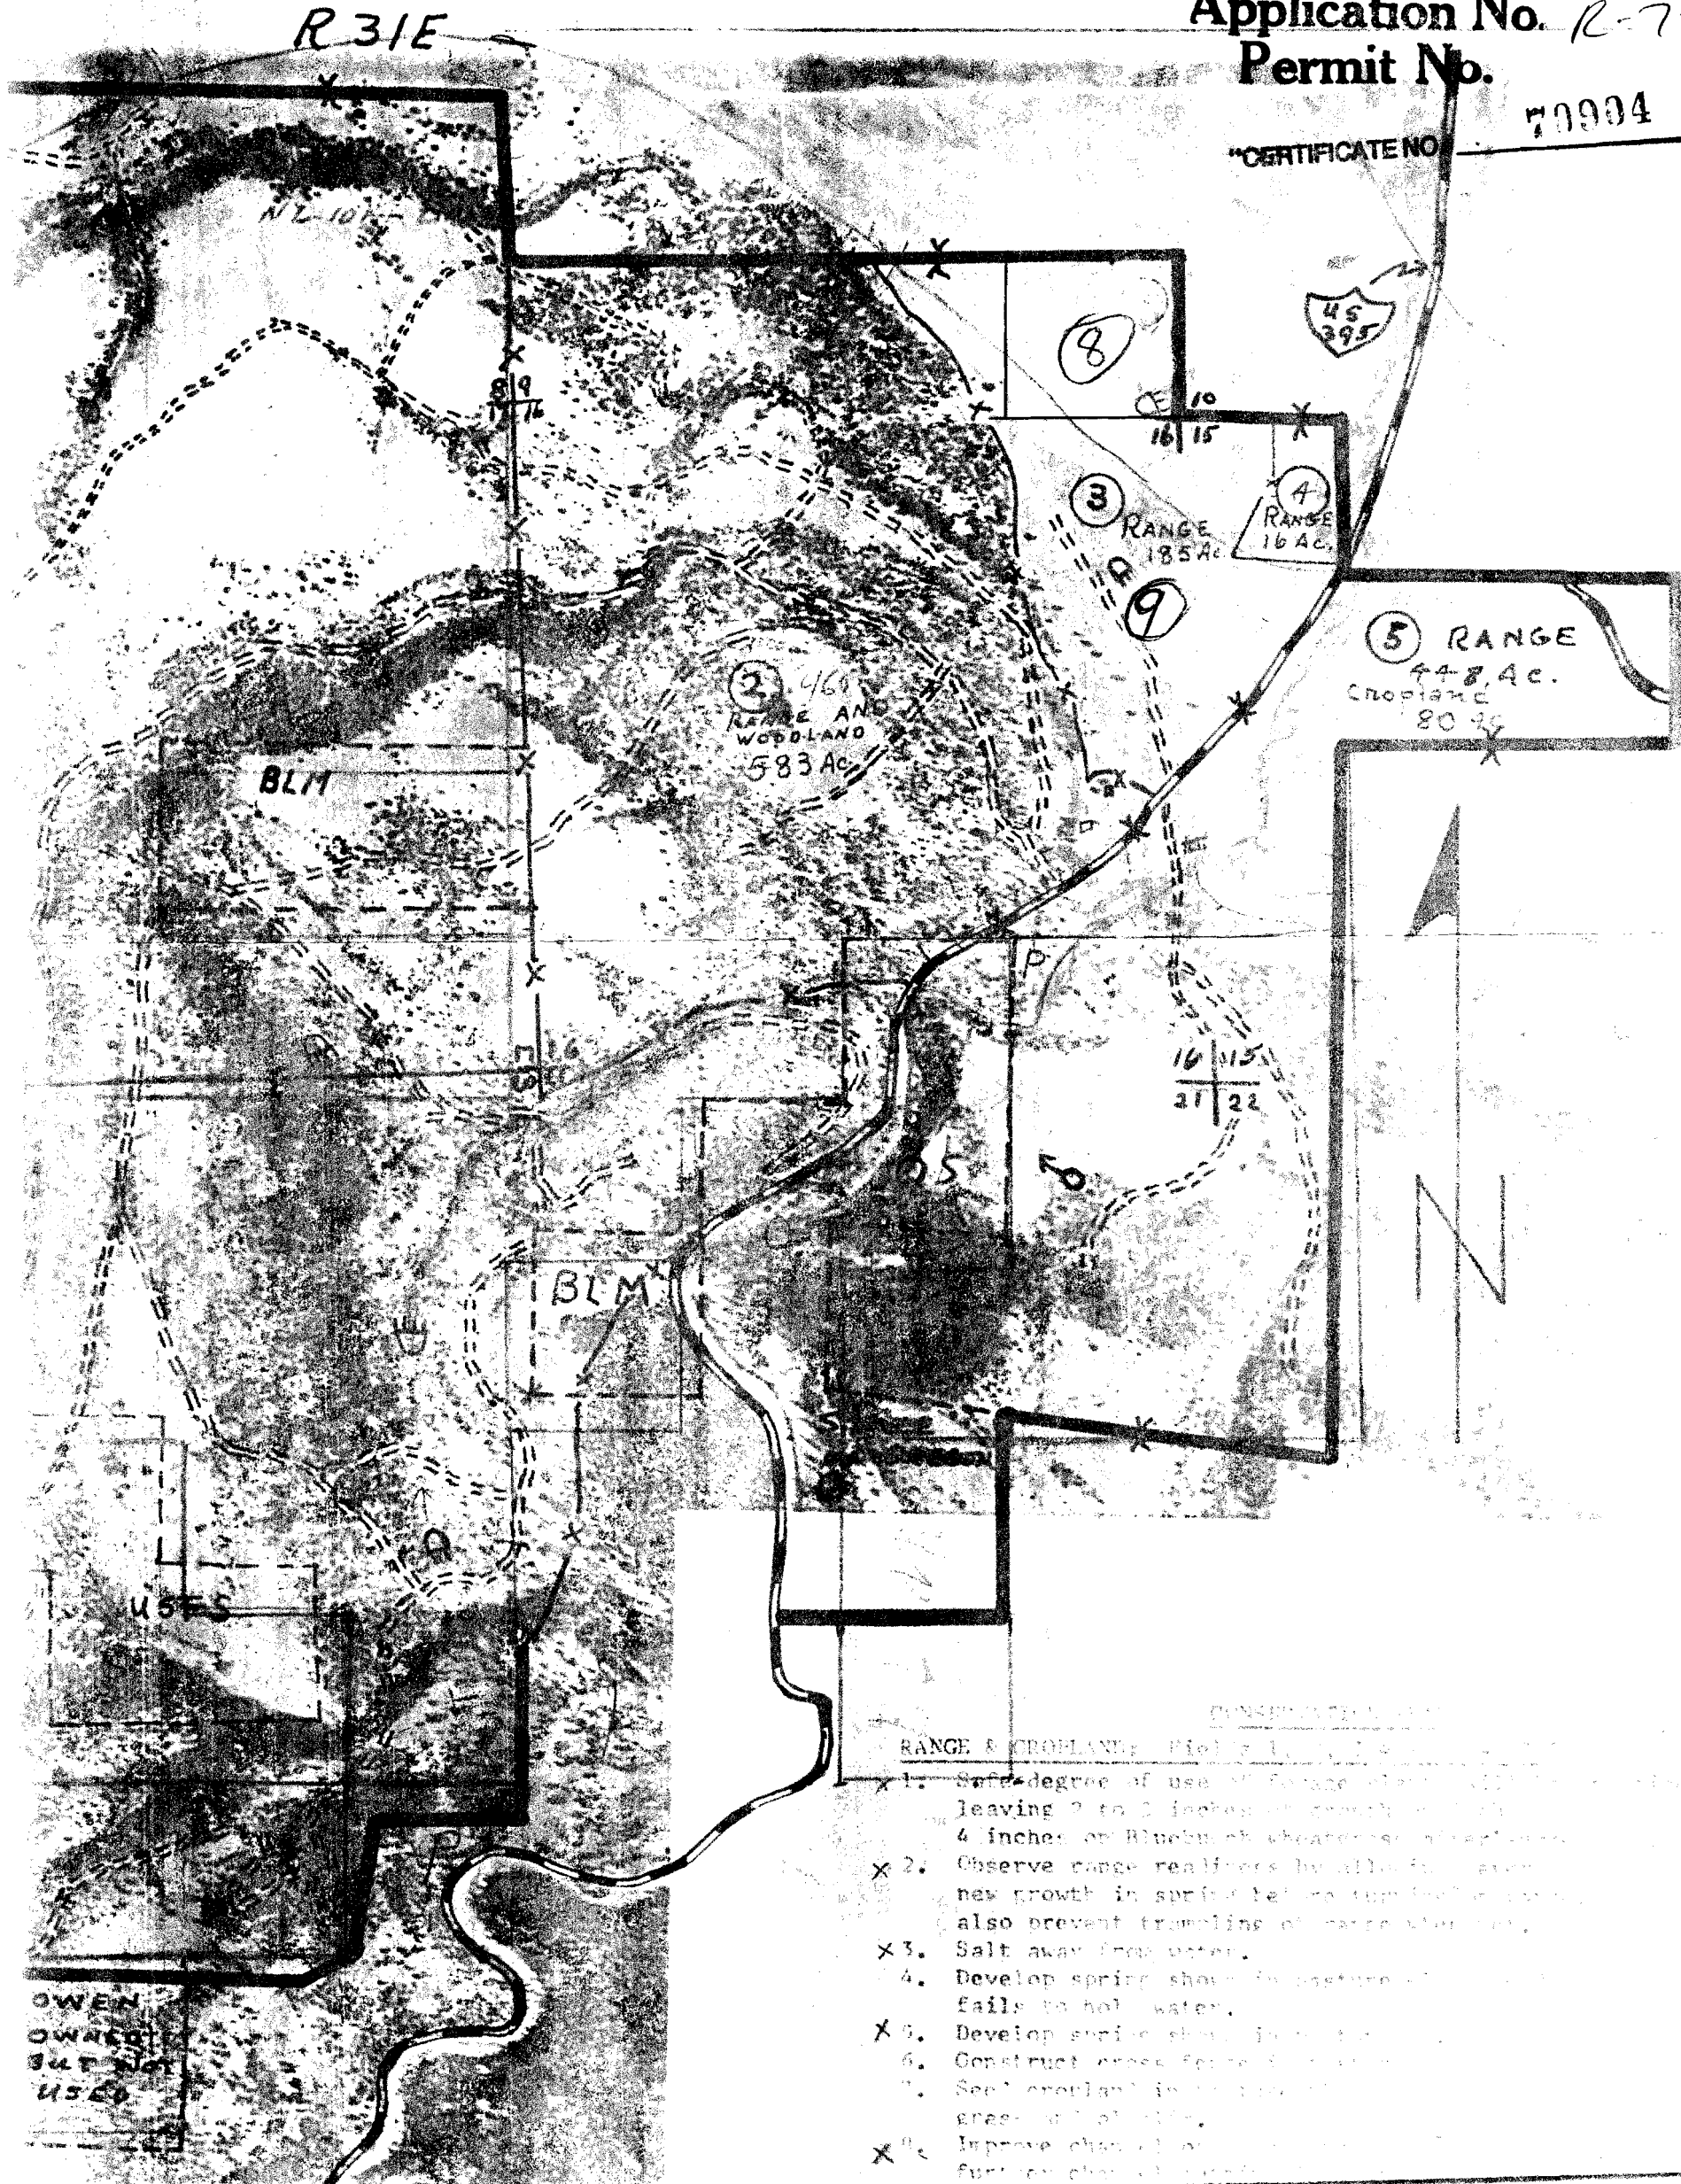

NOV - 4 1994
WATER RESOURCES DEPT.
SALEM, OREGON

CONSERVATION PLAN

RANGE & CROPLAND: Fields 1, 2, 100

- x1. Safe degree of use of range land will be maintained leaving 2 to 3 inches of growth in spring.
- x2. Observe range realifers by allowing new growth in spring before turning out cattle. Also prevent trampling of range land.
- x3. Salt away from water.
4. Develop spring shown in pasture if fails to hold water.

OWEN
OWNED
BUT NOT
USED