


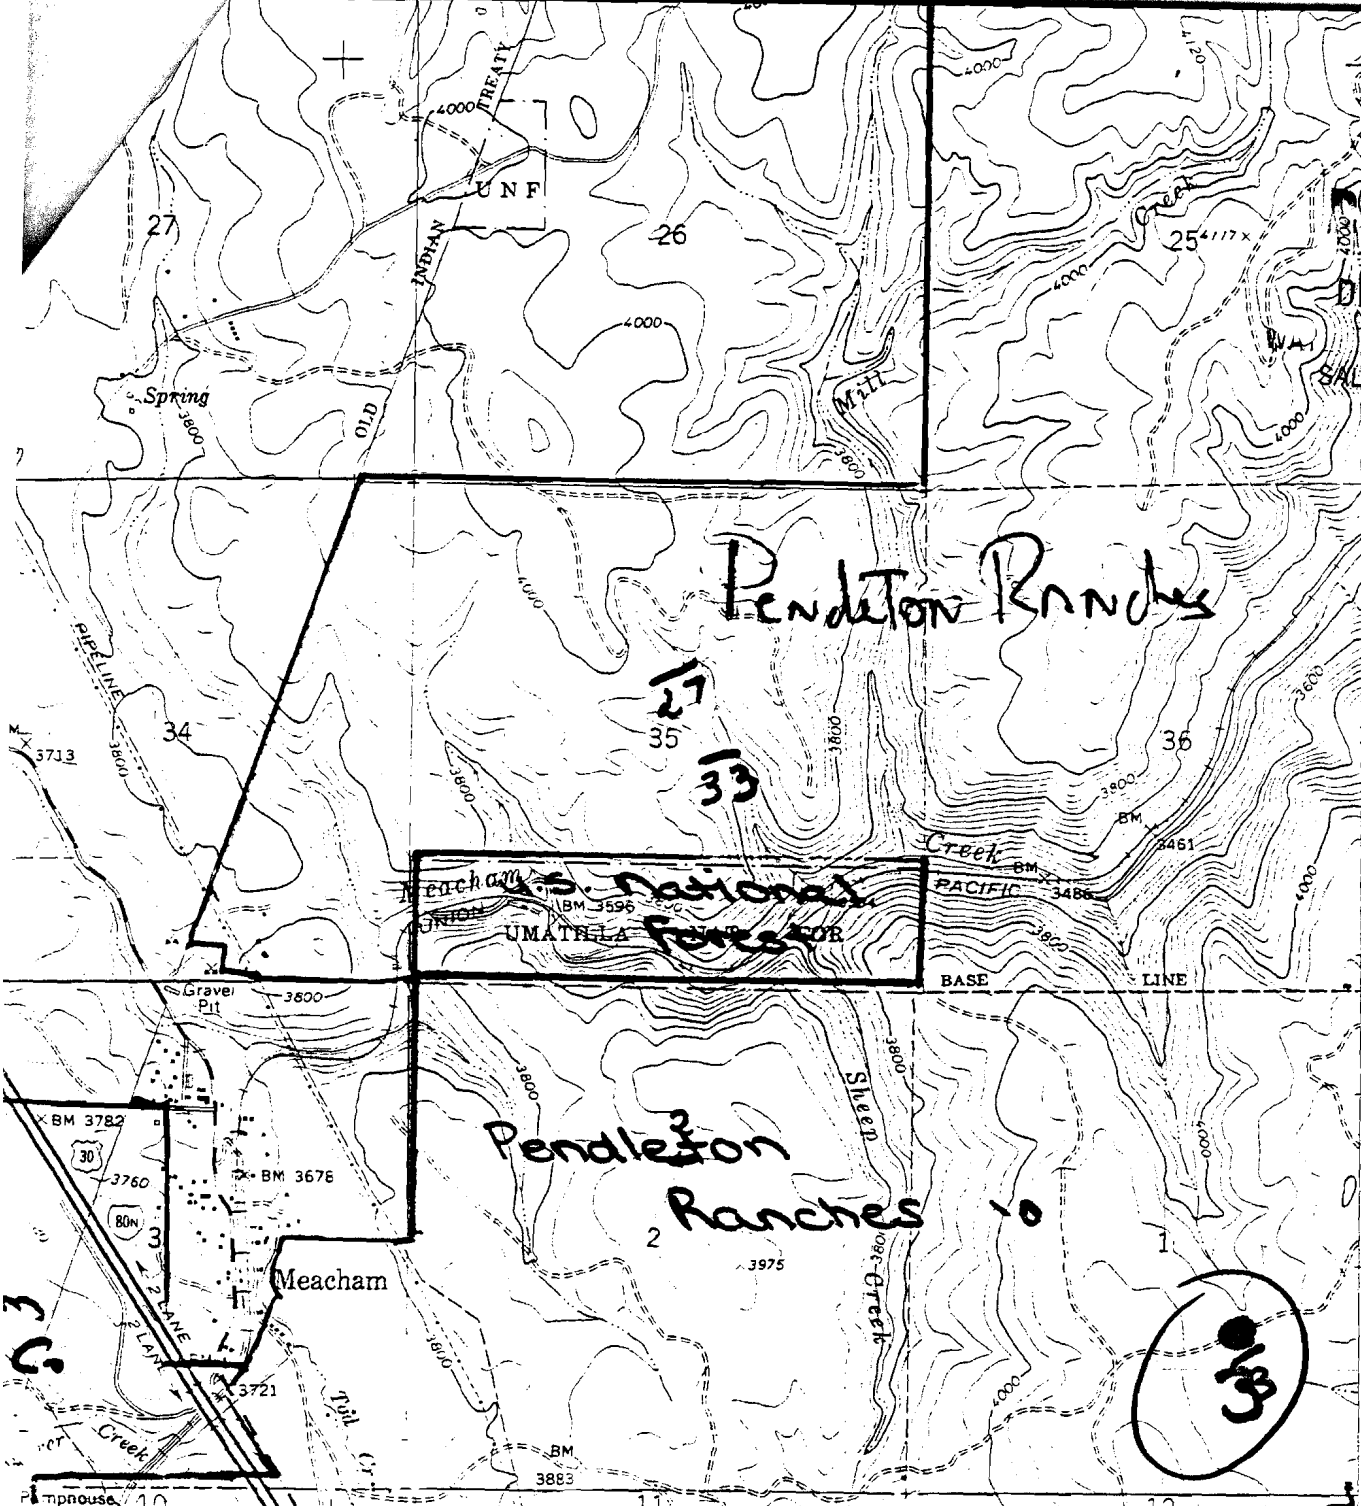

RECEIVED
DEC 30 1994
5043
SALEM, OREGON

Meacham
#3
A

Application No R-77209
Permit No. 77209

CERTIFICATE NO. 77209



ROAD CLASSIFICATION
Heavy-duty _____ Light-duty _____
Medium-duty _____ Unimproved dirt _____
Interstate Route U.S. Route

meacham

MEACHAM, OREG.

4748 E4-TF-024

1964
PHOTOREVISED 1983

DMA 2375 III SW-SERIES V892

STANDARDS
5, OR RESTON, VIRGINIA 22092
AVAILABLE ON REQUEST

Revisions shown in purple and woodland compiled from
aerial photographs taken 1981 and other source data
Partial field check by U. S. Forest Service. Map edited 1983


RECEIVED

DEC 30 1994

SALEM, OREGON

MEACHAM LAKE QUADRANGLE
OREGON
7.5 MINUTE SERIES (TOPOGRAPHIC)

2375 III SE
(DUNFAN)

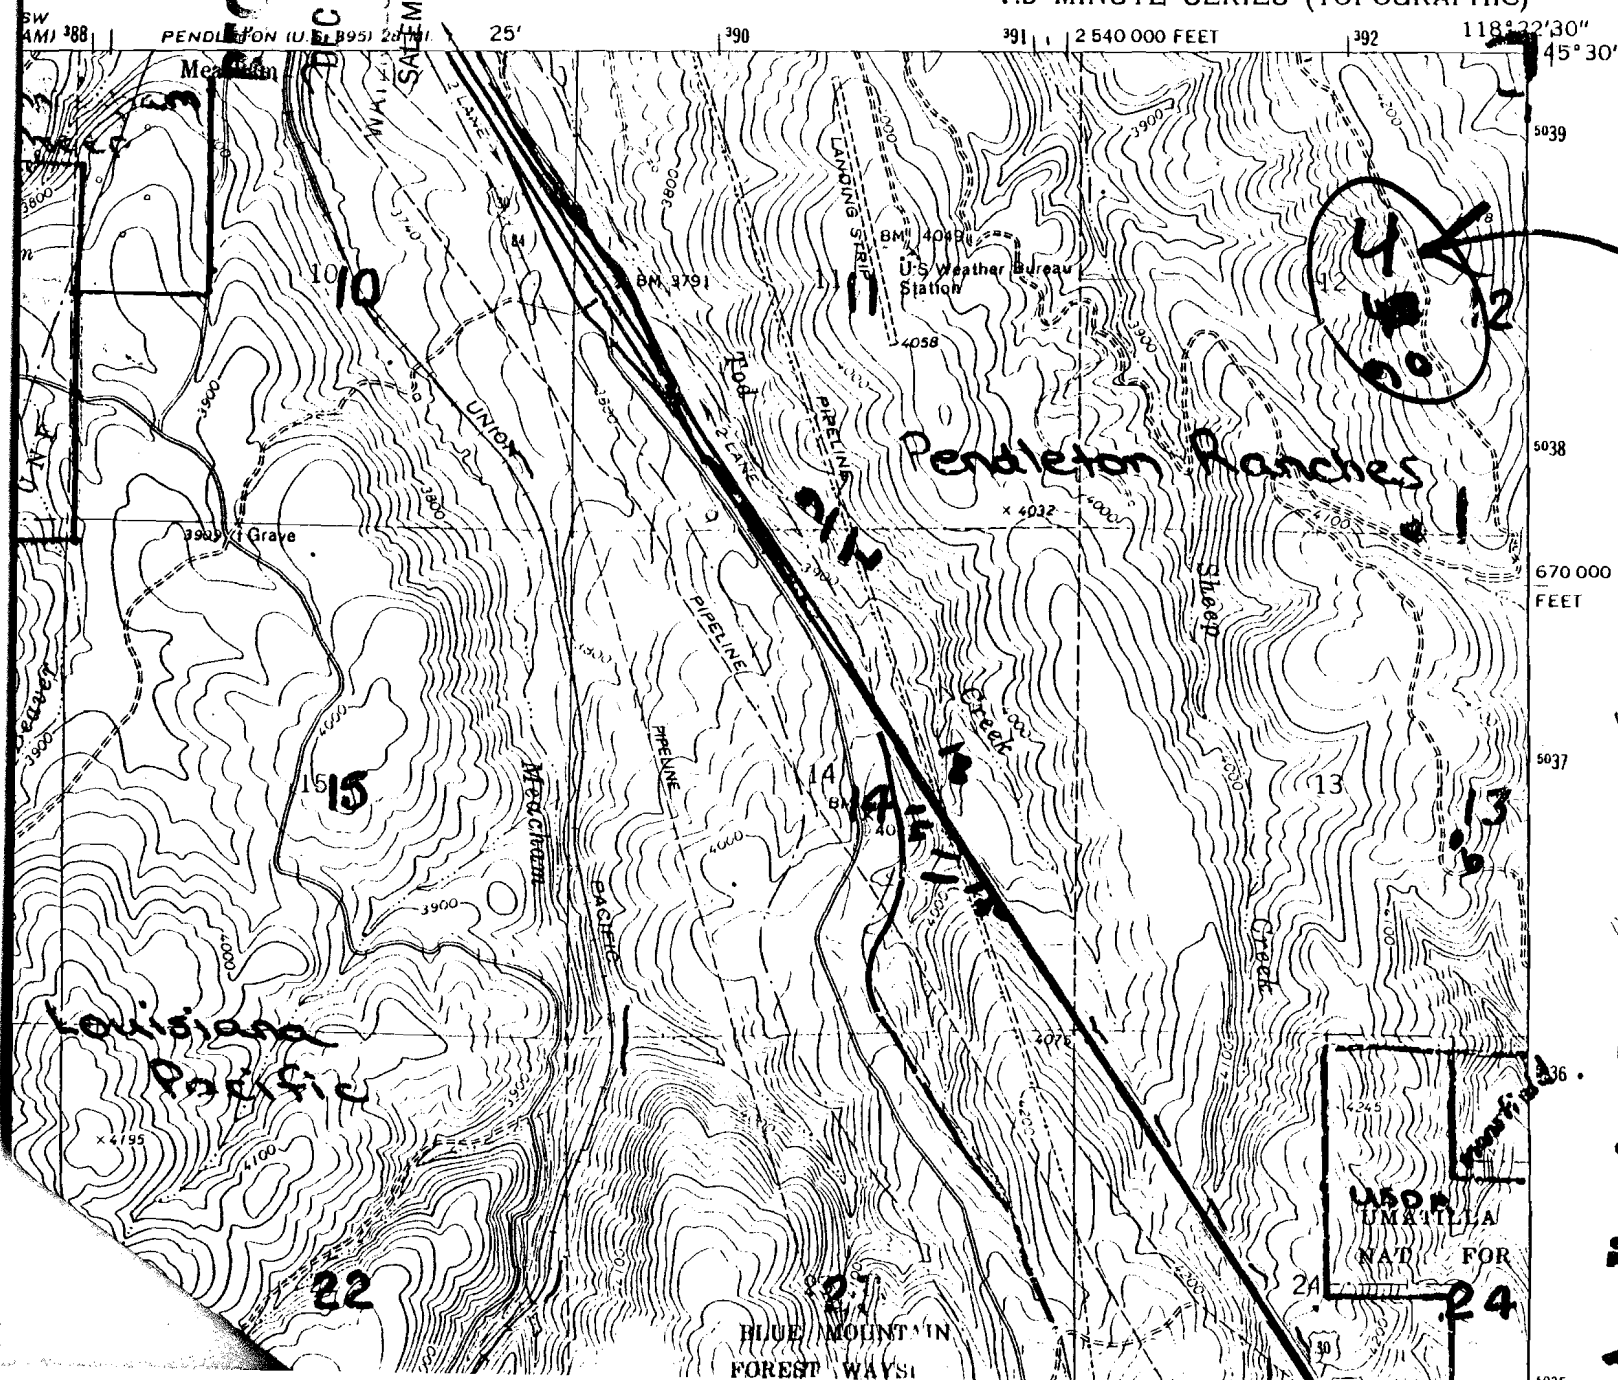

MEACHAM

LAKE

#4

Application No. 8-77209

Permit No.

10010

CERTIFICATE NO.

RECEIVED

DEC 30 1994


SALEM, OREGON

MEACHAM LAKE QUADRANGLE
OREGON
7.5 MINUTE SERIES (TOPOGRAPHIC)

2375 111 SE
(DUNFAN)

Application No. R-77209
Permit No.


CERTIFICATE NO. 10010

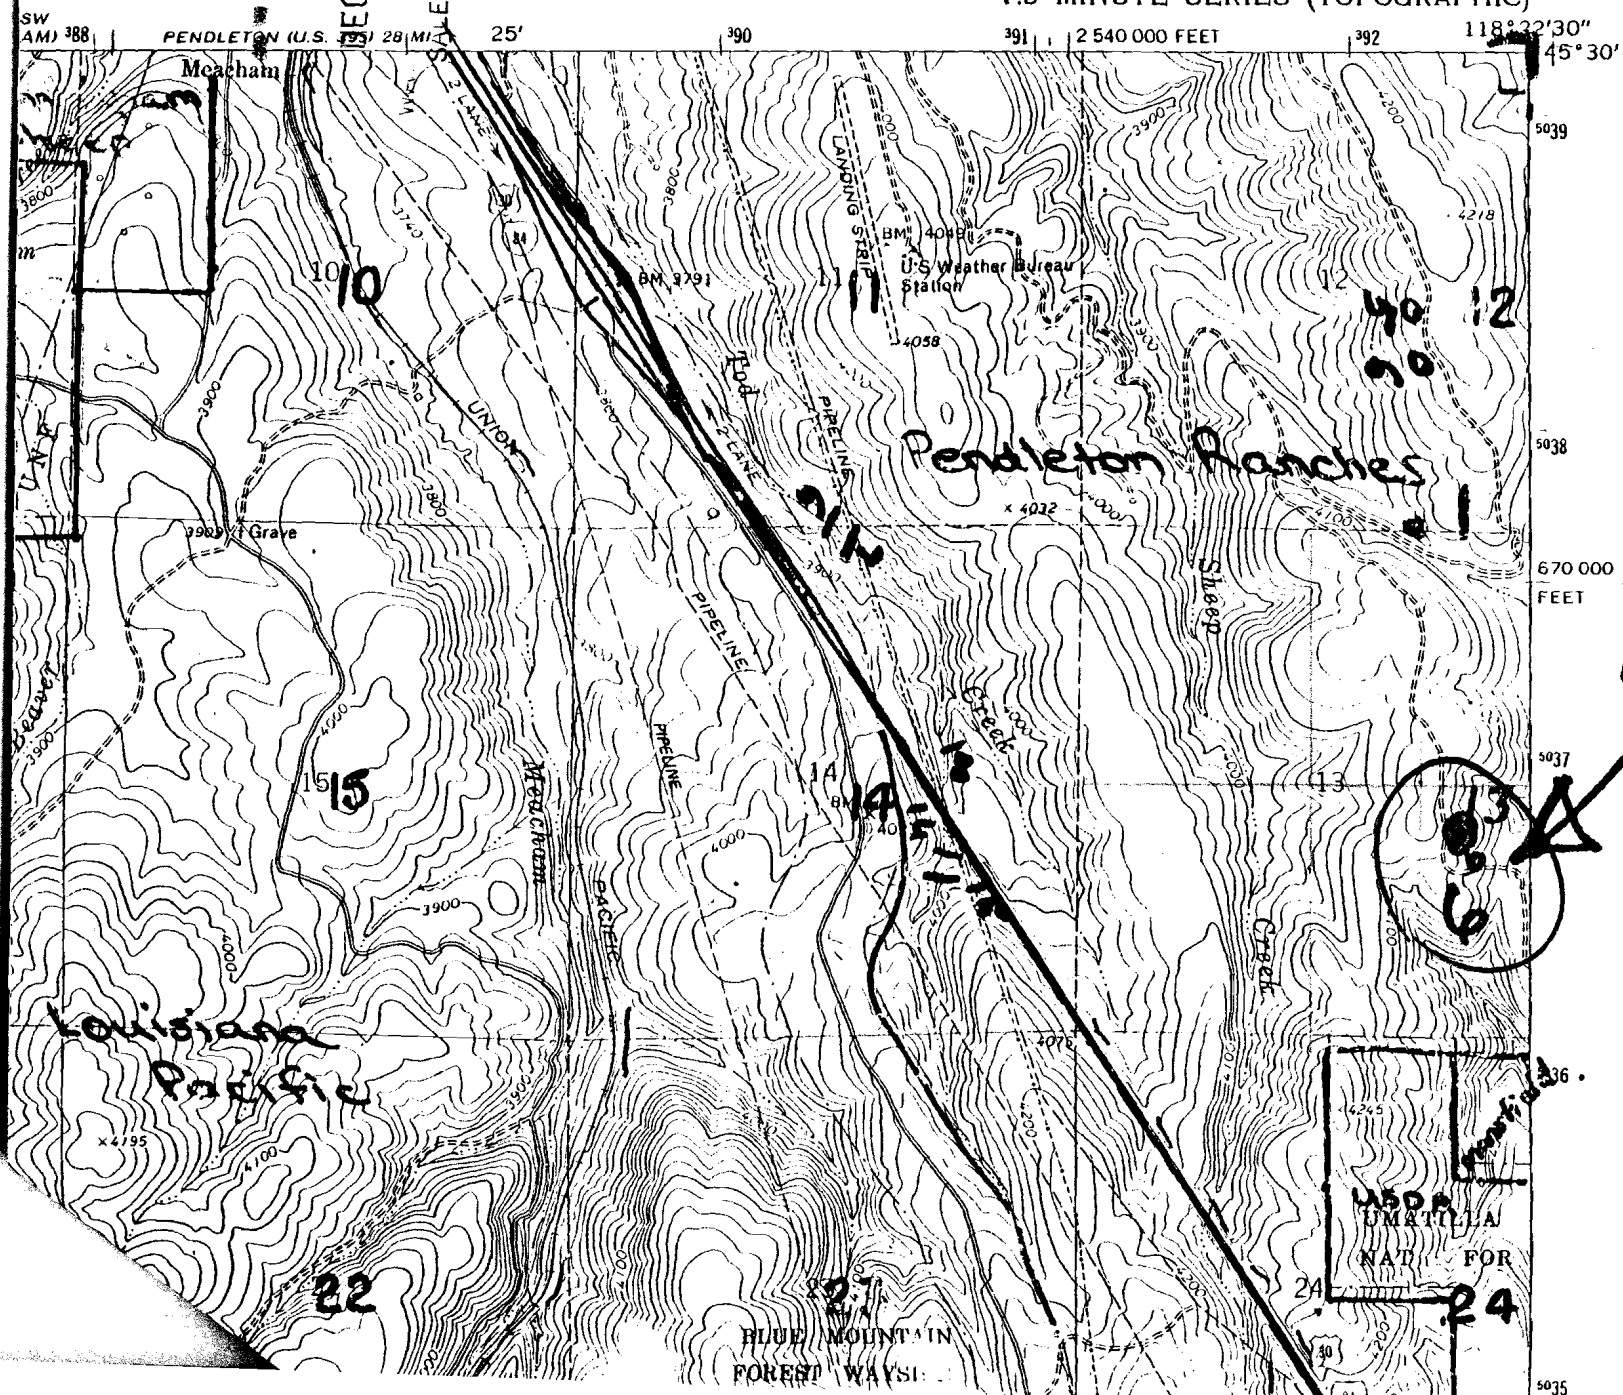

Application No. R-72209
 Permit No.

MEACHAM LAKE QUADRANGLE
 OREGON
 7.5 MINUTE SERIES (TOPOGRAPHIC)

2375 III SE
 (DUNDAN)

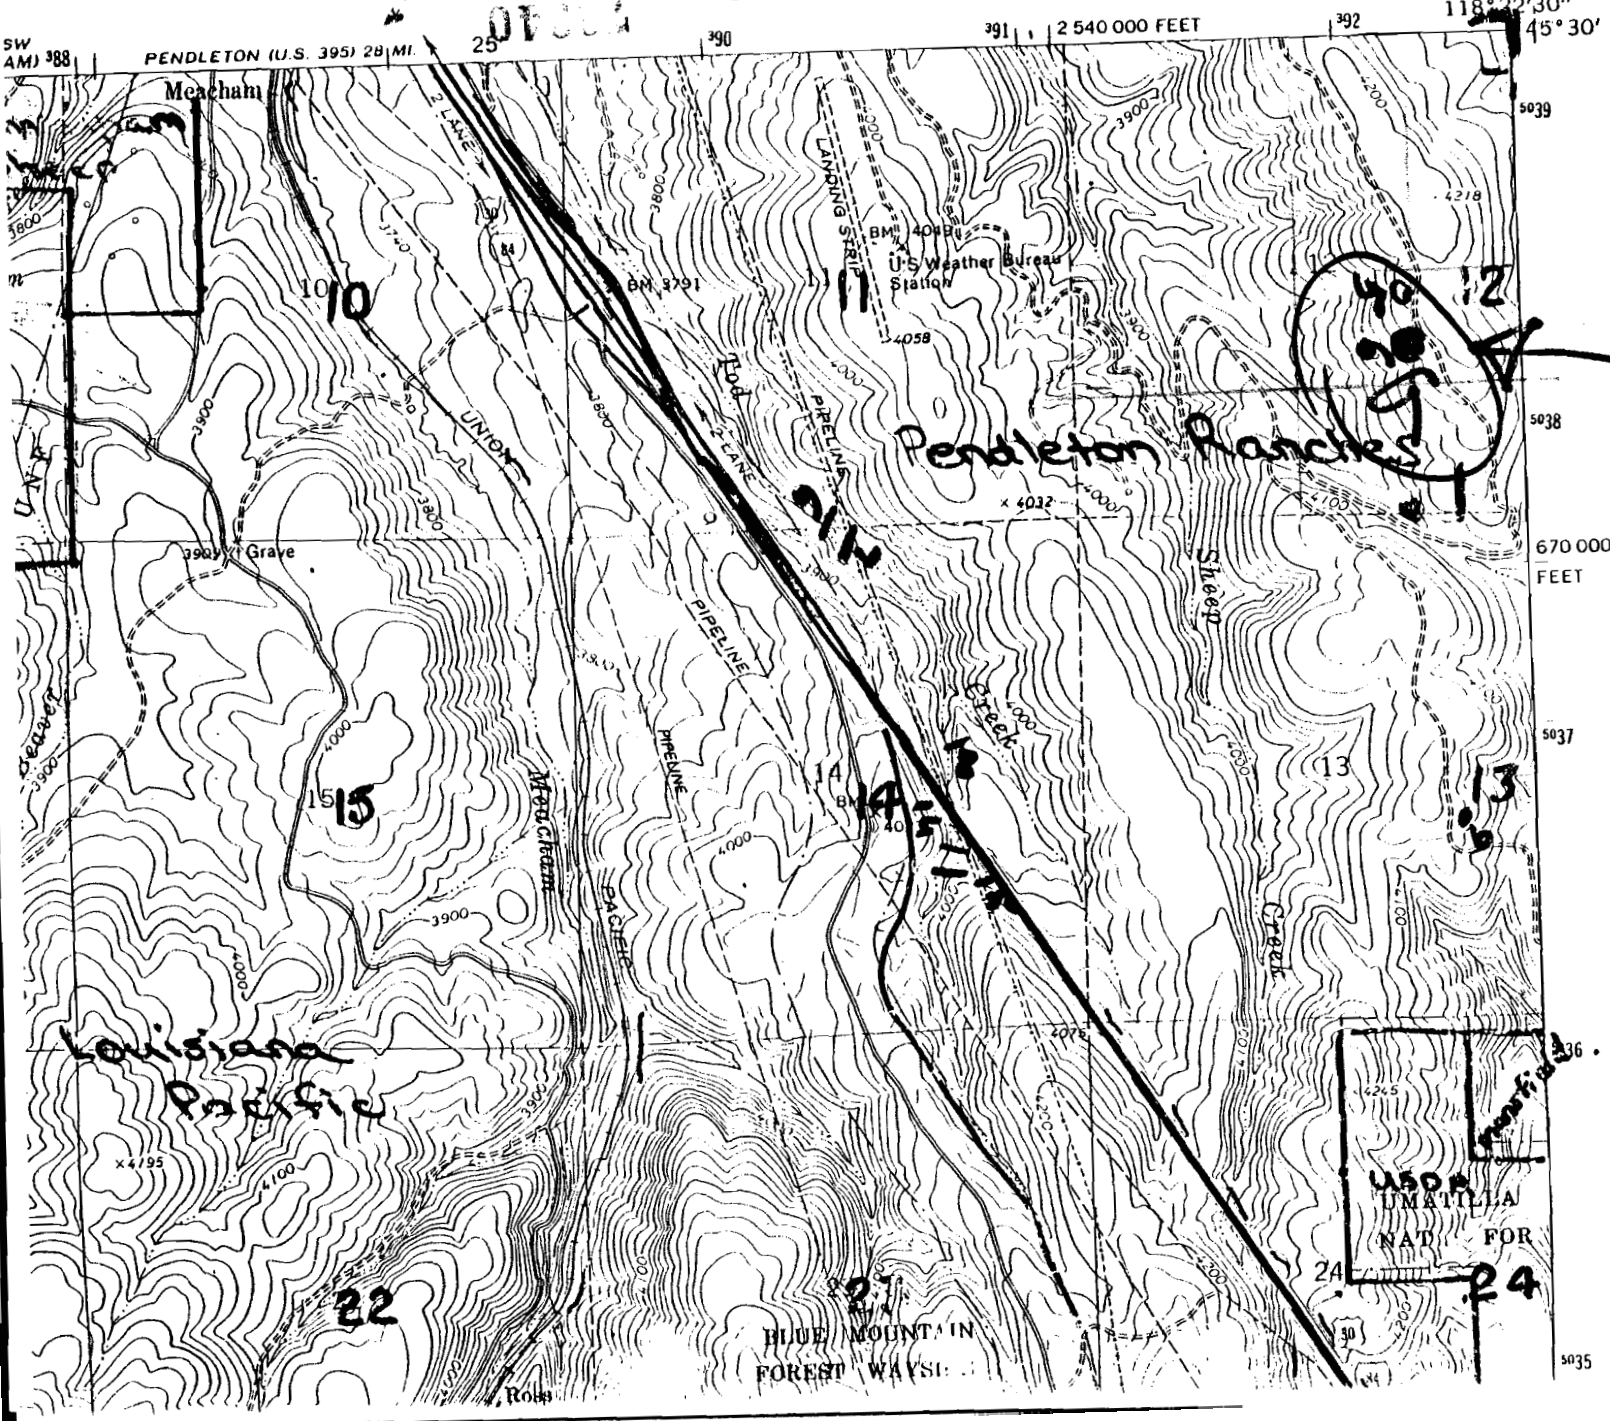

DEC 30 1994
 SALEM, OREGON

Application No. K-77209
Permit No.

CERTIFICATE NO. 100310


Menchem

#24

RECEIVED

DEC 30 1934

SALEM, OREGON

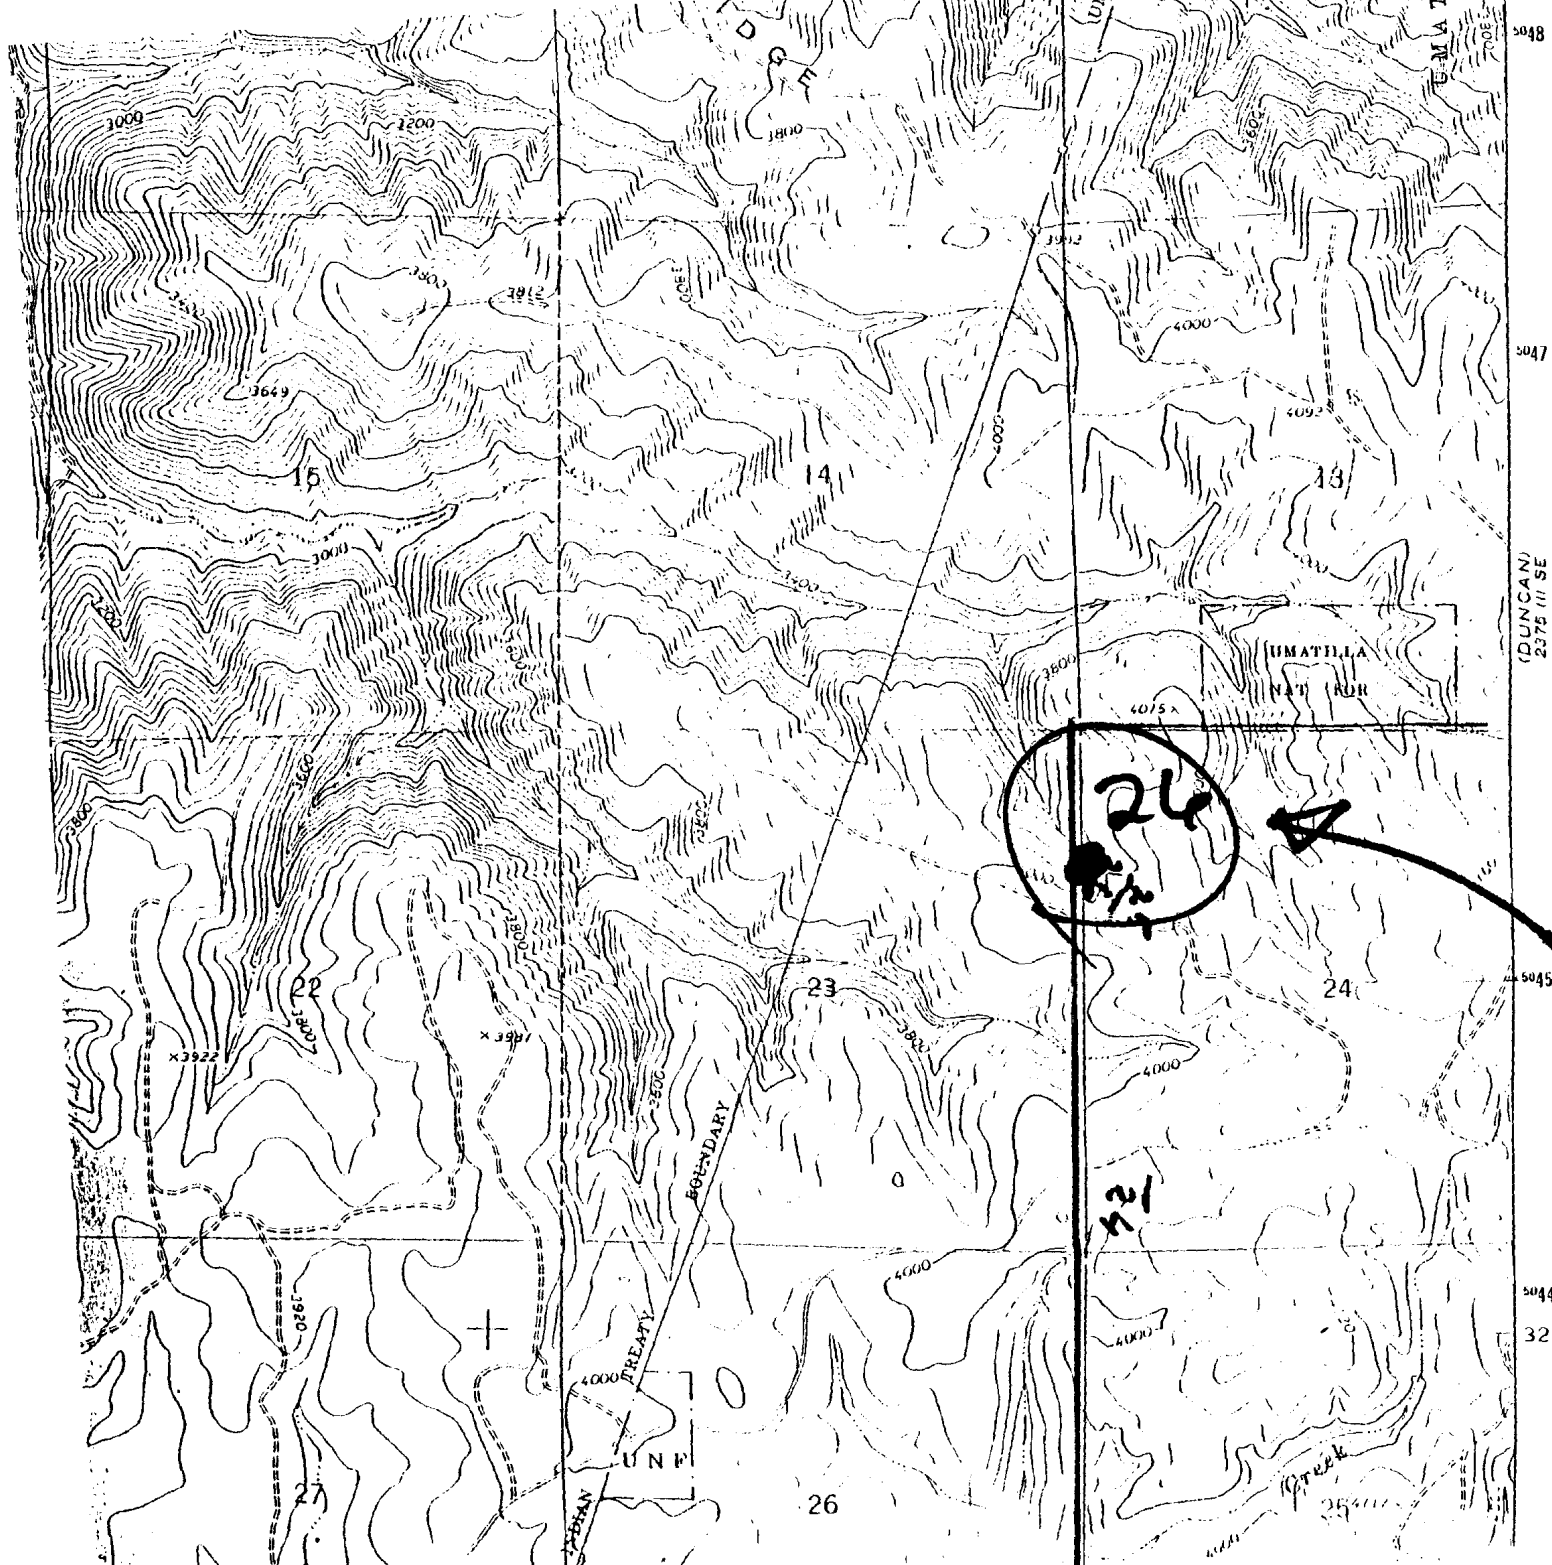

RECEIVED

DEC 30 1994

SALEM, OREGON


Meachem
33

Application No. R-772209
Permit No.

CERTIFICATE No.

10010

(HURON)
234 IV NE

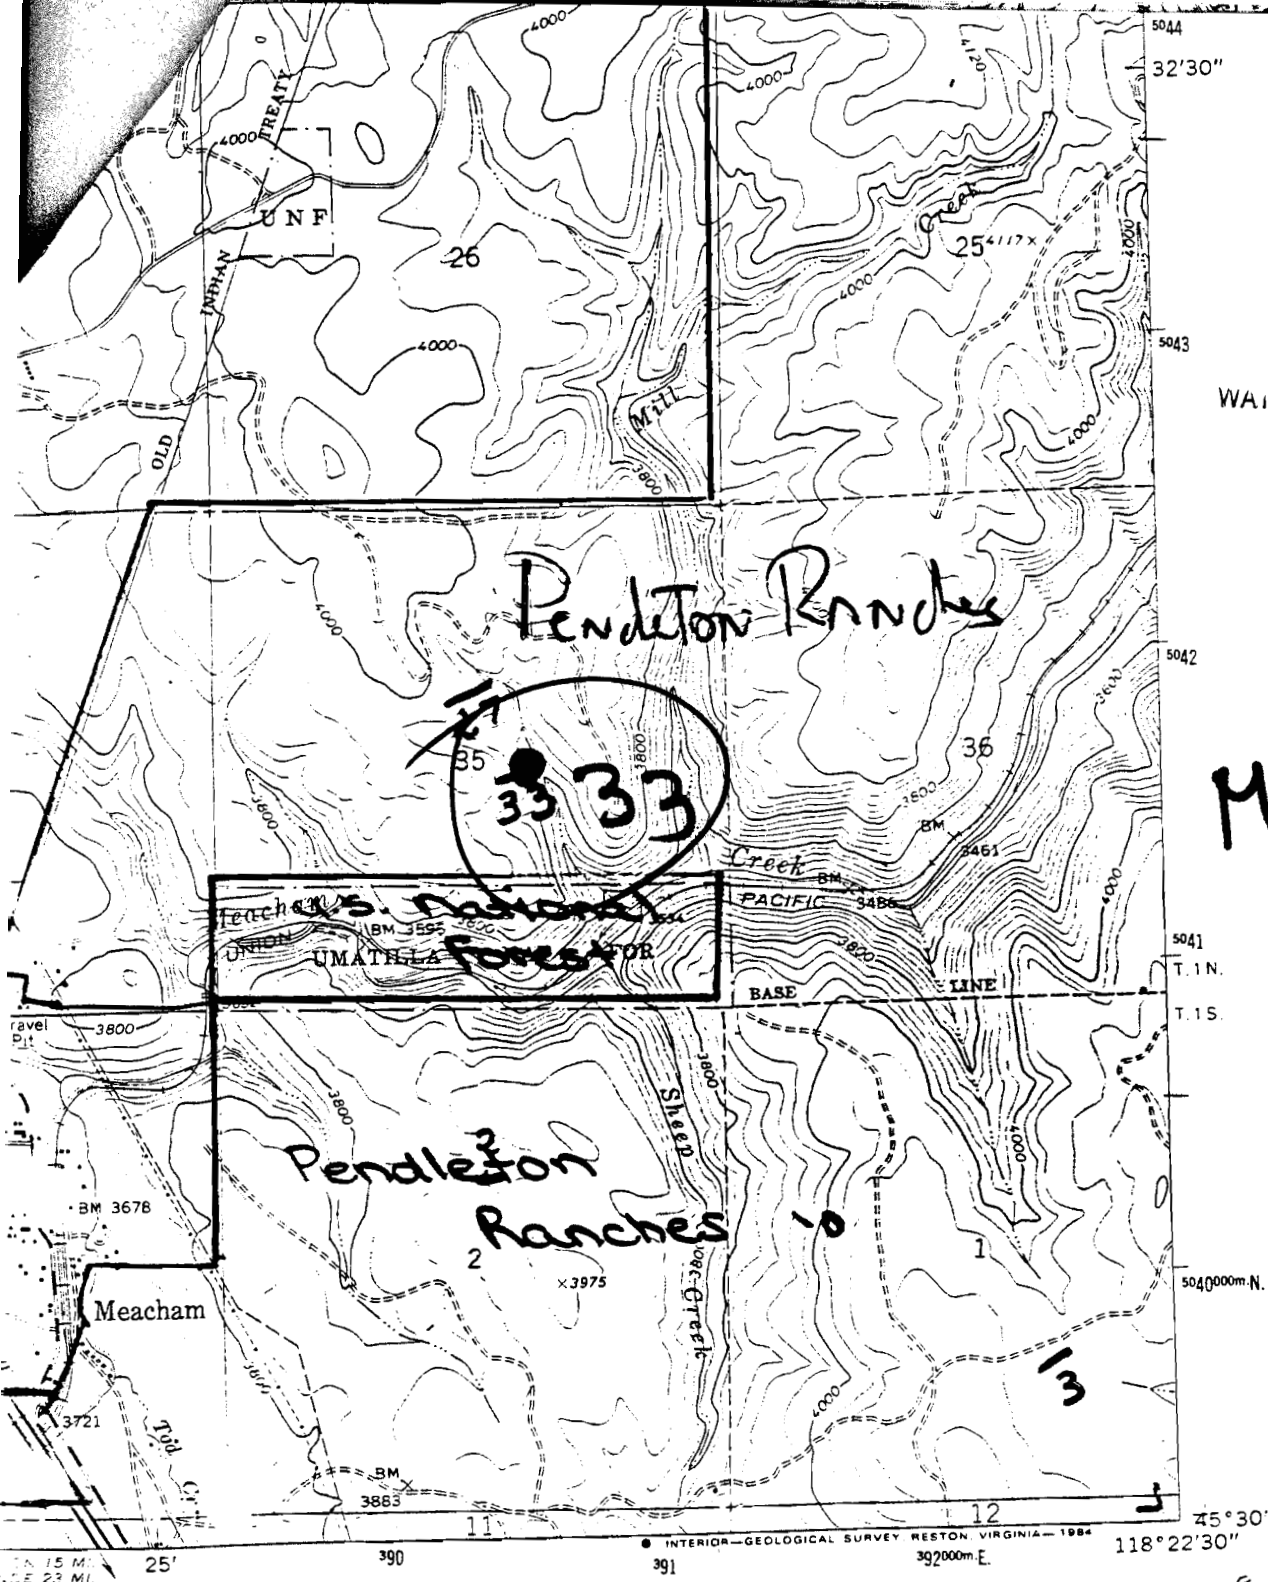

ROAD CLASSIFICATION

Heavy-duty Light-duty
Medium-duty Unimproved dirt

Interstate Route U. S. Route

meachem

MEACHAM, OREG.

7118-E4-TF-024

1964

PHOTOREVISED 1983

DMA 2375 III SW-SERIES V892



QUADRANGLE LOCATION

Revisions shown in purple and woodland compiled from
aerial photographs taken 1981 and other source data
Partial field check by U. S. Forest Service. Map edited 1983

VIRGINIA 22092
QUEST